IREDELL COUNTY HEALTH DEPARTMENT

STATESVILLE 704-878-5305 MOORESVILLE 704-664-5281

IMPROVEMENT PERMIT / AUTHORIZATION TO CONSTRUCT / OPERATION PERMIT / EXISTING SYSTEM INSPECTION

PERMIT # 162240 PIN # 4665-32-9908 DATE 7-1-10

OWNER or APPLICANT CHARLOTTE ISENHOUR PHONE: Business 704-528-7960 Home: ERIC WARD

OWNER or APPLICANT ADDRESS 146 ASHLEY WOODS DR

LOCATION / DIRECTIONS SHEARERS, TR ASHLEY WOODS, 146

SUBDIVISION ASHLEY WOODS BLOCK / SECTION LOT # 7 LOT AREA DESIGN FLOW 360 GPD L.T.A.R. .3

Septic Tank EX 1000 Gallons: STB Date

Pump Tank Gallons: P T Date

Pump Make Model Serial #

Nitrification Field No Fields 1 No Lines 5 Linear Feet 300'

Trench Width 36" Max. Trench Bottom Depth 36" Gravel Depth 25%

☐ New System ☐ Repair ☐ Expansion System Type I (II) III IV V VI

System Description: GRAVITY 25% REDUCTION

Repair System Description: GRAVITY PANEL BLOCK

Maintenance Agreement Required ☐ YES ☒ NO

☒ GRAVITY ☐ PRESSURE


☒ Residence No. Bedrooms 3 ☐ Business No. Persons ☐ Other No. Employees ☐ Slab ☒ Crawl Space ☐ Basement w/plumbing ☐ Basement w/o plumbing

Water Supply: ☐ Private ☒ Public ☐ Community

Comments / Conditions

251


INITIAL SITE SKETCH

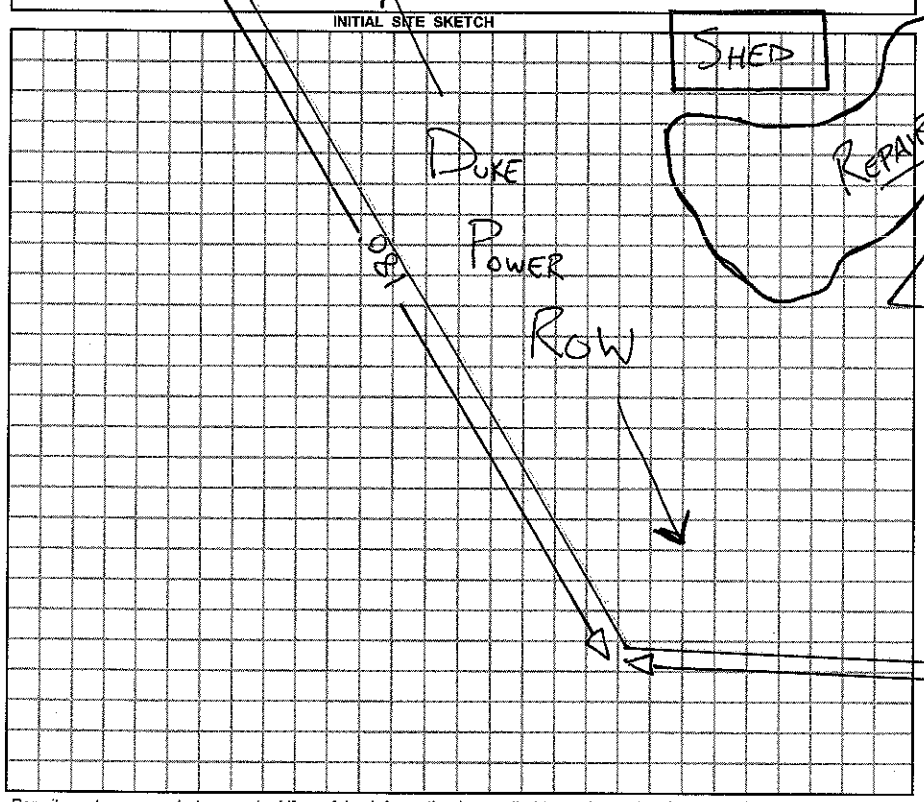

Comments / Conditions

1) 28' X 76' HOME TO REPLACE BURNED HOME
2) NO BUILDINGS WITHIN DRAIN FIELD

AS BUILT SKETCH

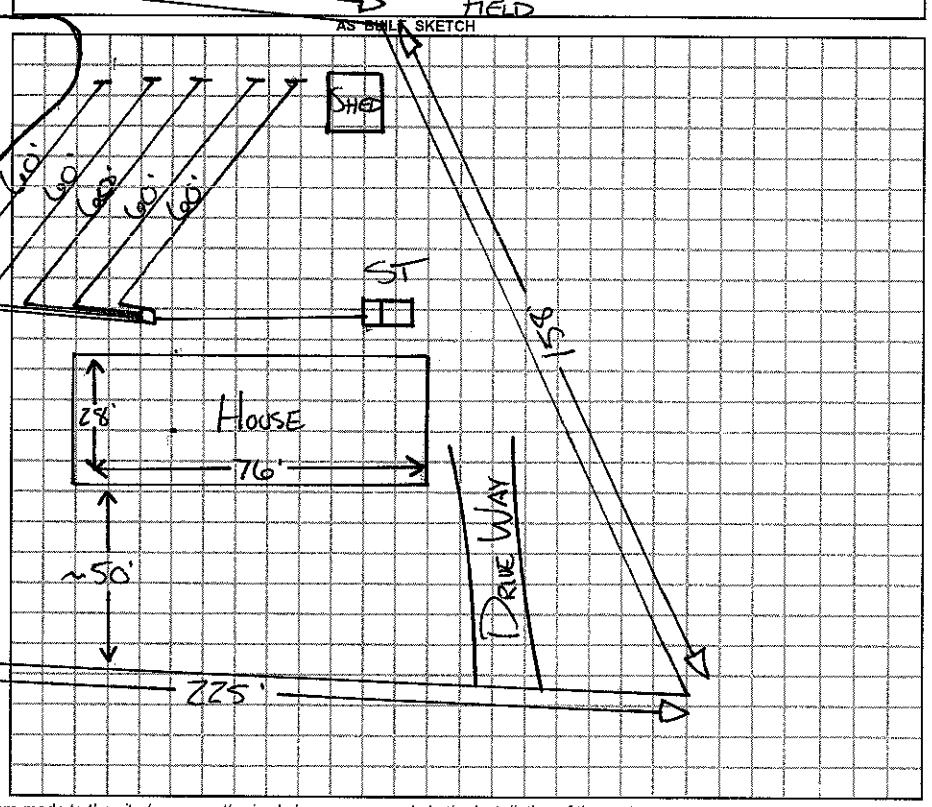

Permit can be suspended or revoked if any false information is supplied toward securing the permit / any unauthorized changes are made to the site / any unauthorized changes are made in the installation of the system.

☐ *IMPROVEMENT PERMIT w / plat valid without expiration.* ☐ *IMPROVEMENT PERMIT w / site plan valid for 60 mos.* ☐ *AUTHORIZATION TO CONSTRUCT valid for period equal to IMPROVEMENT PERMIT-not to exceed 60 mo.*

Owner / Applicant Signature: Eric M. Ward Date 7-2-10

Improvement Permit by: Date

Authorization to Construct by: Date

YOU SHOULD CONTACT A LOCATOR SERVICE PRIOR TO ANY EXCAVATION.

Installed by:

Operation Permit by: Date:

Existing System Inspected by: REHS Date: 7-2-10

WHITE COPY Environmental Health YELLOW COPY (Final) Owner / Applicant PINK COPY (Initial) Owner / Applicant