IREDELL COUNTY HEALTH DEPARTMENT

Authorization to Construct

STATESVILLE 704-878-5305 MOORESVILLE 704-664-5281

IMPROVEMENT PERMIT / ~~CERTIFICATE OF COMPLETION~~ / OPERATION PERMIT / EXISTING SYSTEM INSPECTION

PROPERTY DESCRIPTION NO. 067424 DATE 8/27/97 TAX MAP NO. ~~4664385745~~ 4665331003 Watershed: ☐ Yes ☒ No

OWNER OR CONTRACTOR James McKnight PHONE: Business 664-9080 Home

ADDRESS 255 Rolling Hills Rd Mooresville, NC. 28115

LOCATION Shearers Rd. TR N Ashley Dr. straight to last lot on (R)

SUBDIVISION Ashley Woods BLOCK / SECTION LOT 12 LOT AREA .660 SITE CLASS. PS DESIGN FLOW 360 L.T.A.R. .3

Septic Tank: 1000 Gallons; STB 1P1012 Date 7-8-97

Pump Tank: Gallons; PT Date

Pump Make: Model Serial No.

Nitrification Field: No Fields 1 Square Feet 1200 Linear Feet 400

No Lines 4 Trench Width 36" Max Trench Bottom Depth 36" Gravel Depth 12"

☒ New System ☐ Repair System Type: I (II) III, IV, V, VI

System Description: CONVENTIONAL

Repair System Description: SAME

Maintenance Agreement Required: ☐ Yes ☒ No

☐ House/Mod. Home No. Bedrooms 3

☒ Mobile Home No. Bathrooms 2

☐ Business No. Employees

☐ Other


☐ Slab ☒ Crawl Space ☐ Basement w/plumbing ☐ Basement wo/plumbing

Water Supply: ☐ Individual ☒ Community ☐ Public


Comments:

Comments: Water line not installed - Must be 10' from septic system

INITIAL SITE SKETCH

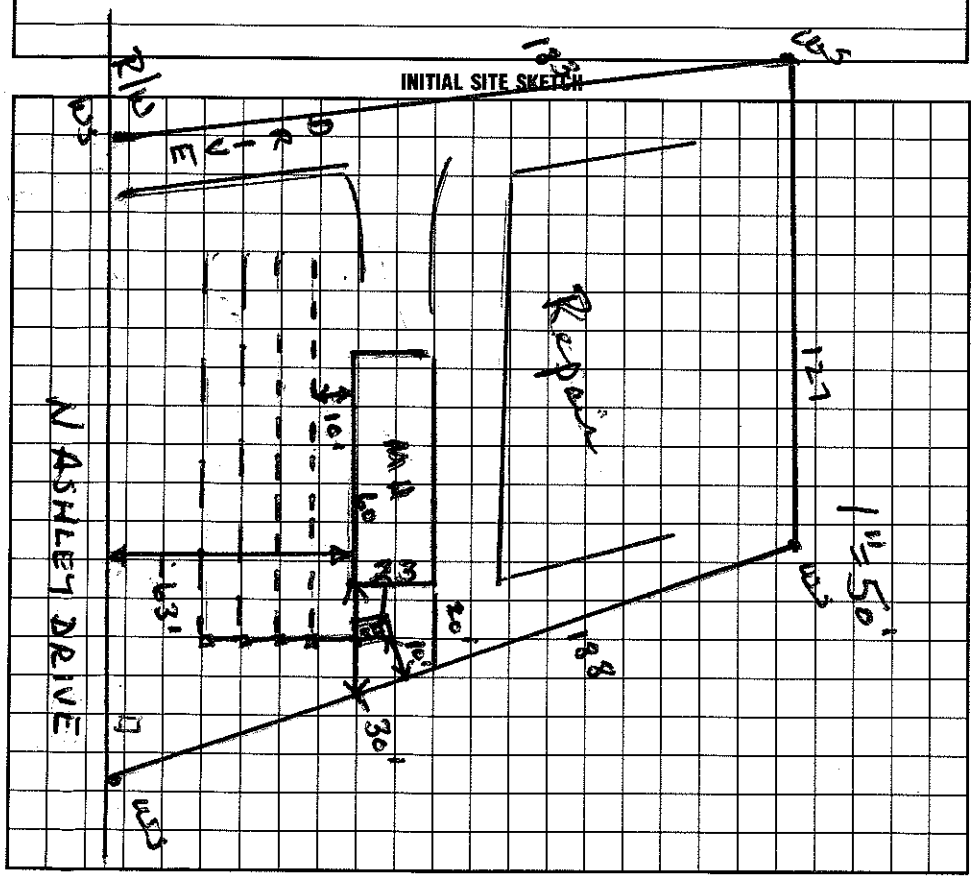

AS BUILT SKETCH

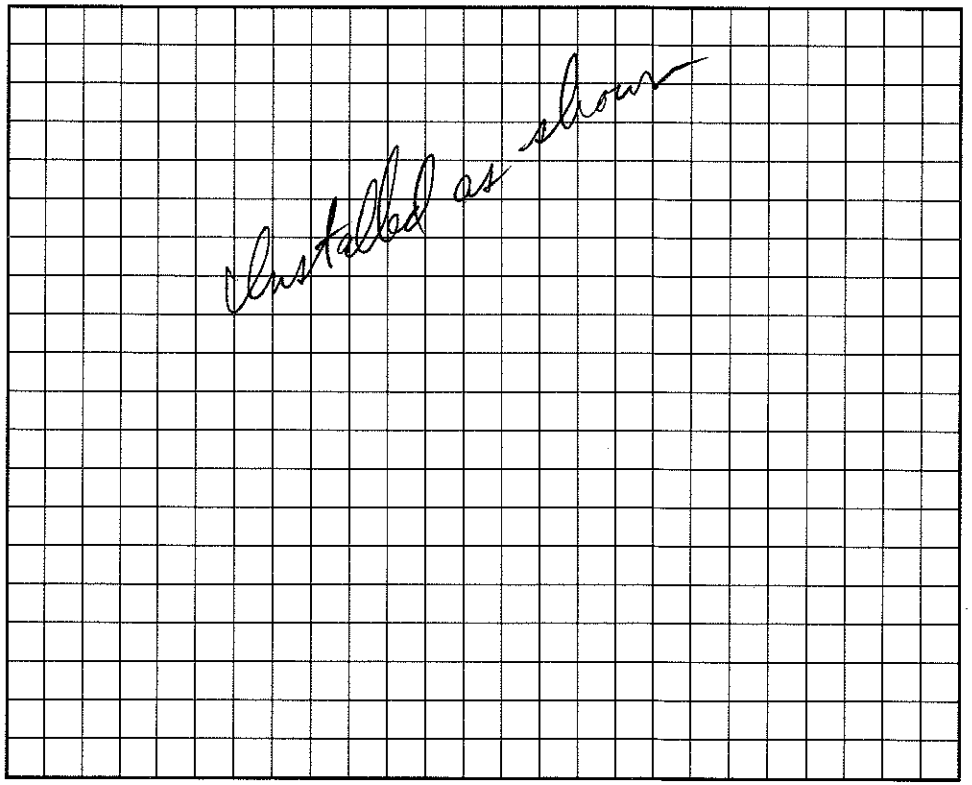

I understand that this permit can be suspended or revoked if any false information is supplied toward securing the permit/any unauthorized changes are made to the site/any unauthorized changes are made in the installation of the system. Improvement Permit is valid for 60 months from date of issuance.

Signed: Dennis Gallihen

Improvement Permit by: Wesley Sparks RS. date 8/27/97

Existing System Inspection by: Wesley Sparks RS date 8/27/97

Installed by: A-1 Backhoe / Dennis Gallihen

Certificate of Completion by: date

Operation Permit by: date 9-3-97

HEALTH DEPT. COPY: WHITE INSPECTION COPY (FINAL): GREEN OWNER COPY (FINAL): YELLOW INSPECTION COPY (INITIAL): PINK OWNER COPY (INITIAL): GOLD