IREDELL COUNTY HEALTH DEPARTMENT

STATESVILLE 704-878-5305 MOORESVILLE 704-664-5281

IMPROVEMENT PERMIT / AUTHORIZATION TO CONSTRUCT / OPERATION PERMIT / EXISTING SYSTEM INSPECTION

PERMIT# 067420 PIN# ~~4660532874542932~~ 33-2043 DATE 6/1/98

OWNER OR CONTRACTOR James McKnight PHONE: Business 664-9080 Home

ADDRESS 255 Rolling Hills J Mooresville, NC 28115

LOCATION Hwy 115 to Shearers Rd on Right past Rocky River before Wildwood Acres

SUBDIVISION Ashley Woods BLOCK / SECTION LOT 11 LOT AREA .51 Acre SITE CLASS. PS DESIGN FLOW 360gpd L.T.A.R. .3

Septic Tank: 1000 Gallons; STB 1012 Date 4/1/98

Pump Tank: Gallons; PT Date

Pump Make: Model Serial No.

Nitrification Field: No Fields 1 Square Feet 1200' Linear Feet 400'

No Lines 5 at 80' Trench Width 36" Max Trench Bottom Depth 24" Gravel Depth 12"

☒ New System ☐ Repair System Type: I (II) III, IV, V, VI

System Description: Gravity - Conventional

Repair System Description: Modified

Maintenance Agreement Required: ☐ Yes ☒ No

☐ House/Mod. Home ☒ Mobile Home ☐ Business ☐ Other

No. Bedrooms 3 No. Bathrooms 2 No. Employees

☐ Slab ☒ Crawl Space ☐ Basement w/plumbing ☐ Basement wo/plumbing


Water Supply: ☐ Individual ☐ Public ☒ Community

Comments:/Conditions: Keep Septic System 10' from PL & 5' from Home


Comments:/Conditions:
MH NOT ON SITE 6/3/98
Deck encroaches over 1st line
~12' x 16' Deck

Scale ~~1:100~~ 1:50

INITIAL SITE SKETCH

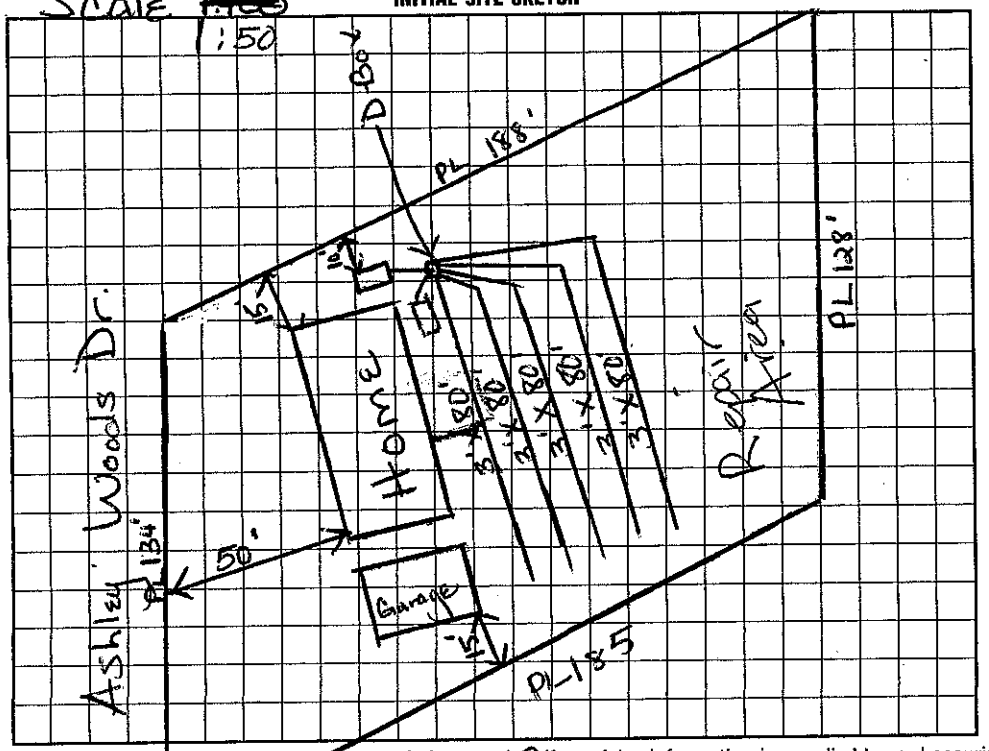

AS BUILT SKETCH

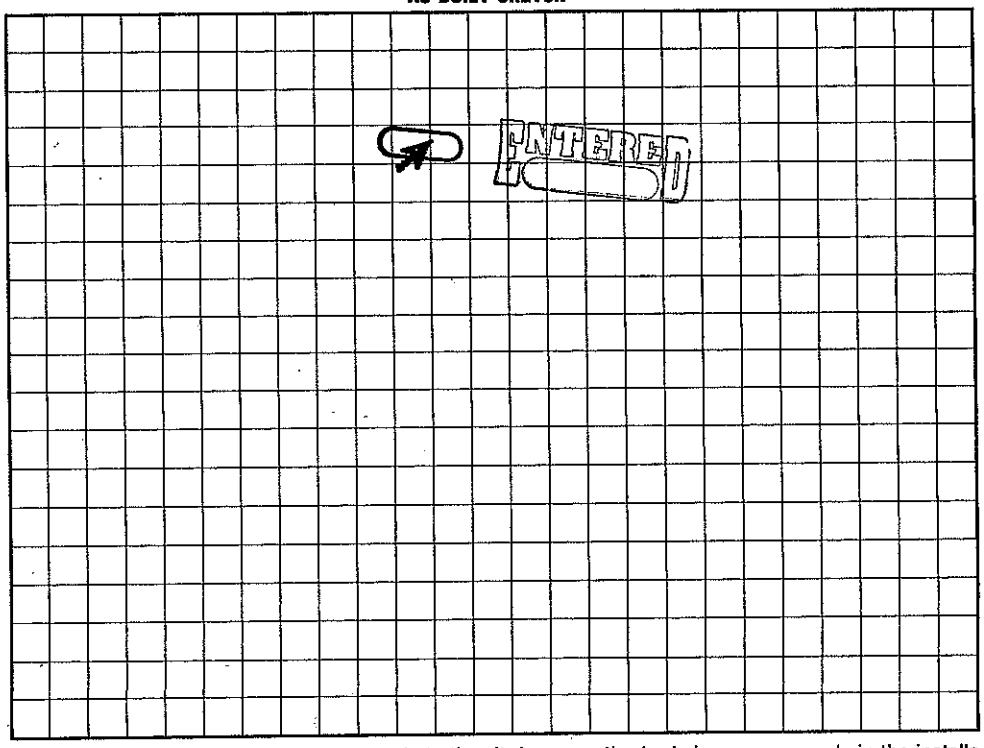

I understand that this permit can be suspended or revoked if any false information is supplied toward securing the permit/any unauthorized changes are made to the site/any unauthorized changes are made in the installation of the system. Improvement Permit with plat valid without expiration. Improvement Permit with site plan valid for sixty months. Authorization to Construct is valid for a period equal to that of Improvement Permit – not to exceed sixty months.

Signed: Tasha Doggett date 6/2/98 Installed by: A1 Backhoe

Improvement Permit by: Maina M. Dotson date 6/1/98 Operation Permit by: Wesley Sparks RS date 6/3/98

Authorization to Construct by: Maina M. Dotson date 6/1/98 Existing System Inspection by: Wesley Sparks RS date 6/3/98

HEALTH DEPT. COPY: WHITE INSPECTION COPY (FINAL): GREEN OWNER COPY (FINAL): YELLOW INSPECTION COPY (INITIAL): PINK OWNER COPY (INITIAL): GOLD