(2700)

IREDELL COUNTY HEALTH DEPARTMENT

STATESVILLE 704-878-5305 MOORESVILLE 704-664-5281

IMPROVEMENT PERMIT / AUTHORIZATION TO CONSTRUCT / OPERATION PERMIT / EXISTING SYSTEM INSPECTI

PERMIT# 72476 PIN# 4665333071 DATE 5-11-98

OWNER OR CONTRACTOR James McKnight PHONE: Business 704 664-9080 Home

ADDRESS 255 Rolling Hills Rd. Mooresville NC 28115

LOCATION Shearers Rd JTR Ashley Woods at Fork bear on Rt before Courtney Ln

SUBDIVISION Ashley Woods BLOCK / SECTION JLOT 10 LOT AREA .5 Acre SITE CLASS. PS DESIGN FLOW 360 gpd L.T.A.R. .3

Septic Tank: 1000 Gallons; STB 760 Date 5/1/98
Pump Tank: Gallons; PT Date
Pump Make: Model Serial No.
Nitrification Field: No Fields 1 Square Feet 900 Linear Feet 300'
No Lines 4 at 75' Trench Width 36" Max Trench Bottom Depth 33"

☒ New System ☐ Repair System Type: I, II, III, IV, V, VI
System Description: Grav. - Plastic Chamb. or Similar
Repair System Description: same
Maintenance Agreement Required: ☐ Yes ☒ No
Gravel Depth N/A ☐ Slab ☒ Crawl Space ☐ Basement w/plumbing ☐ Basement wo/plumbing


☐ House/Mod. Home ☐ Mobile Home ☐ Business ☐ Other
No. Bedrooms 3 No. Bathrooms 2 No. Employees

Water Supply: ☐ Individual ☐ Public ☒ Community

Comments:/Conditions: 25% Reduction in Drainfield Area, Keep Septic System at least 10' from PL & 5' from House.

Comments:/Conditions:

Scale 1:50 **INITIAL SITE SKETCH**

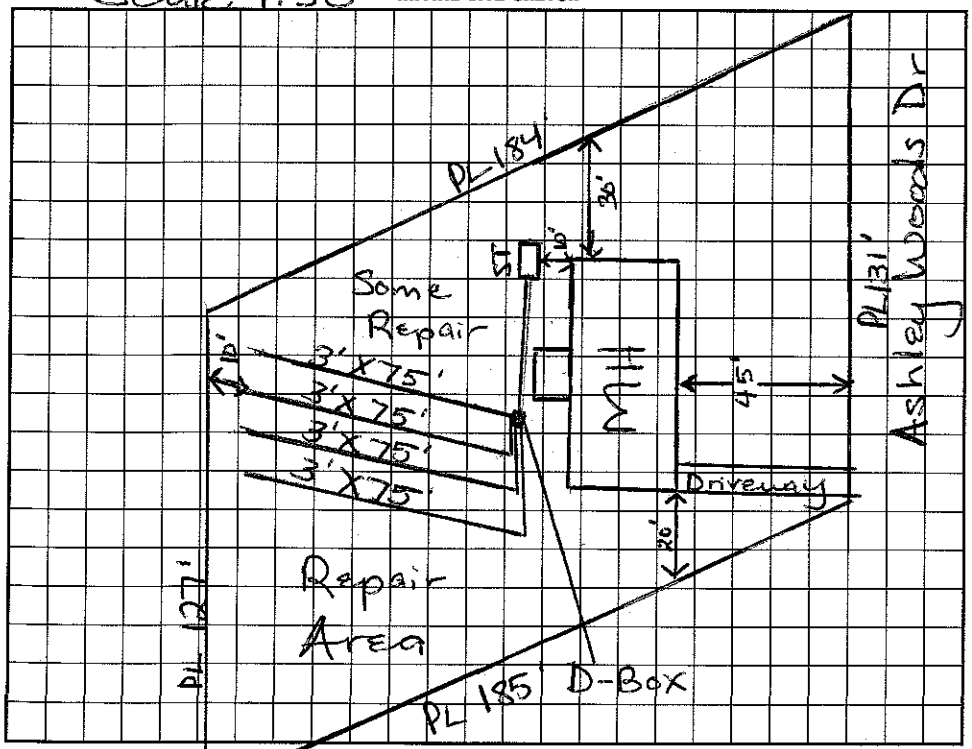

AS BUILT SKETCH

I understand that this permit can be suspended or revoked if any false information is supplied toward securing the permit/any unauthorized changes are made to the site/any unauthorized changes are made in the installation of the system. Improvement Permit with plat valid without expiration. Improvement Permit with site plan valid for sixty months. Authorization to Construct is valid for a period equal to that of Improvement Permit – not to exceed sixty months.

Signed: date 5/12/98
Improvement Permit by: date 5/11/98
Authorization to Construct by: date 5/11/98

Installed by: Randy Miller
Operation Permit by: date 6/29/99
Existing System Inspection by: date

HEALTH DEPT. COPY: WHITE INSPECTION COPY (FINAL): GREEN OWNER COPY (FINAL): YELLOW INSPECTION COPY (INITIAL): PINK OWNER COPY (INITIAL): GOLD