ICHD - ENVIRONMENTAL HEALTH DIVISION

Statesville Office (704) 878-5305 | Mooresville Office (704) 660-3625

PERMIT # AP 322027

SEPTIC: IMPROVEMENT PERMIT / AUTHORIZATION TO CONSTRUCT / OPERATION PERMIT / EXISTING SYSTEM

PIN # 4665 -- 35 -- 3323

APPLICANT/OWNER: Michael Anuna

APPLICANT ADDRESS: 123 Owens Farm Rd Mooresville NC 28115

SITE ADDRESS: 123 Owens Farm Rd Mooresville NC 28115

PHONE: 704-451-1071

ALT. PHONE

SITE DIRECTIONS: (S) NC 115 → (L) Timber → (R) Shearers → (R) Owens Farm → lot on (L)

SAP CONTROLLED: [X] YES [ ] NO

SUBDIVISION: N/A

SECTION: N/A LOT # N/A LOT AREA: 1.334


DESIGN FLOW: EXISTING L.T.A.R.: EXISTING

Septic Tank 1000 (gal)	STB 2071	Date INFILTRATOR	[ ] New System [X] Repair [ ] Expansion System Type: I (II) III IV V VI	[X] Residence	No. Bedrooms		Water Supply
Pump Tank (gal)	PT	Date	System Description: EXISTING	[ ] Business	No. Persons		[X] Private
Pump Make	Model	Serial #	Repair System Description: Tank Replacement	[ ] Other	No. Employees		[ ] Public
# Nitrification Fields	# Lines	Linear Ft	Maintenance Agreement Required: [ ] YES [X] NO	[ ] Slab	[X] Crawl Space		[ ] Community
Trench Width	Trench Bottom Depth (Low side) EXISTING	Gravel Depth	[X] GRAVITY [ ] PRESSURE	[ ] Basement w/ plumbing	[ ] Basement w/o plumbing		

Comments / Conditions: Pump Crush & fill existing tank. Replace distribution device if necessary, Level lines equally.


May set tank differently if needed to achieve fall from plumbing & to connect to drainfield. Stay low from foundation.

INITIAL SITE SKETCH

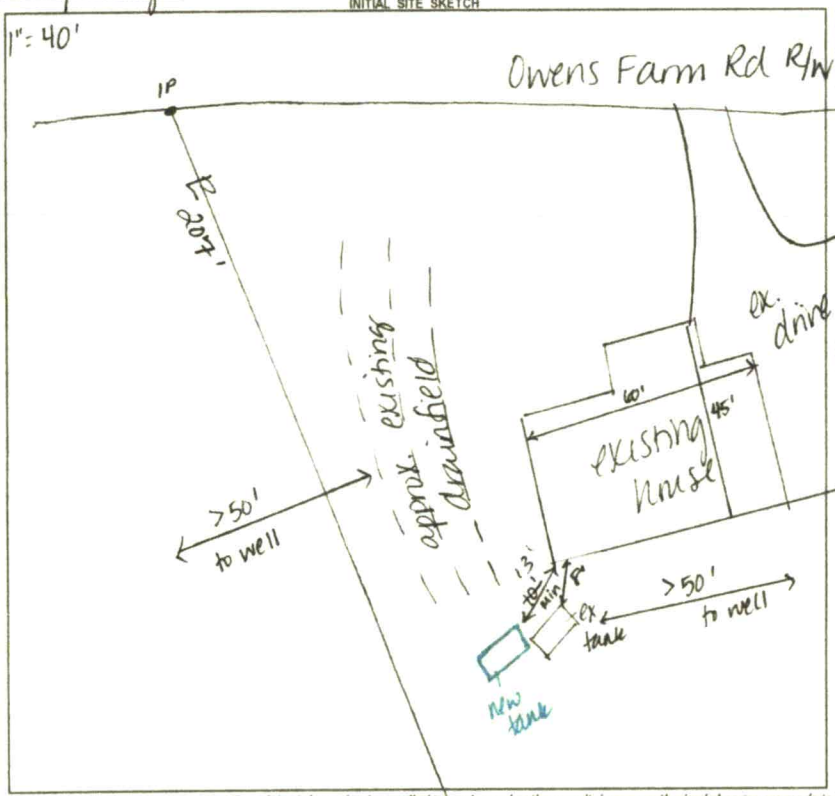

AS BUILT SKETCH

FOR SEPTIC FINAL INSPECTION CALL: 704-664-3703 between 8am-9am the day the inspection is needed. Be sure to speak with an inspector to confirm your time.

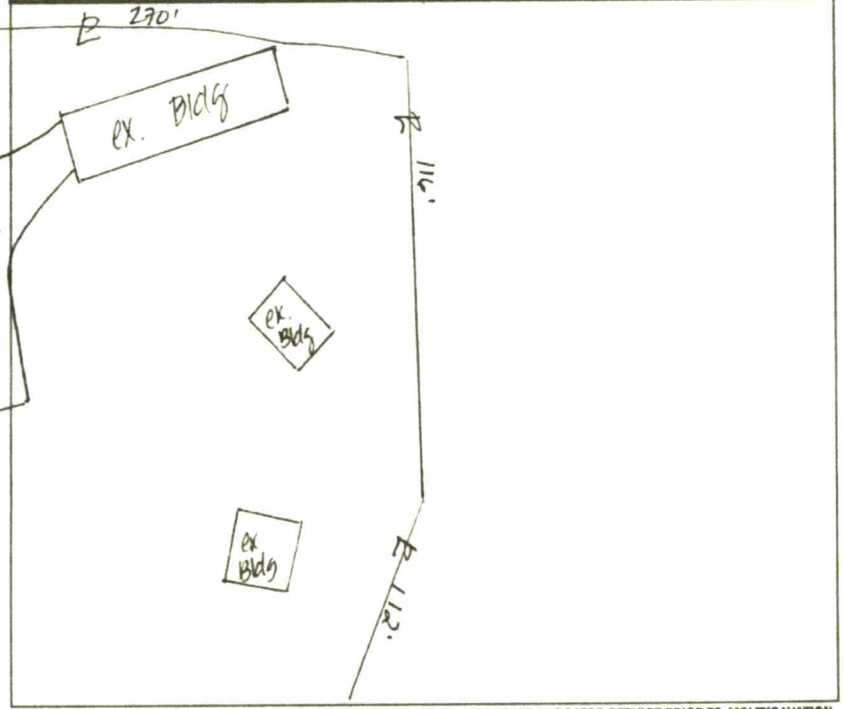

Permit can be suspended or revoked if any false information is supplied toward securing the permit / any unauthorized changes are made to the site / any unauthorized changes are made in the installation of the system. **CONTACT A LOCATOR SERVICE PRIOR TO ANY EXCAVATION**

[ ] **IMPROVEMENT PERMIT** *with plat valid without expiration.* [X] **IMPROVEMENT PERMIT** *with site plan valid for 60 mos.* [X] **AUTHORIZATION TO CONSTRUCT** *valid for period equal to IMPROVEMENT PERMIT--not to exceed 60 mo.*

Owner / Applicant Signature: [signature] Date:

Installed by: MASSEY

IMPROVEMENT PERMIT by: [signature] Date: 10/15/21

OPERATION PERMIT by: Bryant C. White Date: 10-26-2021

AUTHORIZATION TO CONSTRUCT by: [signature] Date: 10/15/21

Existing System Inspected by: Date:

FOR SEPTIC FINAL INSPECTION: CALL 704-664-3703 between 8am-9am the day the inspection is needed.

RECEIVED OCT 0 4 2021

CW

APPLICATION MUST BE FILLED OUT COMPLETELY & BE LEGIBLE OR IT WILL NOT BE PROCESSED

Iredell County Health Department – Environmental Health Division

PAGE 1: *APPLICATION FORM* AP-322027 $150.00

Application For: (X) New Well Permit ( ) Well Repair Permit ( ) Well Abandonment
( ) Septic Improvement Permit ( ) Authorization to Construct ( ) Existing System Inspection (X) Septic System Repair

THE ABOVE PERMIT DOCUMENTS WILL BECOME INVALID IF INFORMATION PROVIDED ON THIS APPLICATION IS FALSIFIED OR CHANGED, OR IF THE SITE IS ALTERED. THE IMPROVEMENT PERMIT IS VALID FOR EITHER 60 MONTHS OR WITHOUT EXPIRATION DEPENDING UPON DOCUMENTATION SUBMITTED. APPLICATION WITH SITE PLAN 60 MONTHS, APPLICATION WITH COMPLETE, SCALED PLAT WITHOUT EXPIRATION. SEE 15A NCAC 18A .1937(f) FOR DETAILS.

Page 2: *Site Plan Worksheet* form MUST accompany this application

The following optional attachments may also be submitted: ( ) Survey Plat, scaled no more than 1 inch = 60 feet
Place an (X) *beside whichever is submitted if applicable* ( ) Custom Site Plan, scaled no more than 1 inch = 60 feet

Applicant Information: (PRINT CLEARLY)

Applicant Name: Michael Ahuna Address: 123 Owens Farm Rd, Mooresville Zip: 28115
Applicant Email: crosman@windstream.net Phone: 704-451-1071 Alt. Phone: _____
Owner Name: Alisha Martin Ahuna Address: 123 Owens Farm Rd, Mooresville Zip: 28115
Owner Email: alisha.martin1969@gmail Phone: 704-430-6571 Alt. Phone: _____

Property Information:

Street Address: 123 Owens Farm Rd, Mooresville NC 28115

Subdivision Name: _____ Section/Phase: _____ Lot Number: _____

Driving Directions: Off Shearers Rd, close to Rocky River Rd intersection

Site Development Information: *(check or complete ALL that apply*

CHECK FOUNDATION TYPE

( ) New Single Family Residence — Maximum Number of Bedrooms: 3 — (X) Crawl Space Foundation
( ) New Multi-Family Residence — Maximum Number of Occupants: 3 — ( ) Concrete Slab Foundation
( ) Accessory Building — ( ) Swimming Pool — ( ) Basement with Plumbing
( ) Bedroom(s) Addition — ( ) Other Addition/Structure: _____ — ( ) Basement without Plumbing
(X) Repair to failing septic system X Tank ___ Drain lines Describe Problem: _____
Non-Residential Site Development: Type of Business: _____
Square Footage of Building: _____ Max. Number of Employees: _____ Max. Number of Seats/Beds/Other: _____

Water Supply: ( ) Replacement Well – Reason: _____
( ) Multi-connection Well Number of Houses: _____ Number of Persons: _____

( ) New Well (X) Existing Well ( ) Community Well ( ) City Water ( ) Other Public Water

Desired Septic System Type: *(you may rank in order of preference)* Year existing system installed: 1964
(X) No Preference ( ) Alternative ( ) Conventional ( ) Innovative ( ) Modified Conventional ( ) Other: _____

Please answer the following to the best of your ability:
( ) Yes (X) No Does the site contain any jurisdictional wetlands?
( ) Yes (X) No Is any non-domestic sewage (i.e. industrial) to be generated?
( ) Yes (X) No Is the site subject to approval by any other public agency?

I have read this application and certify that the information provided herein is true, complete, and correct. Authorized county and state officials are granted right of entry to conduct necessary inspections to determine compliance with applicable laws and rules. I understand that I am solely responsible for the proper identification and labeling of all property lines and corners and making the site accessible so that a complete site evaluation can be performed.

Signature: _____ 10/4/2021
Property owner or owner's legal representative signature (SIGNATURE REQUIRED) DATE

Public Health
Prevent. Promote. Protect.
Iredell County Health Department

IREDELL COUNTY DEPARTMENT OF ENVIRONMENTAL HEALTH

Public Health
Prevent. Promote. Protect.
Iredell County Health Department

DOCUMENTATION TO AUTHORIZE AN OWNER'S LEGAL REPRESENTATIVE

(Check and sign only ONE of the options below)

☐ **1. * APPLICANT AND OWNER ARE THE SAME. *** (*Sign here*) _____

Applications for permits require the "signature of the owner or owner's legal representative" (15A NCAC 18A .1937). If the owner does not sign the application himself or herself, they can submit any one of the following documents to designate their legal representative: *Power of Attorney; Real Estate Contract; Estate executor; Bankruptcy trustee; Court ordered guardianship*
In the absence of the above documentation, the property owner may provide the local health department with documentation that designates a legal representative. A property owner may:
Complete this form to document his or her legal representative, or provide his or her own form that contains the information in this form. If there are multiple property owners, then all property owners must sign the form that designates a legal representative.
By signing a form that designates a legal representative for purposes of 15A NCAC 18A .1937, the property owner authorizes that representative to act on their behalf in matters pertaining to the application and permitting process, including signing or receiving any application, document or permit. The owner retains full responsibility to meet all permit conditions specified by the local health department.

☒ **2.** I, Alisha Martin Ahuna, am the legal owner(s) of the property located at 123 Owens Farm Rd, Mooresville NC 28115, identified as PIN (Parcel Identification Number)_____, located in Iredell County, North Carolina.

I do hereby authorize (**print legal representative/company name**) Michael Ahuna, _____, to act as an agent on my behalf in applying for/signing/obtaining any of the documents described below.

- Application for Improvement Permit (IP) / Authorization to Construct (AC)
- Improvement Permit (IP) / Authorization to Construct (AC)
- Application for soil-site evaluation (new/repair)
- Application/permit for private drinking water well/well abandonment
- Application for Compliance Inspection

I agree to abide by all decisions and/or conditions between the legal representative acting on my behalf and the Iredell County Department of Public Health, Environmental Health Division.

Alisha L. Martin Ahuna
Signature of Owner(s)

10/4/21
Date

Mooresville - Environmental Health

Fax: 704-662-3239
610 E. Center Avenue, Mooresville, NC 28115

Statesville - Environmental Health
ronda.hart@co.iredell.nc.us
Fax: 704-871-3483
349 N. Center Street, Statesville, NC 28677

30
112
112
415
229
185
116
40
137
HOUSE
SEPTIC
209
Owens Farm Rd
139
207
380
75
E
N
S
W