IREDELL COUNTY HEALTH DEPARTMENT

STATESVILLE 704-878-5305 200.00 Paid MOORESVILLE 704-664-5281

IMPROVEMENT PERMIT / AUTHORIZATION TO CONSTRUCT / OPERATION PERMIT / EXISTING SYSTEM INSPECTION

PERMIT# 21274 PIN# 4665 35 9926 DATE 3/12/02

OWNER OR CONTRACTOR Dan + Annette Newton PHONE: Business Home 704-663-2732

ADDRESS 1271 Sheares Rd. Mooresville, NC. 28115

LOCATION Sheares Rd.

SUBDIVISION No BLOCK / SECTION LOT LOT AREA 3.1 Ac SITE CLASS PS DESIGN FLOW 460 L.T.A.R. .3

Septic Tank: 1000 Gallons; STB 794 Date 3-3-02
~~Grease Trap~~ Pump Tank: 1500 Gallons; PT 338 Date 2/27/02
Pump Make: Model 990 Serial No. 330
Nitrification Field: No Fields 1 Square Feet ~~1333~~ Linear Feet ~~444~~
No Lines ~~444~~ Trench Width 3' Max Trench Bottom Depth 3'

[X] New System [ ] Repair System Type: I (II) III. IV. V. VI
System Description: ~~Gravity~~ EZLAY
Repair System Description: Pressure-Ch. Plastic
Maintenance Agreement Required: [ ] Yes [X] No

[ ] House/Mod. Home No. Bedrooms
[ ] Mobile Home No. Bathrooms
[ ] Business No. Employees
[X] Other 800 SQ FT CATERING


[X] Slab [ ] Crawl Space [ ] Basement w/plumbing [ ] Basement wo/plumbing

Water Supply:
[ ] Individual
[ ] Public
[X] Community
MOORESVILLE


Comments:/Conditions:
3@110'x3 EZLAY Dun landing contours -

Comments:/Conditions: P/L
EZFLOW INSTALLED.

INITIAL SITE SKETCH

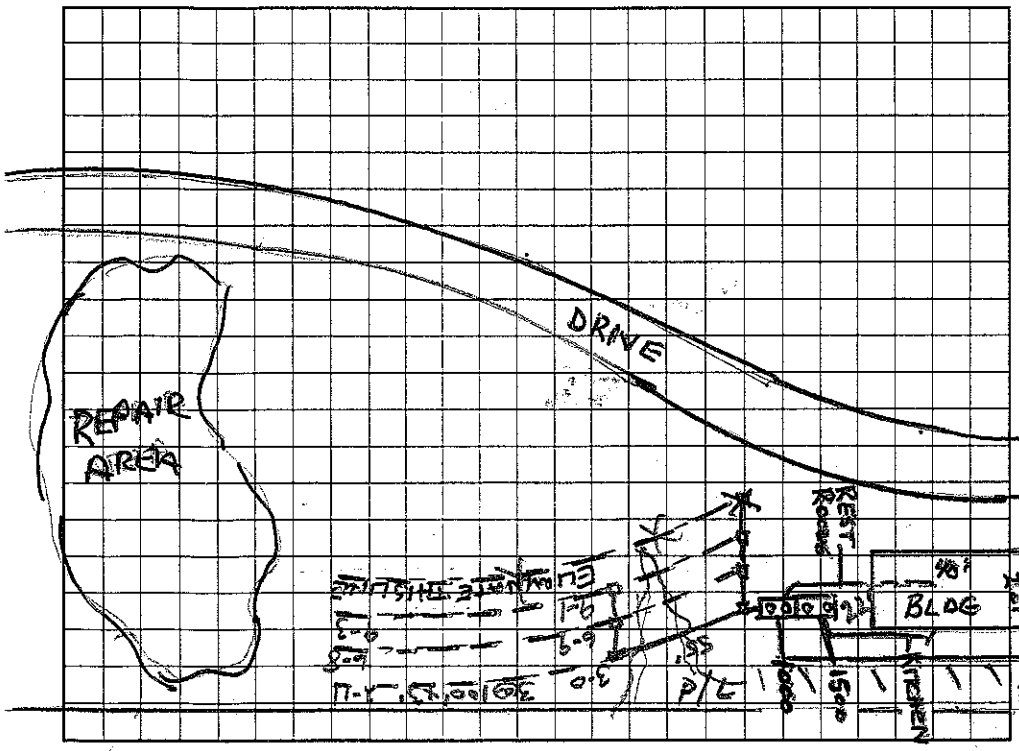

AS BUILT SKETCH

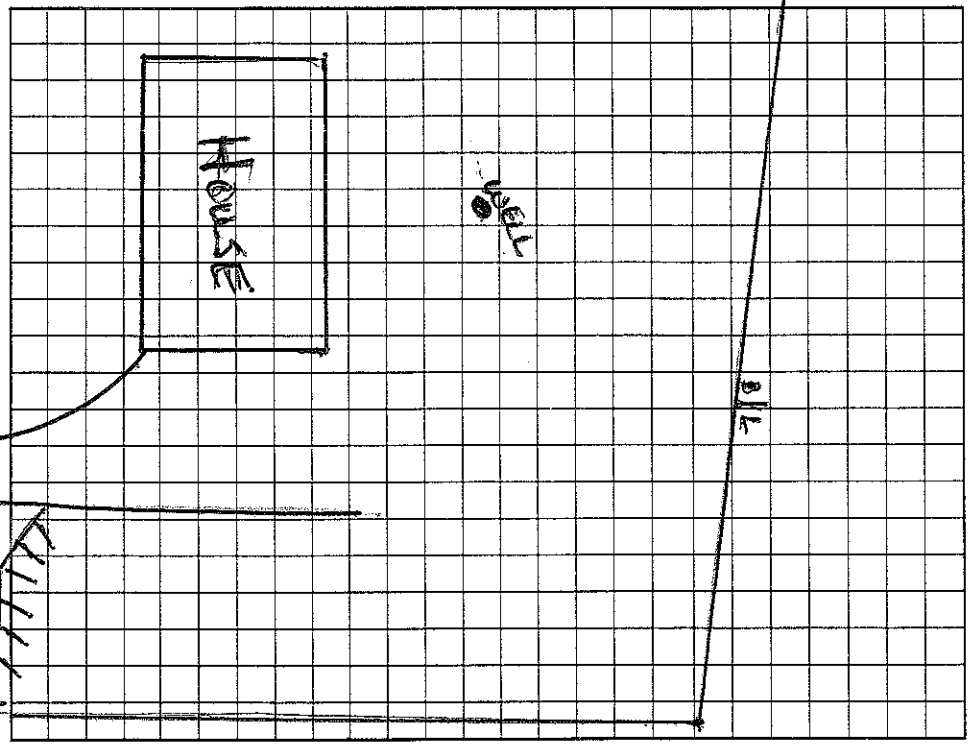

Permit can be suspended or revoked if any false information is supplied toward securing the permit/any unauthorized changes are made to the site/any unauthorized changes are made in the installation of the system. Improvement Permit with plat valid without expiration. Improvement Permit with site plan valid for sixty months. Authorization to Construct is valid for a period equal to that of Improvement Permit – not to exceed sixty months.

Signed: Annette Newton date 3/18/02 Installed by: Larry Beam

Improvement Permit by: Wesley Sparks R.S. date 3/12/02 Operation Permit by: date

Authorization to Construct by: Wesley Sparks R.S. date 3/12/02 Existing System Inspection by: date

HEALTH DEPT. COPY: WHITE OWNER COPY (FINAL): YELLOW OWNER COPY (INITIAL): PINK