4665 35 • 9926

IREDELL COUNTY HEALTH DEPARTMENT

STATESVILLE 704-878-5305 MOORESVILLE 704-664-5281

IMPROVEMENT PERMIT / CERTIFICATE OF COMPLETION / OPERATION PERMIT / EXISTING SYSTEM INSPECTION

PROPERTY DESCRIPTION NO. 3087 DATE 1/3/95 TAX MAP NO. 10B46 / 10B48 Watershed: ☐ Yes ☒ No

OWNER OR CONTRACTOR Dan + Annette Newton PHONE: Business _____ Home 664 - 1374

ADDRESS 157 Owens Farm Moorsville, NC, 28115

LOCATION Sheppard Rd. on Owens from Owens Farm Rd.

SUBDIVISION NA BLOCK / SECTION _____ LOT N/A LOT AREA 3.14 Ac. SITE CLASS. P DESIGN FLOW 450 L.T.A.R. .3

Septic Tank: 1000 Gallons; STB 794 Date 1-19-95

Pump Tank: ~~1000~~ New Gallons; PT _____ Date _____

Pump Make: _____ Model _____ Serial No. _____

Nitrification Field: No. Fields 1 Square Feet 1400 Linear Feet 533

No. Lines 5 (4) Trench Width 36" Max Trench Bottom Depth 36" Gravel Depth 12"

☒ New System ☐ Repair System Type: I, (II), III, IV, V, VI

System Description: CONV - DIST. BOX

Repair System Description: _____

Maintenance Agreement Required: ☐ Yes ☒ No

☒ House/Mod. Home No. Bedrooms 4

☐ Mobile Home No. Bathrooms 3

☐ Business No. Employees _____

☐ Other _____

☐ Slab ☐ Crawl Space ☒ Basement w/plumbing ☐ Basement wo/plumbing


Water Supply: ☒ Individual ☐ Community ☐ Public

Comments:

Comments:

Installed as drawn.

INITIAL SITE SKETCH

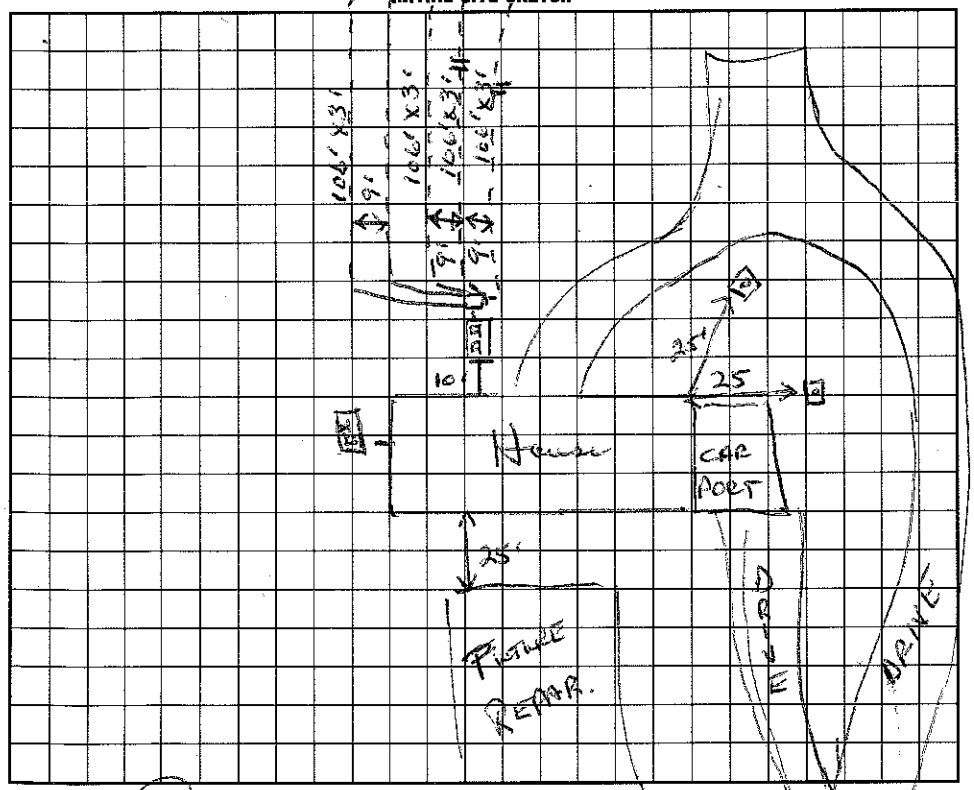

AS BUILT SKETCH

I understand that this permit can be suspended or revoked if any false information is supplied toward securing the permit/any unauthorized changes are made to the site/any unauthorized changes are made in the installation of the system. Improvement Permit is valid for 60 months from date of issuance.

Signed: Dan Newton

Improvement Permit by: Wesley Sparks R.S. date 1/3/95

Existing System Inspection by: _____ date _____

Installed by: E J Ewin

Certificate of Completion by: Wesley Sparks R.S. date 5/9/95

Operation Permit by: _____ date _____

HEALTH DEPT. COPY: WHITE INSPECTION COPY (FINAL): GREEN OWNER COPY (FINAL): YELLOW INSPECTION COPY (INITIAL): PINK OWNER COPY (INITIAL): GOLD