IREDELL COUNTY HEALTH DEPARTMENT

IMPROVEMENT PERMIT / ~~CERTIFICATE OF COMPLETION~~ / OPERATION PERMIT / EXISTING SYSTEM INSPECTION

STATESVILLE 704-878-5305 MOORESVILLE 704-664-5281

Authorization to construct 4:00

PROPERTY DESCRIPTION NO. 26163 DATE 2/25/97

OWNER OR CONTRACTOR ROBERT PARKER TAX MAP NO. 477034 2446

ADDRESS 1163 SHEALERS RD MOORESVILLE NC 28115 PHONE: Business _____ Home 663-0269

LOCATION 801 N - TL TERRETT RD - CROSS CREEK ≈ .4 miles ON RT Watershed: ☐ Yes ☑ No

SUBDIVISION — BLOCK / SECTION — LOT — LOT AREA 6.34AC SITE CLASS. RS DESIGN FLOW 360 GPD L.T.A.R. .25 GPD/FT²

Septic Tank: 1000 Gallons; STB TP1012 / 1000 Date 9-1-98

Pump Tank: _____ Gallons; PT _____ Date _____

Pump Make: _____ Model _____ Serial No. _____

Nitrification Field: No Fields 1 Square Feet 1440 Linear Feet 480

No Lines 6@80' Trench Width 36" Max Trench Bottom Depth 24-30" Gravel Depth 12"

☑ New System ☐ Repair System Type: I, II, III, IV, V, VI

System Description: GRAVITY CONVENTIONAL

Repair System Description: SAME

Maintenance Agreement Required: ☐ Yes ☑ No

☑ House/Mod. Home ☐ Mobile Home ☐ Business ☐ Other

No. Bedrooms 3 No. Bathrooms 2 No. Employees ____


☐ Slab ☑ Crawl Space ☐ Basement w/plumbing ☐ Basement wo/plumbing

Water Supply: ☑ Individual ☐ Community ☐ Public


Comments:

Comments: Tanks Checked 11/2/98 & Trenches 1-4 checked MD

INITIAL SITE SKETCH 1"=100'

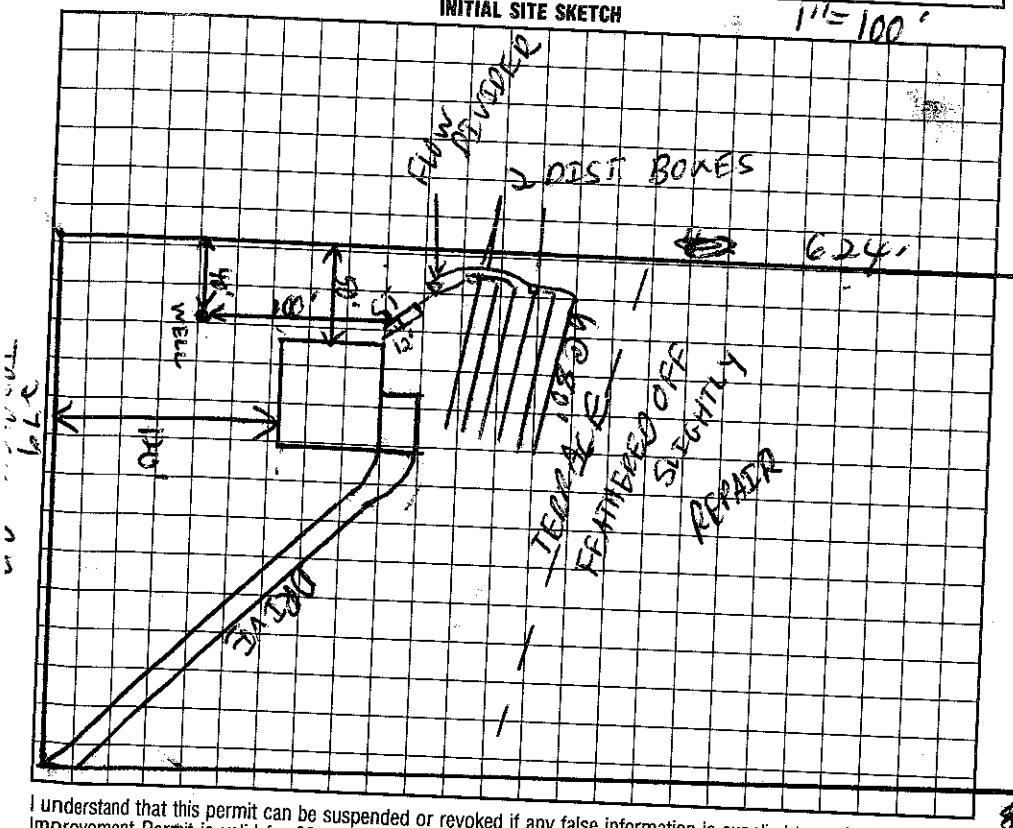

AS BUILT SKETCH

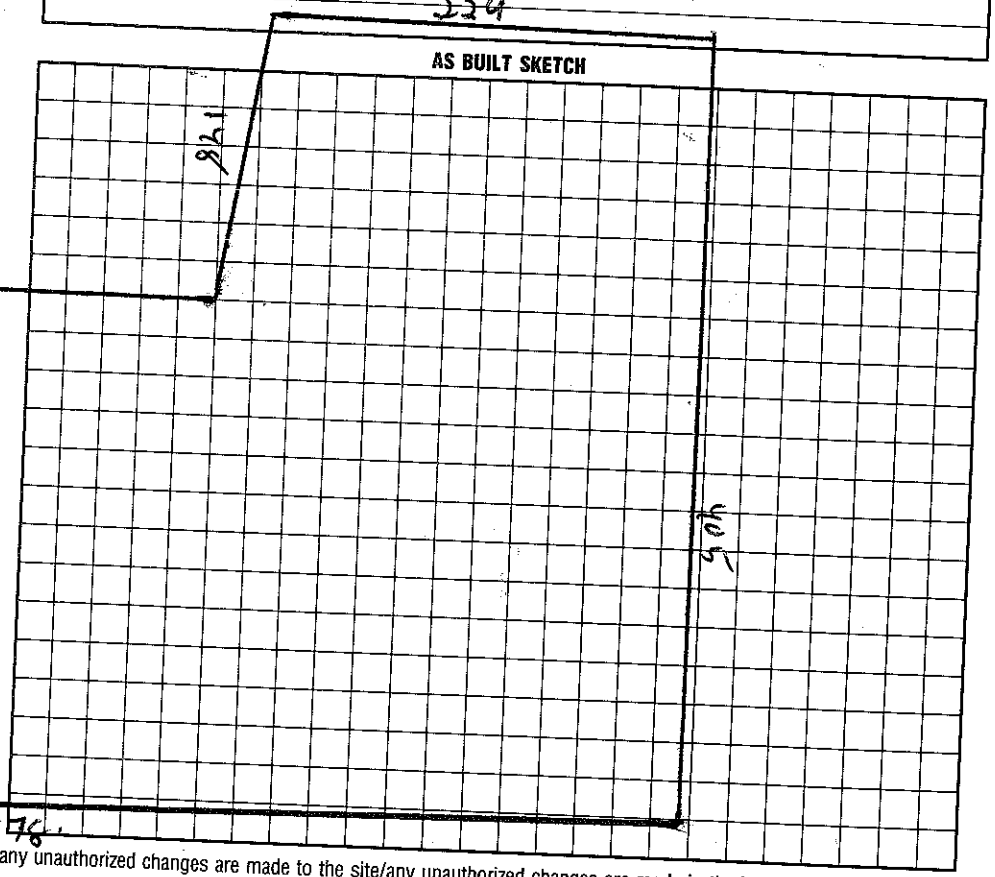

I understand that this permit can be suspended or revoked if any false information is supplied toward securing the permit/any unauthorized changes are made to the site/any unauthorized changes are made in the installation of the system. Improvement Permit is valid for 60 months from date of issuance.

Signed: Robert W. Parker

Improvement Permit by: C. [illegible] date 2/25/97

~~Authorization to~~ Existing System Inspection by: C. [illegible] date 2/25/97

Installed by: Piedmont Backhoe Service

Certificate of Completion by: _____ date _____

Operation Permit by: Wesley Starnes RS date 11/4/98

HEALTH DEPT. COPY: WHITE INSPECTION COPY (FINAL): GREEN OWNER COPY (FINAL): YELLOW INSPECTION COPY (INITIAL): PINK OWNER COPY (INITIAL): GOLD