IREDELL COUNTY HEALTH DEPARTMENT

Statesville Phone TR 3-7271 Mooresville Phone NO 3-1271

PERMIT TO INSTALL SEPTIC TANK

Permit NO. _____ Permit Date March 21 1962

Owner J. T. Stutts Address Mooresville, N.C.

Installed By Stutts & Blanton Address Mooresville, N.C.


Location of Property Sherrers Chapel Road 3 miles East of Mooresville

| Tank | | Capacity | | Length of Lines | | Fixtures | |
|---|---|---|---|---|---|---|---|
| Block | ( ) | 800 | (✓) | 150' | ( ) | No. of Baths | (1½) |
| Precast | (✓) | 900 | ( ) | 175' | ( ) | Dishwasher | ( ) |
| | | 1000 | (✓) | 200' | ( ) | Garbage Grdr. | ( ) |
| | | 1100 | ( ) | 225' | (✓) | Auto-Washer | ( ) |
| | | 1200 | ( ) | 250' | ( ) | Other | |
| | | Other | | Other | | | |

NOTIFY HEALTH DEPARTMENT AT LEAST EIGHT HOURS BEFORE TANK IS TO BE INSPECTED.

Final Inspection 3/21 1962 Apprcved (✓) Disapproved ( )

Remarks 65' from well

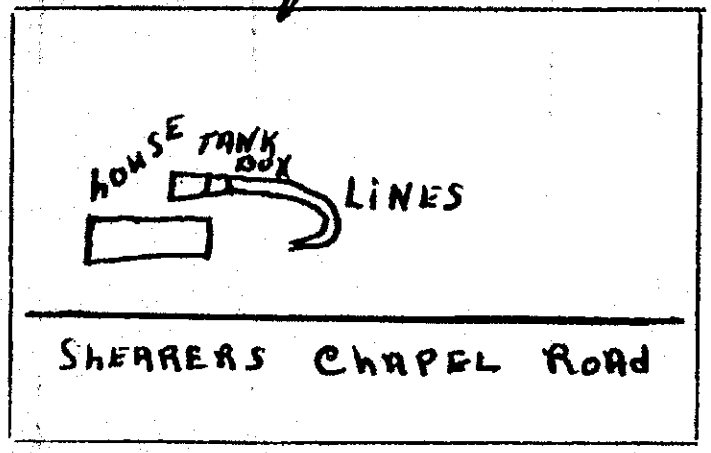


Sketch of Installation

Licensed Contractor

J. T. Stutts

Sanitarian