ICHD - ENVIRONMENTAL HEALTH DIVISION

Statesville Office (704) 878-5305 Mooresville Office (704) 660-3625 PERMIT # OSWP 2023-42278

SEPTIC: IMPROVEMENT PERMIT / AUTHORIZATION TO CONSTRUCT / OPERATION PERMIT / EXISTING SYSTEM

PIN # 4665 -- 37 -- 3998

APPLICANT/OWNER: Rodney Burleyson APPLICANT ADDRESS: 125 Pandora Rd, Mooresville 28115

SITE ADDRESS: 125 Pandora Rd, Mooresville 28115 PHONE: 337-509-9006 ALT. PHONE

SITE DIRECTIONS: Shearers Rd - @ Pandora - Lot on @ SAP CONTROLLED: ☐ YES ☐ NO

SUBDIVISION: Annexation Southern Area SECTION: - LOT # - LOT AREA: 0.6 DESIGN FLOW: Ex. L.T.A.R.: Ex.

Septic Tank	1000 (gal)	STB	Infiltrator	Date					
Pump Tank	(gal)	PT		Date					
Pump Make		Model	EXISTING	Serial #					
# Nitrification Fields		# Lines		Linear Ft					
Trench Width		Trench Bottom Depth(Low side)		Gravel Depth					

☐ New System ☑ Repair ☐ Expansion System Type: I (II) III IV V VI

System Description:

Repair System Description: Tank Replacement

Maintenance Agreement Required: ☐ YES ☑ NO

☑ GRAVITY ☐ PRESSURE

☑ Residence ☐ Business ☐ Other ☐ Slab ☐ Basement w/plumbing


No. Bedrooms: Ex. No. Persons: Ex. No. Employees: Crawl Space ☐ Basement w/o plumbing

Water Supply: ☑ Private ☐ Public ☐ Community

Comments / Conditions: Place new tank in same place as existing tank - replace distribution as needed.

System functioning properly at time of inspection


INITIAL SITE SKETCH

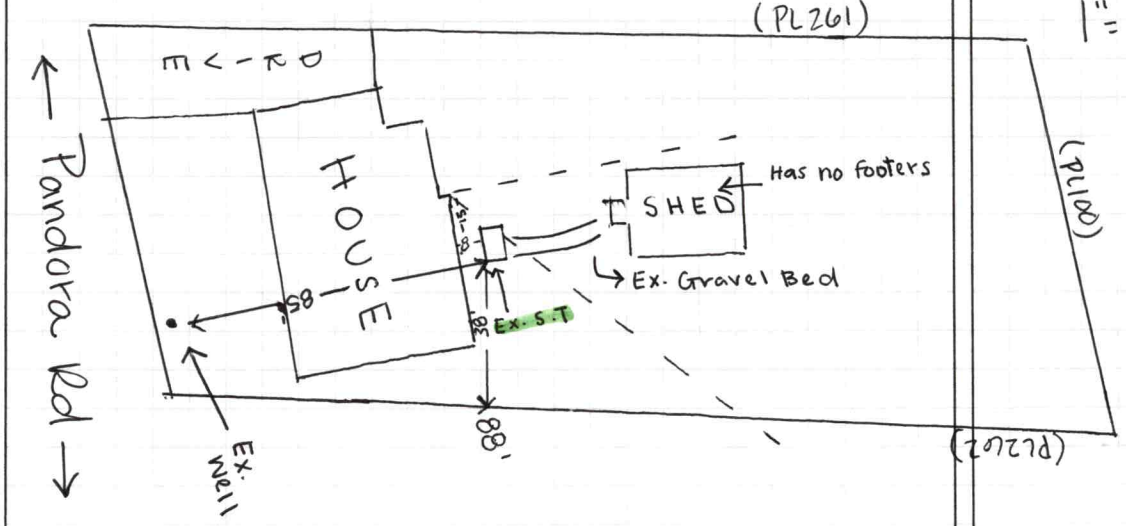

12/20/23 Drainlines infiltrated w/ roots - used PVC to reach as far into terracotta as possible

AS BUILT SKETCH

FOR SEPTIC FINAL INSPECTION CALL: 704-664-3703 between 8am-9am the day the inspection is needed. Be sure to speak with an inspector to confirm your time.

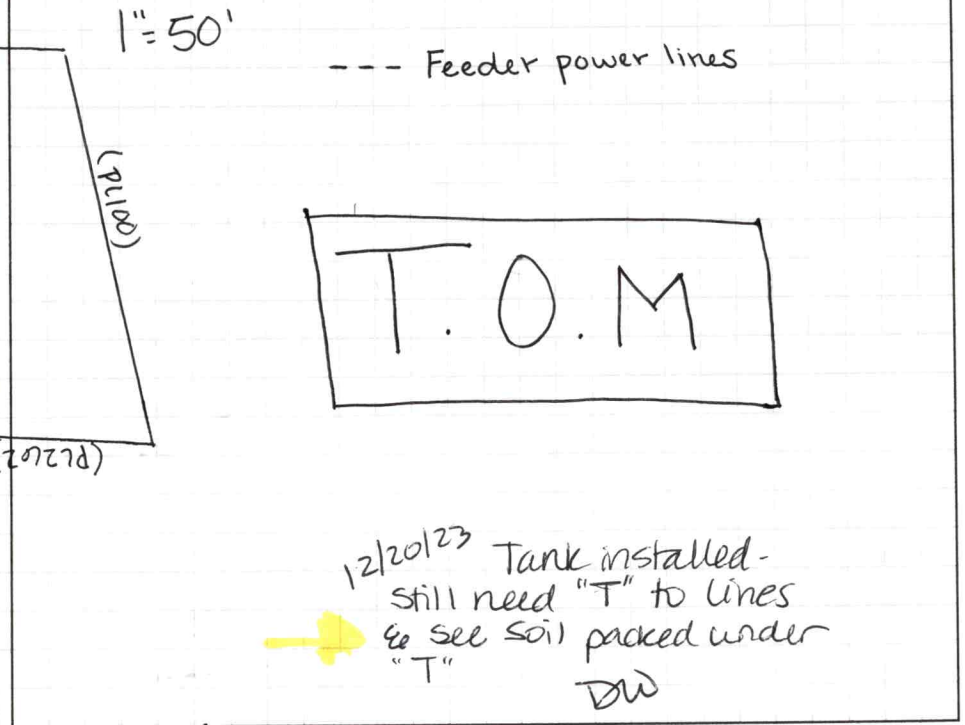

12/20/23 Tank installed - still need "T" to lines & see soil packed under "T" DW

Permit can be suspended or revoked if any false information is supplied toward securing the permit / any unauthorized changes are made in the installation of the system. CONTACT A LOCATOR SERVICE PRIOR TO ANY EXCAVATION

☐ **IMPROVEMENT PERMIT** *with plat valid without expiration.* ☑ **IMPROVEMENT PERMIT** *with site plan valid for 60 mos.* ☑ **AUTHORIZATION TO CONSTRUCT** *valid for period equal to IMPROVEMENT PERMIT--not to exceed 60 mo.*

Owner / Applicant Signature: online Date: - Installed by: Carolina Septic Pros

IMPROVEMENT PERMIT by: Sydney Holland Date: 12/5/23 OPERATION PERMIT by: Sarah Williams Date: 12/21/23

AUTHORIZATION TO CONSTRUCT by: Sydney Holland Date: 12/5/23 Existing System Inspected by: Date:

FOR SEPTIC FINAL INSPECTION: CALL 704-664-3703 between 8am-9am the day the inspection is needed.

PERMIT SNAPSHOT REPORT OSWP-2023-42278 FOR IREDELL COUNTY

Permit Type	Environmental Health OSWP	**Project:**		**App Date:**	12/01/2023
Work Class:	EH Septic Permit	**District:**	Mooresville	**Exp Date:**	NOT AVAILABLE
Status:	PRIORITY PERMIT	**Square Feet:**	0.00	**Completed:**	NOT COMPLETED
Valuation:	$0.00	**Assigned To:**	Holland, Sydney	**Approval Expire Date:**	

Description: Septic tank is old and damaged. Need new septic tank installed.

Parcel: 4665373998.000 Main	**Address:** 125 Pandora Rd Mooresville, NC 28115 Main	**Zone:** MOORESVILLE(MOORESVILLE)

Property Owner	Applicant/Authorized Agent
Rodney A Burleyson	Rodney A Burleyson
125 Pandora Rd	125 Pandora Rd
Mooresville, NC 28115	Mooresville, NC 28115
Mobile: (337) 509-9006	Mobile: (337) 509-9006

Permit Custom Fields

How is your site plan being submitted	Custom Site Plan	Septic Application/Permit Type	Repair	Does the site contain any jurisdictional wetlands	No
Non-domestic Sewage Generated	No	Other Public Agency	No	All proposed structure dimensions	1000 Gallons 127″ L x 60″ W x 51″ H 52.92 Sq. Ft.
Maximum Number of Bedrooms	4	If other Addition/Structure, please explain		Number of Occupants	5
Foundation Type	Crawl Space Foundation	Residential/Business/Other	Residential	Water Supply	Existing Well
Desired Septic System Type	Conventional (most common)	Additional Unique Setbacks Apply	No		

Attachment File Name	Added On	Added By	Attachment Group	Notes
Signature_Rodney_Burleyson_12/1/2023.jpg	12/01/2023 16:15	Burleyson, Rodney		Uploaded via CSS
125 Pandora Rd. Septic_v1.pdf	12/01/2023 16:57	Hart, Ronda	Available Online	Site Plan
125 Pandora Rd. Septic Authorization.pdf	12/01/2023 16:59	Hart, Ronda	Available Online	AA

Workflow Step / Action Name	Action Type	Start Date	End Date
Application Completeness Check v.1		12/01/2023 16:58	12/01/2023 16:58
Confirm application complete v.1	Generic Action		12/01/2023 16:58
~~Zoning Review v.1~~			12/01/2023 16:59
~~Floodplain Admin Overview v.1~~	Task		12/01/2023 16:59
~~Issue Invoice v.1~~	Generic Action		12/01/2023 16:59
~~Fees Paid v.1~~	Generic Action		12/01/2023 16:59
Fees v.1			
Issue Invoice v.1	Generic Action		
Fees Paid v.1	Generic Action		
Lot Readiness Verification v.1			
OSWP Septic Preliminary Site Visit v.1	Inspection		
OSWP Site Evaluation v.1	Inspection		
Issue Improvement Permit v.1			
Issue Invoice v.1	Generic Action		