DW

ICHD - ENVIRONMENTAL HEALTH DIVISION

Statesville Office (704) 878-5305 Mooresville Office (704) 660-3625 PERMIT # OSWP 2023-42278

SEPTIC: IMPROVEMENT PERMIT / AUTHORIZATION TO CONSTRUCT / OPERATION PERMIT / EXISTING SYSTEM

PIN # 4665 -- 37 -- 3998

APPLICANT/OWNER: Rodney Burleyson APPLICANT ADDRESS: 125 Pandora Rd, Mooresville 28115

SITE ADDRESS: 125 Pandora Rd, Mooresville 28115 PHONE: 337-509-9006 ALT. PHONE

SITE DIRECTIONS: Shearers Rd - @ Pandora - Lot on (L) SAP CONTROLLED: ☐ ~~YES~~ ☐ ~~NO~~

SUBDIVISION: Annexation Southern Area SECTION: - LOT # - LOT AREA: 0.6 DESIGN FLOW: Ex. L.T.A.R.: Ex.

Septic Tank 1000 (gal) STB Infiltrator Date

Pump Tank (gal) PT Date

Pump Make Model EXISTING Serial #

Nitrification Fields # Lines Linear Ft

Trench Width Trench Bottom Depth(Low side) Gravel Depth

☐ New System ☑ Repair ☐ Expansion System Type: I (II) III IV V VI

System Description:

Repair System Description: Tank Replacement

Maintenance Agreement Required: ☐ YES ☑ NO

☑ GRAVITY ☐ PRESSURE

☑ Residence No. Bedrooms Ex

☐ Business No. Persons Ex

☐ Other No. Employees

☐ Slab ☐ Crawl Space


☐ Basement w/plumbing ☐ Basement w/o plumbing

Water Supply: ☑ Private ☐ Public ☐ Community

Comments / Conditions: Place new tank in same place as existing tank. Replace distribution as needed.

System functioning properly at time of inspection

INITIAL SITE SKETCH

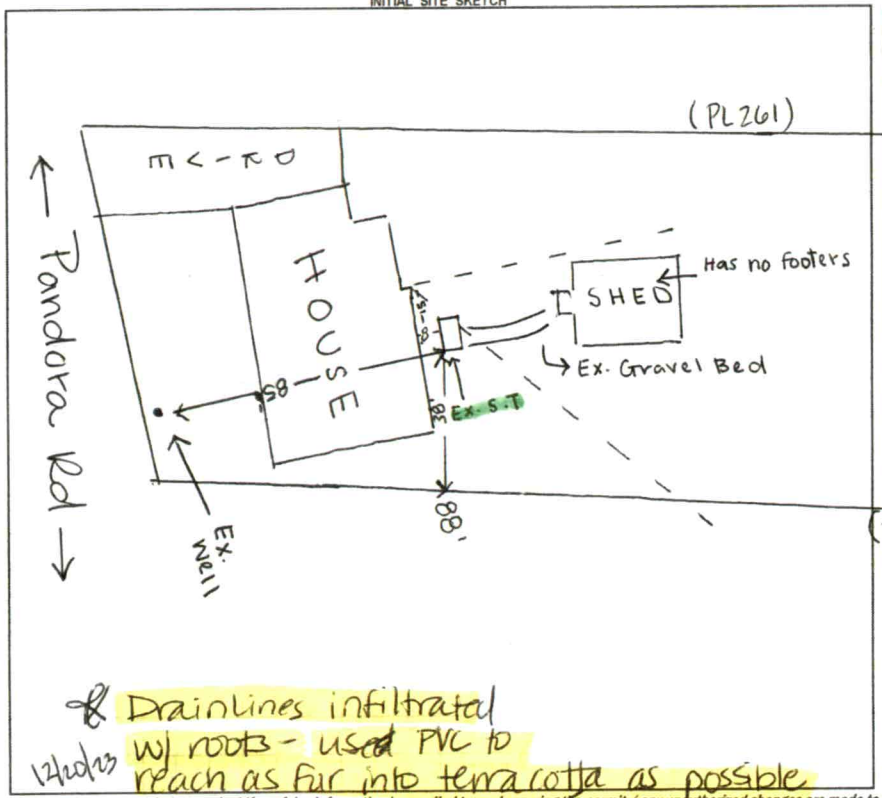

AS BUILT SKETCH

FOR SEPTIC FINAL INSPECTION CALL: 704-664-3703 between 8am-9am the day the inspection is needed. Be sure to speak with an inspector to confirm your time.

1" = 50'

--- Feeder power lines

T.O.M

12/20/23 Tank installed - still need "T" to lines & see soil packed under "T" DW

12/20/23 Drainlines infiltrated w/ roots - used PVC to reach as far into terracotta as possible. SW 12/21/23

Permit can be suspended or revoked if any false information is supplied toward securing the permit / any unauthorized changes are made to the site / any unauthorized changes are made in the installation of the system. **CONTACT A LOCATOR SERVICE PRIOR TO ANY EXCAVATION**

☐ **IMPROVEMENT PERMIT** *with plat valid without expiration.* ☑ **IMPROVEMENT PERMIT** *with site plan valid for 60 mos.* ☑ **AUTHORIZATION TO CONSTRUCT** *valid for period equal to IMPROVEMENT PERMIT--not to exceed 60 mo.*

Owner / Applicant Signature: online Date: - Installed by: Carolina Septic Pros

IMPROVEMENT PERMIT by: Sydney Holland Date: 12/5/23 OPERATION PERMIT by: Sarah Williams Date: 12/21/23

AUTHORIZATION TO CONSTRUCT by: Sydney Holland Date: 12/5/23 Existing System Inspected by: Date:

FOR SEPTIC FINAL INSPECTION: CALL 704-664-3703 between 8am-9am the day the inspection is needed.