IREDELL COUNTY HEALTH DEPARTMENT

STATESVILLE 704-878-5305 MOORESVILLE 704-664-5281

IMPROVEMENT PERMIT / AUTHORIZATION TO CONSTRUCT / OPERATION PERMIT / EXISTING SYSTEM INSPECTION

PERMIT # Repair PIN # 4665379653 DATE 6/1/09

OWNER or APPLICANT Thad Patrick PHONE: Business 704.658.7280 Home: 704.799.1304

OWNER or APPLICANT ADDRESS 119 Gable Rd. Mooresville, NC 28115

LOCATION / DIRECTIONS Shearer's South, TL Pandora, TR Gable, on lft

SUBDIVISION — BLOCK / SECTION — LOT # — LOT AREA — DESIGN FLOW 360 gal/d L.T.A.R. —

Septic Tank 1000 Gallons: STB 825 Date 4-22-09

Pump Tank — Gallons: PT — Date —

Pump Make — Model — Serial # —

Nitrification Field No Fields 1 No Lines bed Linear Feet existing

Trench Width — Max. Trench Bottom Depth — Gravel Depth —

☐ New System ☒ Repair ☐ Expansion System Type I (II) III IV V VI

System Description: existing gravel bed

Repair System Description: Gravity 25%

Maintenance Agreement Required ☐ YES ☒ NO

☒ GRAVITY ☐ PRESSURE

☒ Residence No. Bedrooms 3

☐ Business No. Persons —

☐ Other No. Employees —

☐ Slab ☒ Crawl Space

☐ Basement w/plumbing ☐ Basement w/o plumbing

Water Supply: ☒ Private ☐ Public ☐ Community


Comments / Conditions * ~~Gravity~~ Pump, crush, fill old tank

* Maintain all setbacks including staying 15' away from pool.


Comments / Conditions * Installing new tank

White Fiber - Zoeller

INITIAL SITE SKETCH

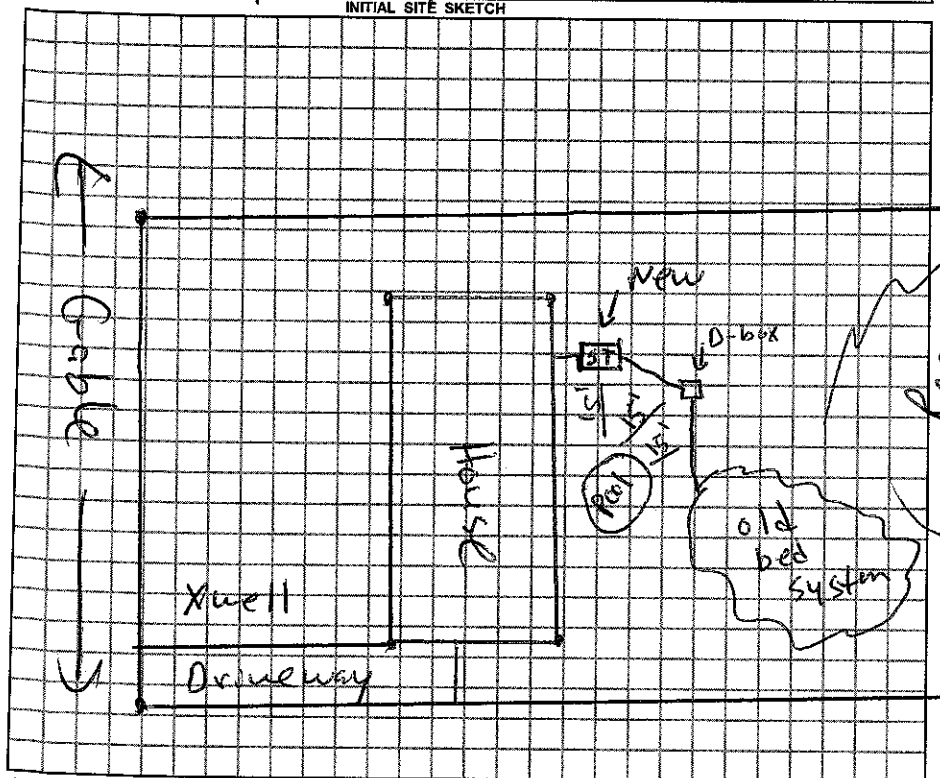

AS BUILT SKETCH

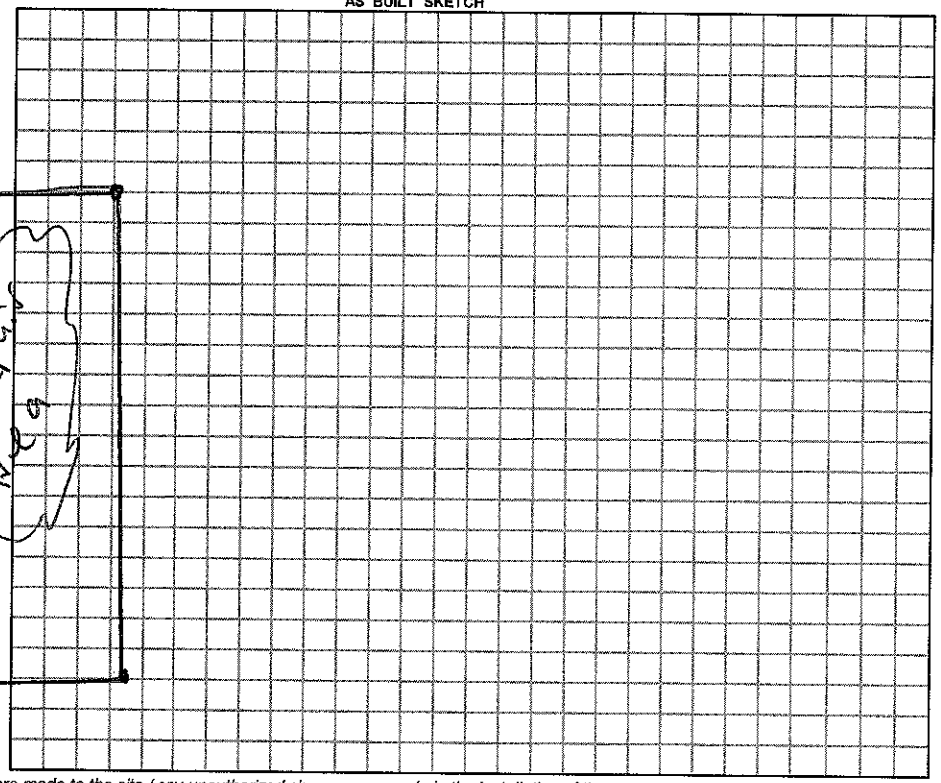

Permit can be suspended or revoked if any false information is supplied toward securing the permit / any unauthorized changes are made to the site / any unauthorized changes are made in the installation of the system.

☐ *IMPROVEMENT PERMIT w / plat valid without expiration.* ☒ *IMPROVEMENT PERMIT w / site plan valid for 60 mos.* ☒ *AUTHORIZATION TO CONSTRUCT valid for period equal to IMPROVEMENT PERMIT-not to exceed 60 mo.*

Owner / Applicant Signature: [signature] Date 6/1/09

Improvement Permit by: [signature] Date 6/1/09

Authorzation to Construct by: [signature] Date 6/1/09

YOU SHOULD CONTACT A LOCATOR SERVICE PRIOR TO ANY EXCAVATION.

Installed by: Rowan Septic

Operation Permit by: [signature] Date: 6/3/09

Existing System Inspected by: — Date: —

WHITE COPY Environmental Health YELLOW COPY (Final) Owner / Applicant PINK COPY (Initial) Owner / Applicant