IREDELL COUNTY HEALTH DEPARTMENT

STATESVILLE 704-878-5305 MOORESVILLE 704-664-5281

IMPROVEMENT PERMIT / AUTHORIZATION TO CONSTRUCT / OPERATION PERMIT / EXISTING SYSTEM INSPECTION

PERMIT# 127707 PIN# ~~4665-30-3345.024~~ 4665-40-9030 DATE 12/10/04

OWNER OR CONTRACTOR HUNTINGTON RIDGE LLC / WILDWIND HOME BUILDERS PHONE: Business 664-4050 Home

ADDRESS 255 ROLLINGHILLS RD MOORESVILLE NC

LOCATION SHEARER'S RD - TR HUNTINGTON RIDGE - 2ND ON RT

SUBDIVISION HUNTINGTON RIDGE BLOCK / SECTION 1 LOT 24 LOT AREA .44 AC SITE CLASS. PS DESIGN FLOW 360GPD L.T.A.R. .3600/FT2

Septic Tank: 1000 Gallons; STB ~~312~~ Date ~~7-31-05~~

Pump Tank: Gallons; PT 312 Date 7-30-05

Pump Make: Model Serial No.

Nitrification Field: No Fields 1 Square Feet 400 Linear Feet 200

No Lines 4 @ 50' Trench Width 24" Max Trench Bottom Depth 36" Gravel Depth N/A

☑ New System ☐ Repair System Type: I, II, III, IV, V, VI

System Description: 60 ANETY PANEL

Repair System Description: LC PANEL

Maintenance Agreement Required: ☐ Yes ☑ No

☑ House/Mod. Home No. Bedrooms 3

☐ Mobile Home No. Bathrooms 3

☐ Business No. Employees

☐ Other


☐ Slab ☑ Crawl Space ☐ Basement w/plumbing ☐ Basement wo/plumbing

Water Supply: ☑ Individual ☐ Public ☐ Community

Comments:/Conditions: Used 36" trenches.

Comments:/Conditions: Installed essentially as Drawn; drive was put on other side of lot.

INITIAL SITE SKETCH 1"=50'

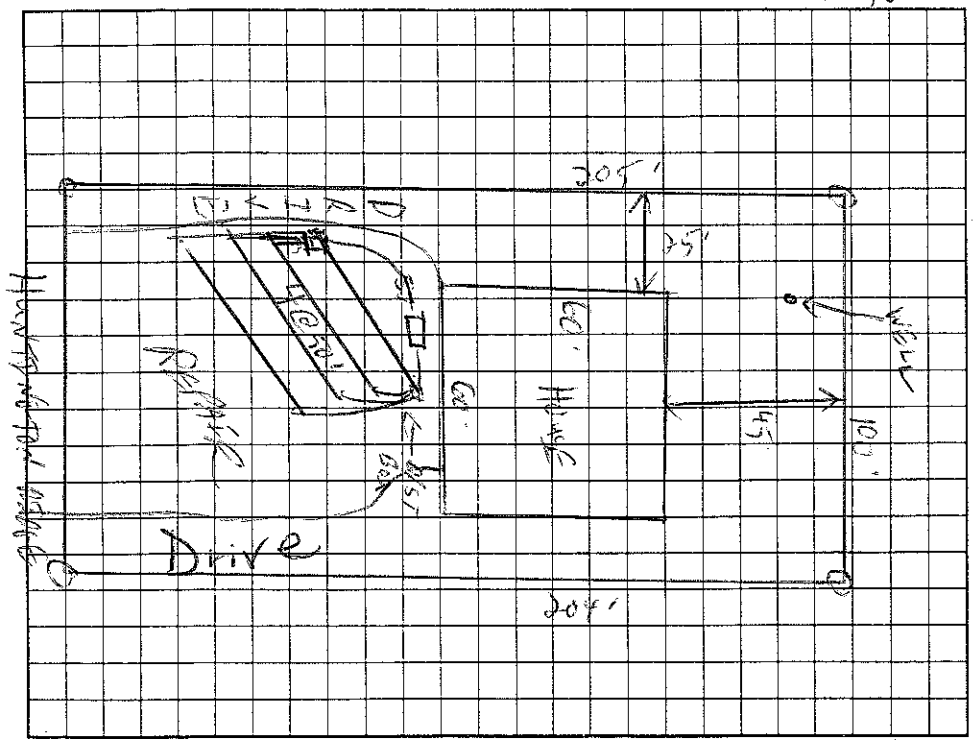

AS BUILT SKETCH

Used 4 speed levelers

Permit can be suspended or revoked if any false information is supplied toward securing the permit/any unauthorized changes are made to the site/any unauthorized changes are made in the installation of the system. Improvement Permit with plat valid without expiration. Improvement Permit with site plan valid for sixty months. Authorization to Construct is valid for a period equal to that of Improvement Permit – not to exceed sixty months.

Signed: date 12/13/04

Improvement Permit by: RS date 12/10/04

Authorization to Construct by: Wesley Sparks RS date 3/11/05

Installed by: EJ Eckard RS

Operation Permit by: Maria H. Dolan date 9/7/05

Existing System Inspection by: date

HEALTH DEPT. COPY: WHITE OWNER COPY (FINAL): YELLOW OWNER COPY (INITIAL): PINK