IREDELL COUNTY HEALTH DEPARTMENT

STATESVILLE 704-878-5305 MOORESVILLE 704-664-5281

#125 2:00

IMPROVEMENT PERMIT / AUTHORIZATION TO CONSTRUCT / OPERATION PERMIT / EXISTING SYSTEM INSPECTION

PERMIT# 1039698 PIN# 4666540430 DATE 1-14-02

OWNER OR CONTRACTOR Scott Watts (Formerly Jerry Cline) PHONE: Business 892-4103 Jerry Home (704) 663-0980 Scott 662-2166

ADDRESS 677 Franklin Grove Dr. Mooresville, NC 28115

LOCATION Shearer's Rd on right before Presbyterian Rd. (beside Grey Doublewide) 1554 Shearer's

SUBDIVISION — BLOCK / SECTION — LOT 2 LOT AREA 1.10 acres SITE CLASS. PS DESIGN FLOW 480gpd L.T.A.R. .3

Septic Tank: 1000 Gallons; STB 1012 Date 3-11-02
Pump Tank: ~~1000~~ Gallons; PT — Date —
Pump Make: — Model — Serial No. —
Nitrification Field: No Fields 1 Square Feet 1260' Linear Feet 420'
No Lines 6 @ 70' Trench Width 36" Max Trench Bottom Depth 30" Gravel Depth N/A

☒ New System ☐ Repair System Type: I, II, III, IV, V, VI
System Description: Gravity – 25% Reduction
Repair System Description: Innovative
Maintenance Agreement Required: ☐ Yes ☒ No

☒ House/Mod. Home ☐ Mobile Home ☐ Business ☐ Other
No. Bedrooms 4 No. Bathrooms 3 No. Employees —


☐ Slab ☒ Crawl Space ☐ Basement w/plumbing ☐ Basement wo/plumbing

Water Supply: ☒ Individual ☐ Public ☐ Community


Comments/Conditions: Keep Septic System at least 10' off PL. Driveway must not cross drainfield

Comments/Conditions: Okay to use "drop boxes" instead of distribution box.
☒ Okay to put ST on other side of house (keep shallow) to keep gravity flow

INITIAL SITE SKETCH Scale 1:40

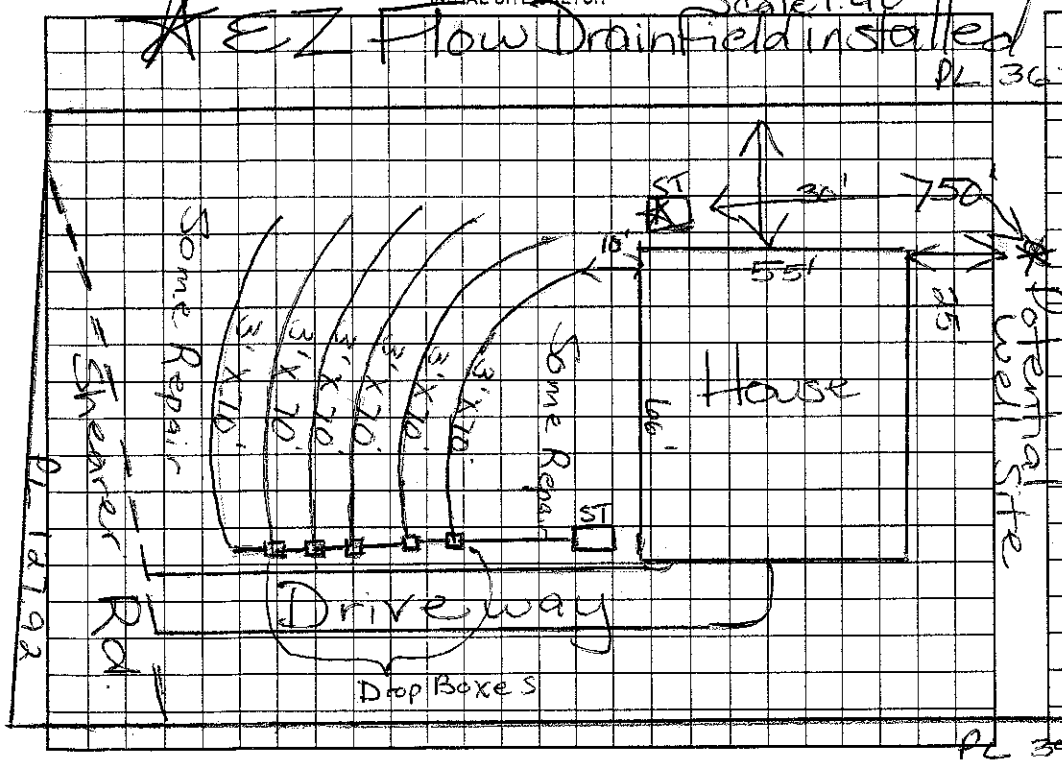

AS BUILT SKETCH

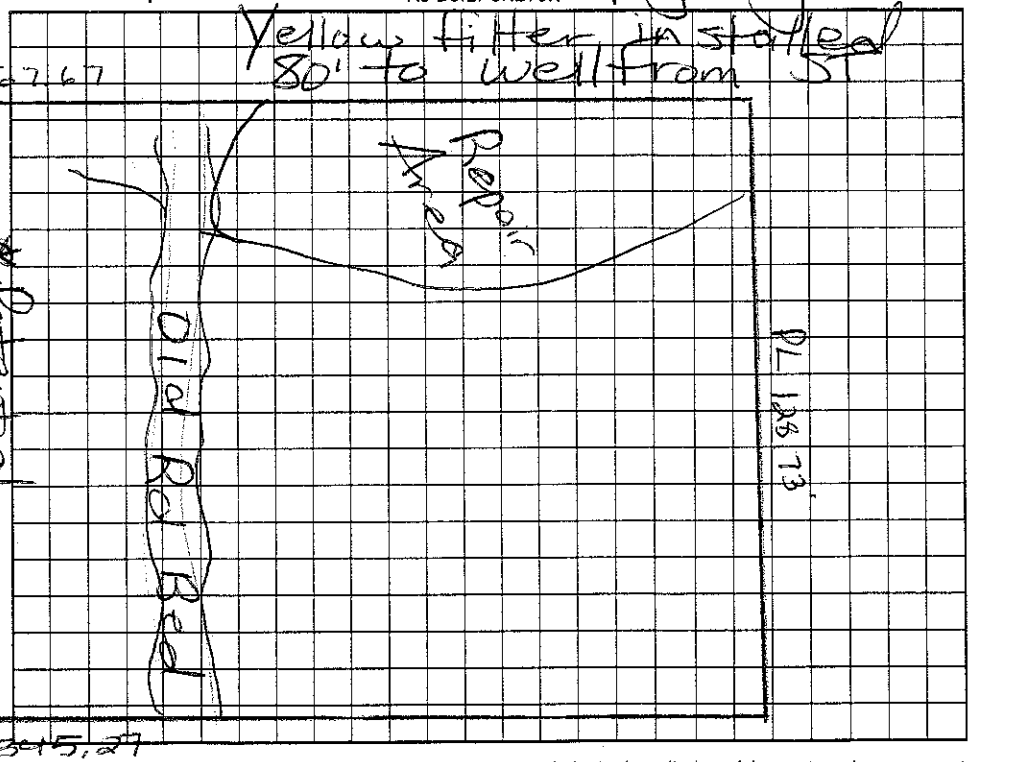

Permit can be suspended or revoked if any false information is supplied toward securing the permit/any unauthorized changes are made to the site/any unauthorized changes are made in the installation of the system. Improvement Permit with plat valid without expiration. Improvement Permit with site plan valid for sixty months. Authorization to Construct is valid for a period equal to that of Improvement Permit – not to exceed sixty months.

Signed: Jeffrey S. Watts date 1/14/02 Installed by: A-1 Backhoe R.S.

Improvement Permit by: Maria H. Dotson R.S. date 1/14/02 Operation Permit by: Maria H. Dotson R.S. date 11/20/02

Authorization to Construct by: Maria H. Dotson R.S. date 1/14/02 Existing System Inspection by: — date —

HEALTH DEPT. COPY: WHITE OWNER COPY (FINAL): YELLOW OWNER COPY (INITIAL): PINK