IREDELL COUNTY HEALTH DEPARTMENT

STATESVILLE 704-878-5305 700.00 Paid MOORESVILLE 704-664-5281

IMPROVEMENT PERMIT / AUTHORIZATION TO CONSTRUCT / OPERATION PERMIT / EXISTING SYSTEM INSPECTION

PERMIT# 13|348 PIN# 4665|31566 5 / 4665 41 5927 DATE 4-4-06

OWNER OR APPLICANT Topaz Development / WINSOR HOMES PHONE: Business 704-564-4680 Home

ADDRESS 19117 Callaway Hills Lane Davidson 28036 / 125 Streamside Pl

LOCATION Shearers Road South TR Streamside Ln on left

SUBDIVISION Creeks Edge BLOCK / SECTION LOT 5 LOT AREA .95 Ac SITE CLASS PS DESIGN FLOW 360gpd L.T.A.R. .25 gpd/ft²

Septic Tank: 1000 Gallons; STB 524 Date 2/05

Pump Tank: 1000 Gallons; PT 27 Date 9/30/06

Pump Make: Myers Model ME-503-21 Serial No.

Nitrification Field: No Fields 1 Square Feet 1440 Linear Feet 240

No Lines 3@80' Trench Width 24" Max Trench Bottom Depth 36" Gravel Depth NA

☒ New System ☐ Repair ☐ Expansion System Type: I II III (IV) V VI

System Description: LP Panel

Repair System Description: 25% reduction, 24" depth Pump

Maintenance Agreement Required: ☒ Yes ☐ No

☒ House/Mod. Home No. Bedrooms 3

☐ Mobile Home No. Persons

☐ Business No. Employees

☐ Other

Water Supply: ☒ Individual ☐ Public ☐ Community


☐ Gravity ☒ Pressure ☐ Slab ☒ Crawl Space ☐ Basement w/plumbing ☐ Basement wo/plumbing

Comments/Conditions:

54 Panels


Shave berm in system area

INITIAL SITE SKETCH

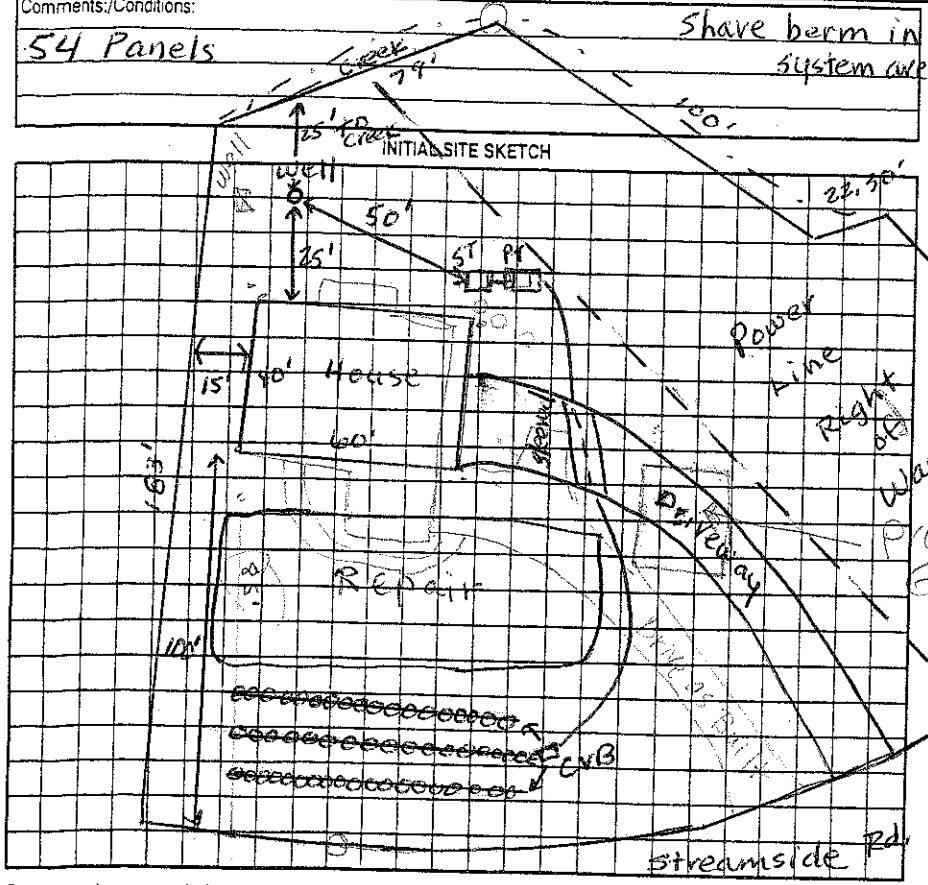

Comments/Conditions: System used but never completed. Pressure checked - all parts working properly at time of inspection.

AS BUILT SKETCH

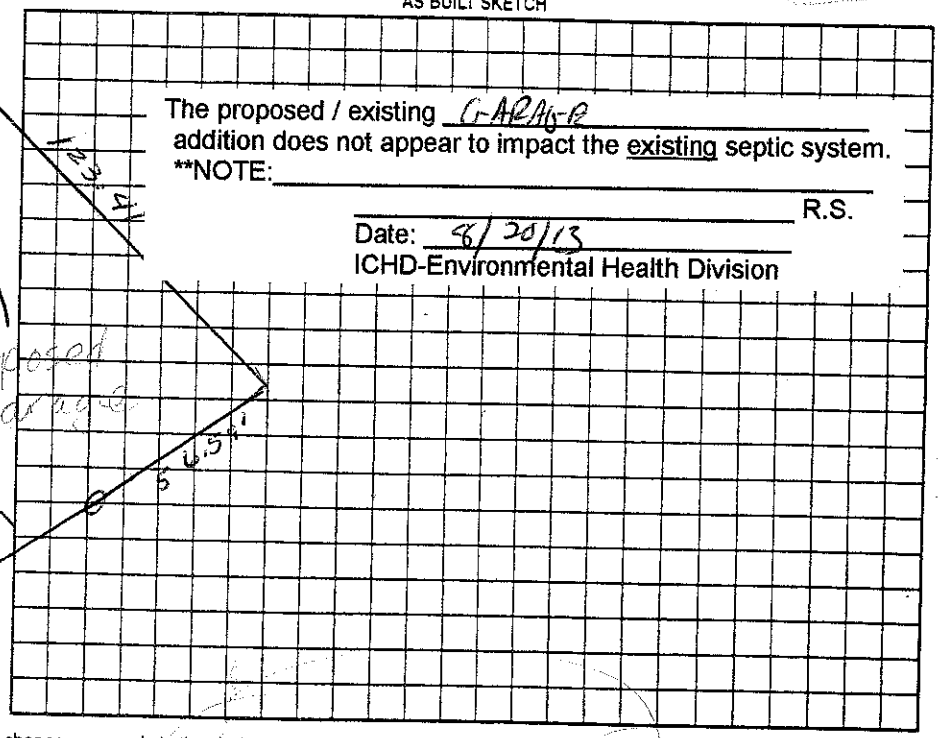

The proposed / existing C-ARAG-P addition does not appear to impact the existing septic system.

**NOTE:

R.S.

Date: 8/20/13

ICHD-Environmental Health Division

Permit can be suspended or revoked if any false information is supplied toward securing the permit/any unauthorized changes are made to the site/any unauthorized changes are made in the installation of the system. Improvement Permit with plat valid without expiration ☐ Improvement Permit with site plan valid for sixty months ☒ Authorization to Construct is valid for a period equal to that of Improvement Permit – not to exceed sixty months.

Signed: Carla Lyon date 4.6.06

Improvement Permit by: Judy Melvill date 4-4-06

Authorization to Construct by: Wesley Sparks R.S. date 9/13/06

Installed by: Plumbing Artist Inc

Operation Permit by: C. [illegible] date 8/20/13

Existing System Inspection by: date

HEALTH DEPT. COPY: WHITE OWNER COPY (FINAL): YELLOW OWNER COPY (INITIAL): PINK