IREDELL COUNTY HEALTH DEPARTMENT

STATESVILLE 704-878-5305 700.00 Paid MOORESVILLE 704-664-5281

IMPROVEMENT PERMIT / AUTHORIZATION TO CONSTRUCT / OPERATION PERMIT / EXISTING SYSTEM INSPECTION

PERMIT# 131347 PIN# 4665 31 5665.004 / 4665 41 7901 DATE 4/17/06

OWNER OR APPLICANT Topsy Development PHONE: Business 704-564-4680 Home

ADDRESS 19117 Caldwell Holly Ln. Davidson, NC 28036 119 STREAMSIDE

LOCATION Sheppard Rd TR Streamside Ln. 4 lot on (L)

SUBDIVISION Creeks Edge BLOCK / SECTION LOT 3/4 LOT AREA ~.6 SITE CLASS. PS DESIGN FLOW 360 L.T.A.R. .25

Septic Tank: 1000 Gallons; STB 794 Date

Pump Tank: 1000 Gallons; PT Date 6-6-06

Pump Make: Model Serial No.

Nitrification Field: No Fields 1 Square Feet 480 Linear Feet 240

No Lines 3@80 Trench Width 2' Max Trench Bottom Depth 32" Gravel Depth No ☐ Gravity ☒ Pressure ☐ Slab ☒ Crawl Space ☒ Basement w/plumbing ☐ Basement wo/plumbing

☒ New System ☐ Repair ☐ Expansion System Type: I II III (IV) V VI

System Description: LP - 16" PPBPS

Repair System Description: SAME

Maintenance Agreement Required: ☒ Yes ☐ No

☒ House/Mod. Home No. Bedrooms 3

☐ Mobile Home No. Persons

☐ Business No. Employees

☐ Other

Water Supply: ☒ Individual ☐ Public ☐ Community NEW


Comments:/Conditions:

Comments:/Conditions:


9-7-06 No Date on ST
ST 60' from well
2 lines checked

1" = 60'

INITIAL SITE SKETCH

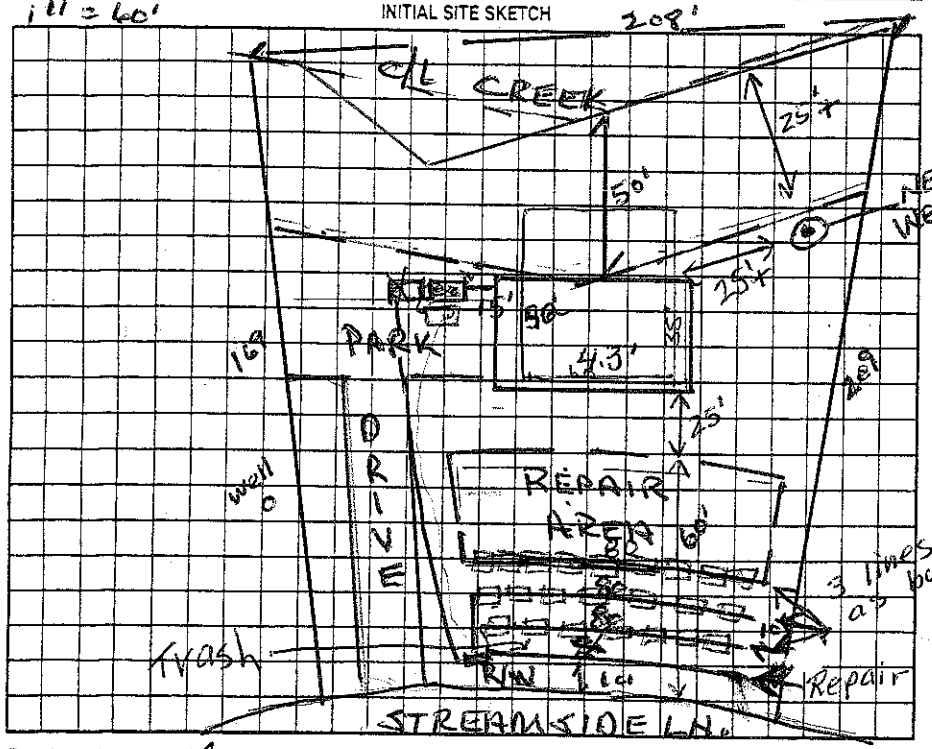

AS BUILT SKETCH

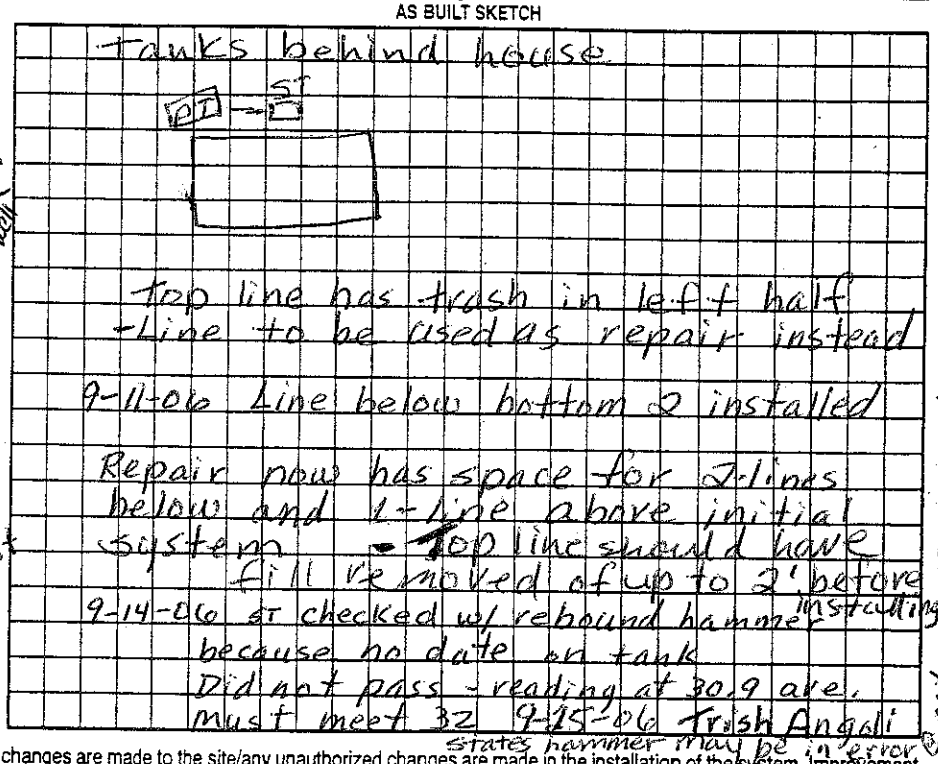

Permit can be suspended or revoked if any false information is supplied toward securing the permit/any unauthorized changes are made to the site/any unauthorized changes are made in the installation of the system. Improvement Permit with plat valid without expiration ☐ Improvement Permit with site plan valid for sixty months ☐ Authorization to Construct is valid for a period equal to that of Improvement Permit – not to exceed sixty months.

Signed: X date 4/17/06 Installed by: Stanley Septic

Improvement Permit by: Wendy Sparks RS. date 4/17/06 Operation Permit by: Judy Mulvihill date 10-18-06

Authorization to Construct by: Wendy Sparks RS date 4/17/06 Existing System Inspection by: date

HEALTH DEPT. COPY: WHITE OWNER COPY (FINAL): YELLOW OWNER COPY (INITIAL): PINK