IREDELL COUNTY HEALTH DEPARTMENT

IMPROVEMENT PERMIT / AUTHORIZATION TO CONSTRUCT / OPERATION PERMIT / EXISTING SYSTEM INSPECTION

STATESVILLE 704-878-5305 MOORESVILLE 704-664-5281

700.00 Paid

PERMIT# 131347 PIN# 4665 31 5665.004 / 4665 41 7901

OWNER OR APPLICANT Topsy Development PHONE: Business 704-564-4680 Home

ADDRESS 19117 Calfayan Hall Ln. Davidson, NC 28036 DATE 4/17/06

LOCATION Stevens Rd TR Streamside Ln. 4 lot on (L) 119 STREAMSIDE

SUBDIVISION Creeks Edge BLOCK / SECTION LOT 3/4 LOT AREA ~2.6 SITE CLASS PS DESIGN FLOW 360 L.T.A.R. .25

Septic Tank: 1000 Gallons; STB 794 Date

Pump Tank: 1000 Gallons; PT Date 6-6-06

Pump Make: Model Serial No.

Nitrification Field: No Fields 1 Square Feet 480 Linear Feet 240

No Lines 3@8' Trench Width 2' Max Trench Bottom Depth 32"

☒ New System ☐ Repair ☐ Expansion System Type: I II III IV V VI

System Description: LP - 16" PPBPS

Repair System Description: SAME

Maintenance Agreement Required: ☒ Yes ☐ No

Gravel Depth No ☐ Gravity ☒ Pressure ☐ Slab ☒ Crawl Space ☒ Basement w/plumbing ☐ Basement wo/plumbing

☒ House/Mod. Home ☐ Mobile Home ☐ Business ☐ Other


No. Bedrooms 3 No. Persons No. Employees

Water Supply: ☒ Individual ☐ Public ☐ Community NEW

Comments:/Conditions:

1" = 60'


INITIAL SITE SKETCH

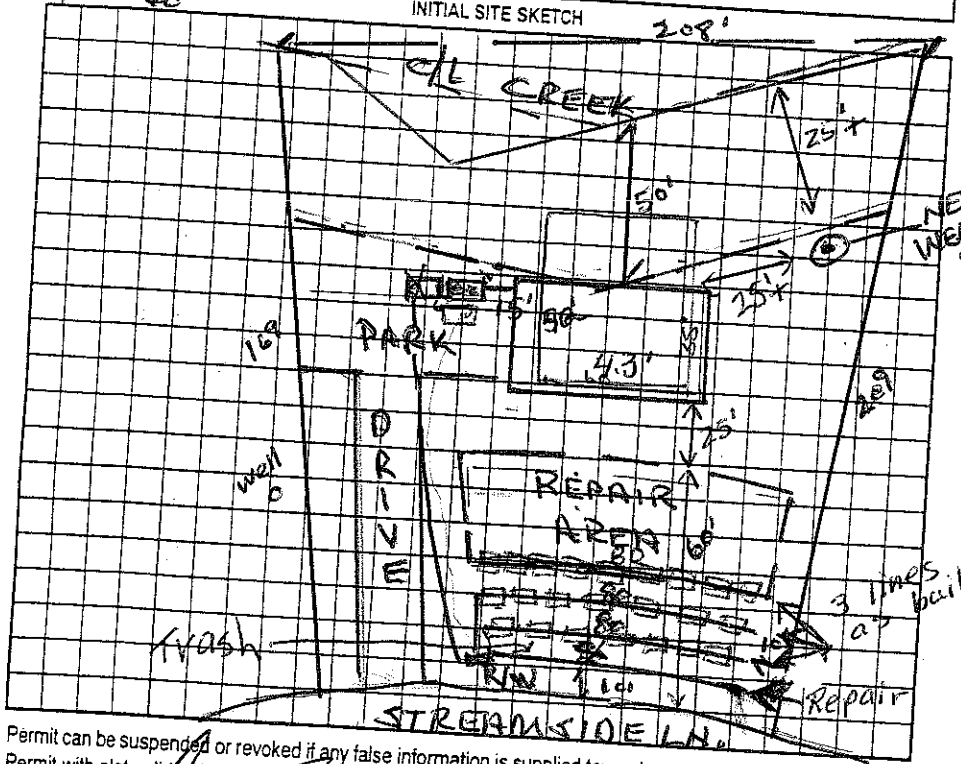

Comments:/Conditions:

9-7-06 No Date on ST
ST 60' from well
2 lines checked

AS BUILT SKETCH

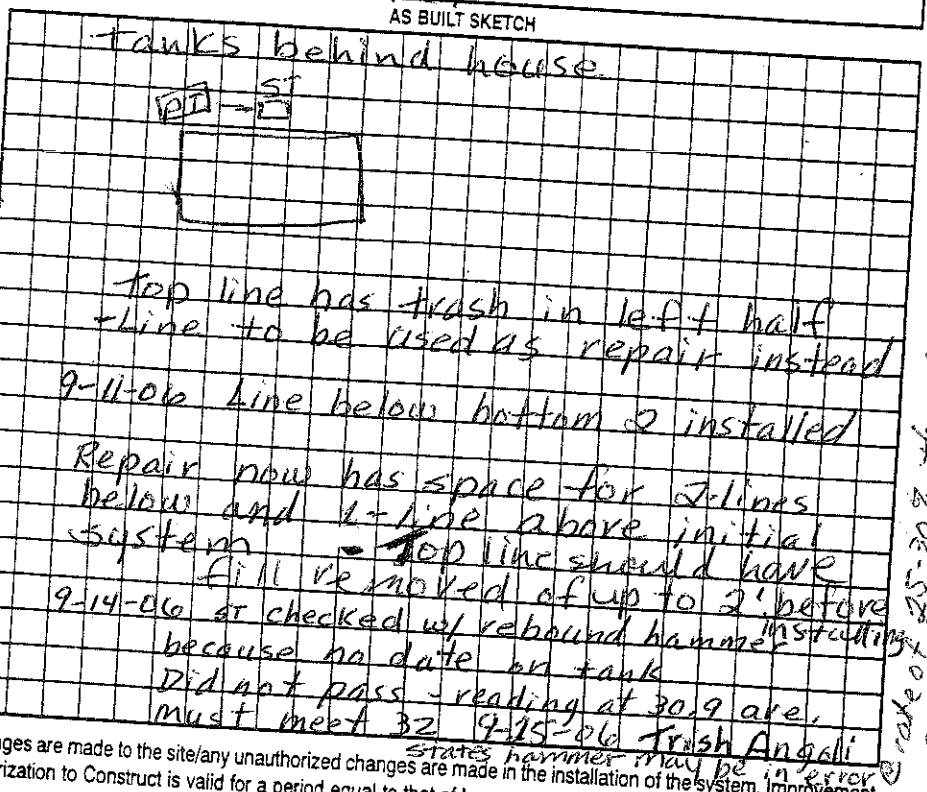

Top line has trash in left half
+Line to be used as repair instead
9-11-06 Line below bottom ② installed
Repair now has space for 2 lines below and 1 line above initial system - top line should have fill removed of up to 2' before installing
9-14-06 ST checked w/ rebound hammer because no date on tank
Did not pass 1 reading at 30.9 are.
Must meet 32 9-15-06 Trish Angeli
States hammer may be in error
a rake of 25-30 therefore a reading of 29 passes

Permit can be suspended or revoked if any false information is supplied toward securing the permit/any unauthorized changes are made to the site/any unauthorized changes are made in the installation of the system. Improvement Permit with plat valid without expiration ☐ Improvement Permit with site plan valid for sixty months ☐ Authorization to Construct is valid for a period equal to that of Improvement Permit – not to exceed sixty months.

Signed: X date 4/17/06

Improvement Permit by: Wesley Sparks RS. date 4/17/06

Authorization to Construct by: Wesley Sparks RS date 4/17/06

Installed by: Stanley Septic

Operation Permit by: Johnny Mulvihill date 10-18-06

Existing System Inspection by: date

HEALTH DEPT. COPY: WHITE OWNER COPY (FINAL): YELLOW OWNER COPY (INITIAL): PINK