IREDELL COUNTY HEALTH DEPARTMENT

STATESVILLE 704-878-5305 MOORESVILLE 704-664-5281

IMPROVEMENT PERMIT / AUTHORIZATION TO CONSTRUCT / OPERATION PERMIT / EXISTING SYSTEM INSPECTION

PERMIT# 13153 PIN# 4666531566 65 / 4665418848 DATE 5-11-06

OWNER OR APPLICANT Robinson Builders PHONE: Business 704-361-7347 Home

ADDRESS 1503 Burning Lantern Kannapolis 28081

LOCATION Sheavers Rd TR Streamside Ln on left 115 STREAMSIDE PL.

SUBDIVISION Creeks Edge BLOCK / SECTION LOT 2 LOT AREA SITE CLASS. PS DESIGN FLOW 360gpd L.T.A.R. .25 gpd/ft²

Septic Tank: 1000 Gallons: STB 350 Date 7-26-06
Pump Tank: 1000 Gallons: PT 318 Date 2-3-06
Pump Make: Zoeller Model N153 Serial No.
Nitrification Field: No Fields 1 Square Feet 1440 Linear Feet 240
No Lines 5 Trench Width 24" Max Trench Bottom Depth 36" Gravel Depth NA ☐ Gravity ☒ Pressure

☒ New System ☐ Repair ☐ Expansion System Type: I II III IV V VI
System Description: LP PPBPS
Repair System Description: LPPPBPS
Maintenance Agreement Required: ☒ Yes ☐ No

☒ House/Mod. Home No. Bedrooms 3
☐ Mobile Home No. Persons
☐ Business No. Employees
☐ Other

Water Supply: ☒ Individual ☐ Public ☐ Community

☐ Slab ☒ Crawl Space ☐ Basement w/plumbing ☐ Basement wo/plumbing


HP 5

Comments/Conditions: Place well 25'+ from house & 50'+ from septic system
56 panels

Comments/Conditions:
Red poly loc filter
ST 5' from house near electric box
89 ll to inlet from house

1"=50'

INITIAL SITE SKETCH

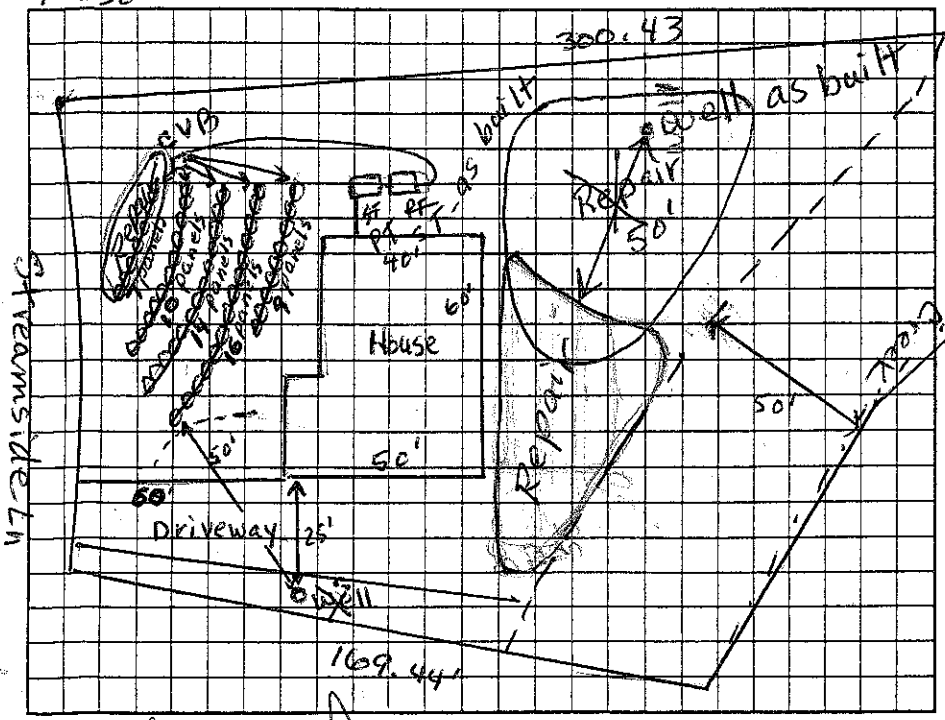

AS BUILT SKETCH

As built:
4 lines @ 60'

1 line above towards road is now repair

New repair area in back of house because of well location
*Check location of water line from well to house before installing repair

Permit can be suspended or revoked if any false information is supplied toward securing the permit/any unauthorized changes are made to the site/any unauthorized changes are made in the installation of the system. Improvement Permit with plat valid without expiration ☐ Improvement Permit with site plan valid for sixty months ☒ Authorization to Construct is valid for a period equal to that of Improvement Permit – not to exceed sixty months.

Signed: date 5/12/06 Installed by: Piedmont Septic Randy Melton

Improvement Permit by: Judy Melville date 5-11-06 Operation Permit by: Judy Melville date 10-23-06

Authorization to Construct by: Judy Melville date 5-12-06 Existing System Inspection by: date

HEALTH DEPT. COPY: WHITE OWNER COPY (FINAL): YELLOW OWNER COPY (INITIAL): PINK