2:30-3:00

IREDELL COUNTY HEALTH DEPARTMENT

STATESVILLE 704-878-5305 MOORESVILLE 704-664-5281

IMPROVEMENT PERMIT / AUTHORIZATION TO CONSTRUCT / OPERATION PERMIT / EXISTING SYSTEM INSPECTION

PERMIT# 078358 PIN# 4665 42 0048 DATE 1/5/99

OWNER OR CONTRACTOR Donald Erwin PHONE: Business Home 663-7747

ADDRESS 143 Wildwood Acres Dr. Mooresville, NC. 28115

LOCATION Shearers Rd (S) TR Wildwood Acres Dr. 2ND on (L) before Power Lines

SUBDIVISION Wildwood Acres BLOCK / SECTION LOT 5 LOT AREA 1.61AC SITE CLASS PS DESIGN FLOW 360 L.T.A.R. .275

Septic Tank: 1000 Gallons; STB 794 Date 12/6/98

Pump Tank: Gallons; PT Date

Pump Make: Model Serial No.

Nitrification Field: No Fields 1 Square Feet 981 Linear Feet 327

No Lines 4 Trench Width 36" Max Trench Bottom Depth 30" Gravel Depth SAND

[X] New System [ ] Repair System Type: I, II, [III], IV, V, VI

System Description: HDS or CH Plastic *

Repair System Description: 16" APBS

Maintenance Agreement Required: [ ] Yes [ ] No

[ ] House/Mod. Home No. Bedrooms 3

[X] Mobile Home No. Bathrooms 2

[ ] Business No. Employees

[ ] Other

[ ] Slab [X] Crawl Space [ ] Basement w/plumbing [ ] Basement wo/plumbing


Water Supply: [X] Individual [ ] Public [ ] Community DERwin

Comments:/Conditions: * 25% reduction calculated - Install what's specified on this permit.


Comments:/Conditions:

POLYLOCK FILTER

INITIAL SITE SKETCH

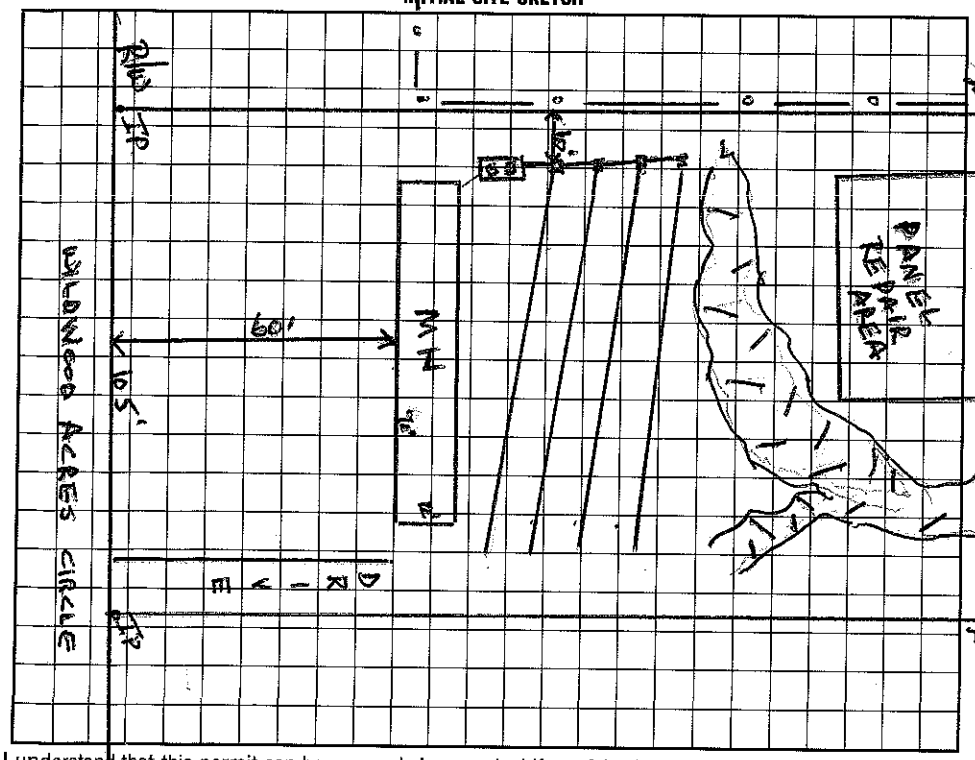

AS BUILT SKETCH (1"=40')

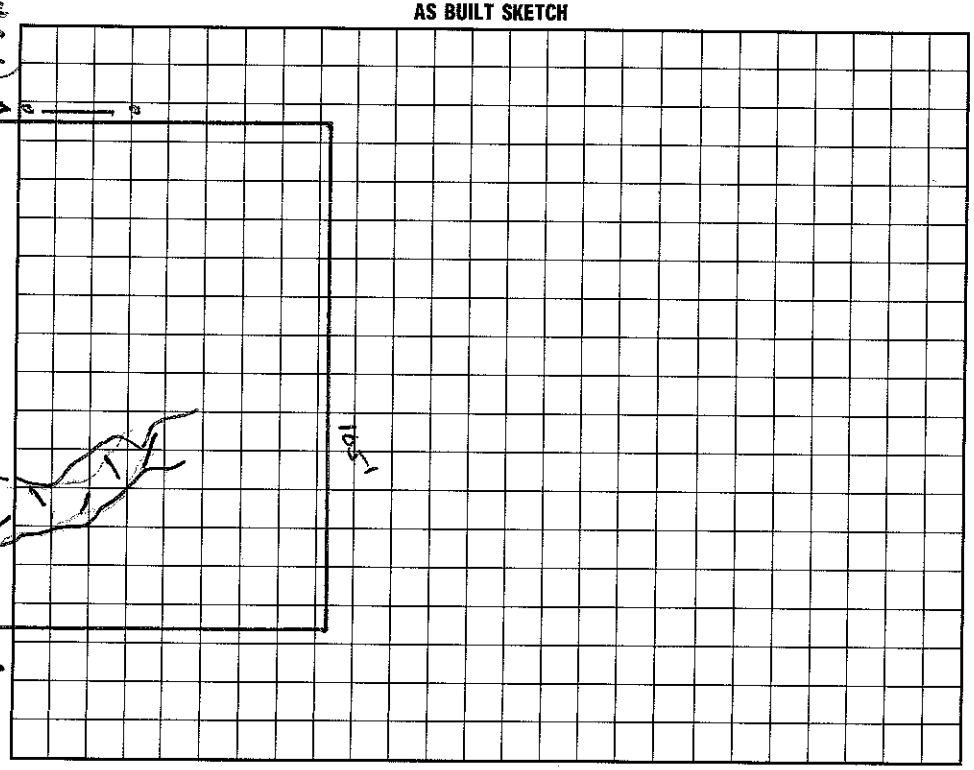

I understand that this permit can be suspended or revoked if any false information is supplied toward securing the permit/any unauthorized changes are made to the site/any unauthorized changes are made in the installation of the system. Improvement Permit with plat valid without expiration. Improvement Permit with site plan valid for sixty months. Authorization to Construct is valid for a period equal to that of Improvement Permit – not to exceed sixty months.

Signed: * Donald H. Erwin date 1-8-99

Improvement Permit by: Wesley Sparks R.S. date 1/5/99

Authorization to Construct by: Wesley Sparks R.S. date 1/5/99

Installed by: FS Elvin

Operation Permit by: C. [illegible] date 1/21/99

Existing System Inspection by: date

HEALTH DEPT. COPY: WHITE INSPECTION COPY (FINAL): GREEN OWNER COPY (FINAL): YELLOW INSPECTION COPY (INITIAL): PINK OWNER COPY (INITIAL): GOLD