(10:30 - 11:00)

IREDELL COUNTY HEALTH DEPARTMENT

STATESVILLE 704-878-5305 MOORESVILLE 704-664-5281

IMPROVEMENT PERMIT / AUTHORIZATION TO CONSTRUCT / OPERATION PERMIT / EXISTING SYSTEM INSPECTION

PERMIT# 74874 PIN# 4665421702 4665420781 DATE 3/3/99

OWNER OR CONTRACTOR McKNIGHT ENTERPRISES PHONE: Business Home 664-9080

ADDRESS 255 ROLLING HILLS RD - MOORESVILLE NC 28115

LOCATION SHEARERS RD TR ASHLEY WOODS - TL KNIGHT N GALE - ON RT 110 Knight N Gail Dr

SUBDIVISION ASHLEY WOODS BLOCK / SECTION LOT 37 LOT AREA .61AC SITE CLASS. PS DESIGN FLOW 360GPD L.T.A.R. .30 PD/FT

Septic Tank: 1000 Gallons; STB 1012 Date 4/8/99

Pump Tank: Gallons; PT 47 Date 2/14/99

Pump Make: Model Serial No.

Nitrification Field: No Fields 1 Square Feet 400 Linear Feet 200

No Lines 4@50' Trench Width 24" Max Trench Bottom Depth 36" Gravel Depth N/A

☑ New System ☐ Repair System Type: I, II, III, IV, V, VI

System Description: PUMP PANEL

Repair System Description: SAME

Maintenance Agreement Required: ☐ Yes ☑ No

☐ House/Mod. Home ☑ Mobile Home ☐ Business ☐ Other

No. Bedrooms 3 No. Bathrooms 2 No. Employees


☐ Slab ☑ Crawl Space ☐ Basement w/plumbing ☐ Basement wo/plumbing

Water Supply: ☐ Individual ☐ Public ☑ Community


Comments:/Conditions:

Comments:/Conditions:

INITIAL SITE SKETCH 1"=50'

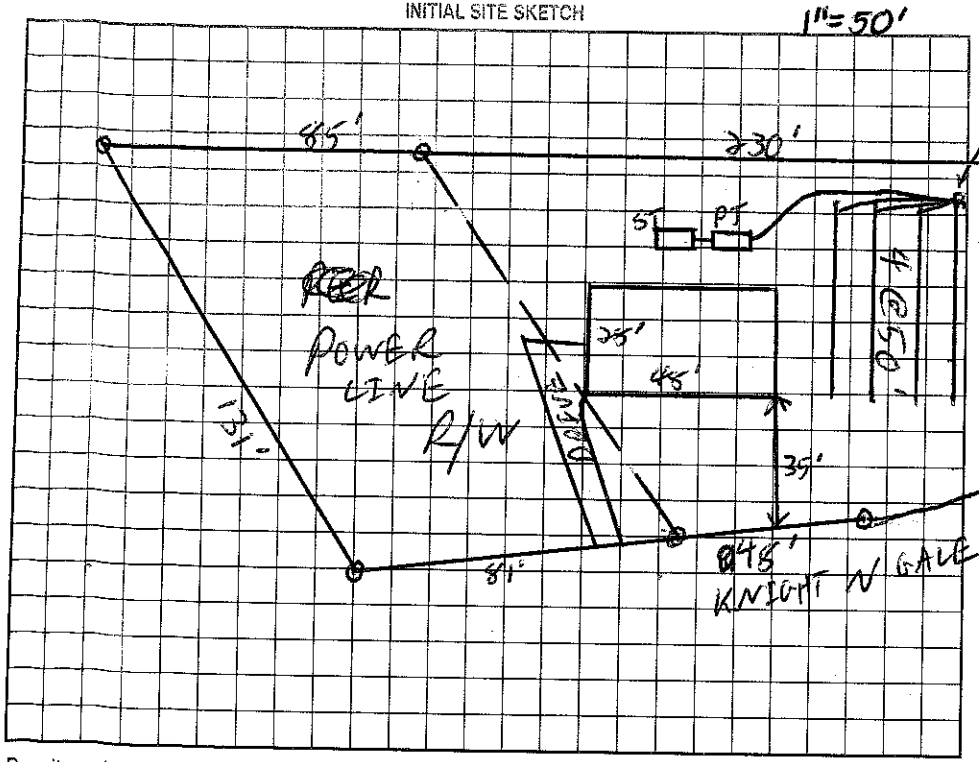

AS BUILT SKETCH

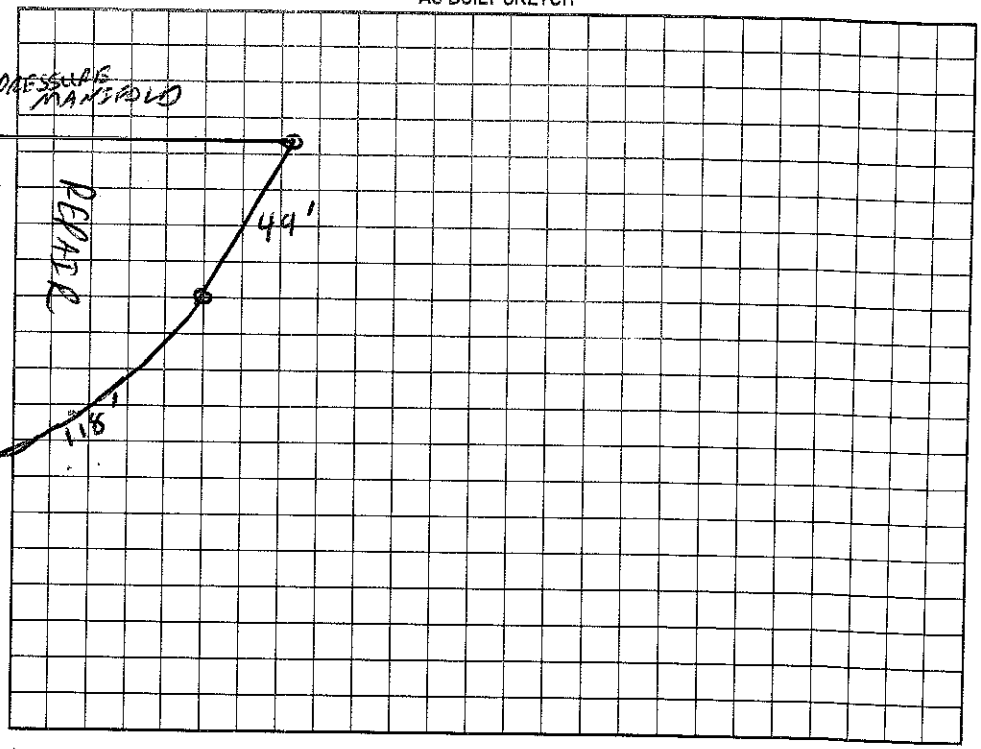

Permit can be suspended or revoked if any false information is supplied toward securing the permit/any unauthorized changes are made to the site/any unauthorized changes are made in the installation of the system. Improvement Permit with plat valid without expiration. Improvement Permit with site plan valid for sixty months. Authorization to Construct is valid for a period equal to that of Improvement Permit – not to exceed sixty months.

Signed: Craig Shipley date 4.9.99

Improvement Permit by: C. Shipley Trainee RS date 3/3/99

Authorization to Construct by: C. Shipley Trainee RS date 3/3/99

Installed by: A1 BACKHOE

Operation Permit by: C. Shipley RS date 7/29/99

Existing System Inspection by: date

HEALTH DEPT. COPY: WHITE OWNER COPY (FINAL): YELLOW OWNER COPY (INITIAL): PINK