IREDELL COUNTY HEALTH DEPARTMENT

STATESVILLE 704-878-5305 MOORESVILLE 704-664-5281

IMPROVEMENT PERMIT / AUTHORIZATION TO CONSTRUCT / OPERATION PERMIT / EXISTING SYSTEM INSPEC

PERMIT# 072477 PIN# 4665420851 DATE 4/28/98

OWNER OR CONTRACTOR JAMES McKNIGHT PHONE: Business 664-9080 Home

ADDRESS 255 ROLLING HILLS RD MOORESVILLE NC 28115

LOCATION SHEARERS RD - TR ASHLEY WOODS - ON CORNER AT FORK

SUBDIVISION ASHLEY WOODS BLOCK / SECTION LOT 28 LOT AREA SITE CLASS. PS DESIGN FLOW 360 GPD L.T.A.R. .3 GPD/FT2

Septic Tank: 1000 Gallons; STB 1012 Date 3/16/98
Pump Tank: Gallons; PT Date
Pump Make: Model Serial No.
Nitrification Field: No Fields 1 Square Feet 900 Linear Feet 300
No Lines 5@60' Trench Width 36" Max Trench Bottom Depth 36" Gravel Depth N/A

☑ New System ☐ Repair System Type: I, II, III, IV, V, VI
System Description: GRAVITY CHAMBERED ORDS
Repair System Description: PUMP PANEL
Maintenance Agreement Required: ☐ Yes ☑ No


☐ House/Mod. Home No. Bedrooms 3
☑ Mobile Home No. Bathrooms 2
☐ Business No. Employees
☐ Other
☐ Slab ☑ Crawl Space ☐ Basement w/plumbing ☐ Basement wo/plumbing

Water Supply: ☐ Individual ☐ Public ☑ Community


Comments:/Conditions:

Comments:/Conditions:

INITIAL SITE SKETCH 1"=50'

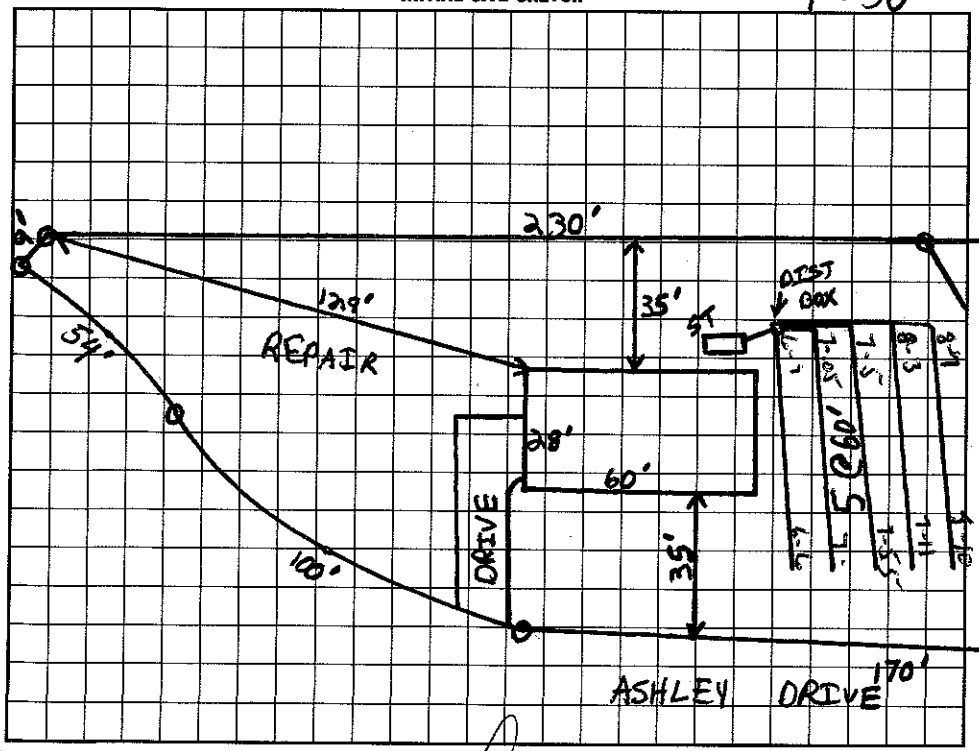

AS BUILT SKETCH

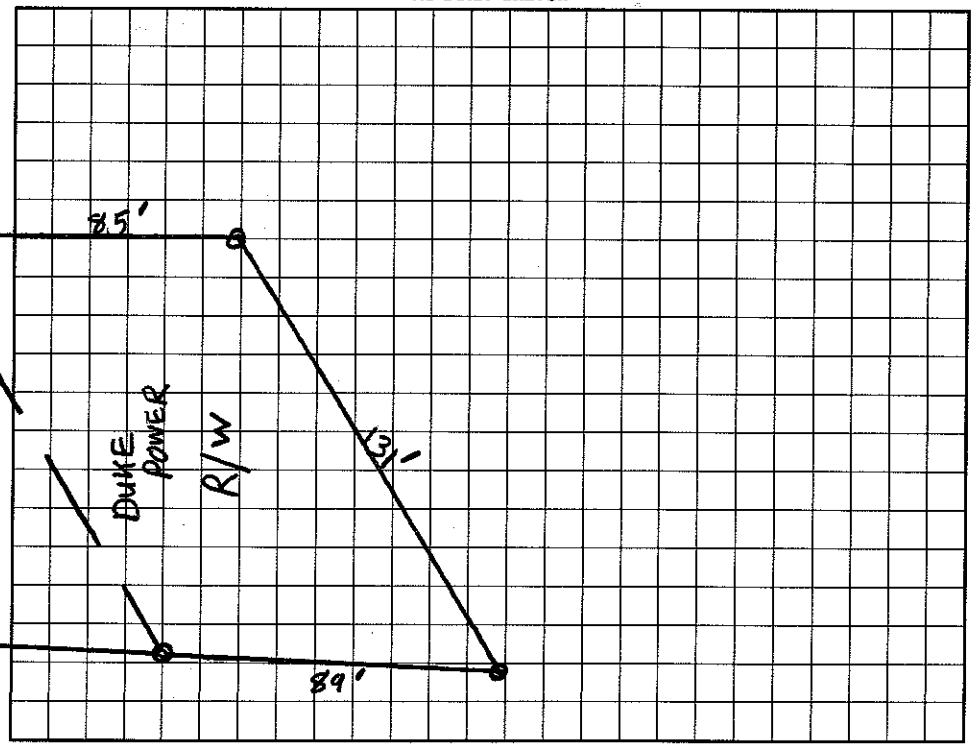

I understand that this permit can be suspended or revoked if any false information is supplied toward securing the permit/any unauthorized changes are made to the site/any unauthorized changes are made in the installation of the system. Improvement Permit with plat valid without expiration. Improvement Permit with site plan valid for sixty months. Authorization to Construct is valid for a period equal to that of Improvement Permit – not to exceed sixty months.

Signed: date 4-29-98 Installed by: A-1 Backhoe

Improvement Permit by: date 4/28/98 Operation Permit by: Wesley Sparks RS date 5/19/98

Authorization to Construct by: date 4/28/98 Existing System Inspection by: Wesley Sparks RS date 5/19/98

HEALTH DEPT. COPY: WHITE INSPECTION COPY (FINAL): GREEN OWNER COPY (FINAL): YELLOW INSPECTION COPY (INITIAL): PINK OWNER COPY (INITIAL): GOLD