IREDELL COUNTY HEALTH DEPARTMENT

STATESVILLE 704-878-5305 MOORESVILLE 704-664-5281

IMPROVEMENT PERMIT / CERTIFICATE OF COMPLETION / OPERATION PERMIT / EXISTING SYSTEM INSPECTION

PROPERTY DESCRIPTION NO. D67419 DATE 12/10/97 TAX MAP NO. 466 553 7455 42 0996 Watershed: ☐ Yes ☐ No

OWNER OR CONTRACTOR James McKnight PHONE: Business 664-9080 Home

ADDRESS 255 Rolling Hills Rd Mooresville, NC 28115

LOCATION 1155 TR Shearer Rd on Right after Rocky River TR Ashley Woods Dr

SUBDIVISION Ashley Woods BLOCK / SECTION LOT 16 LOT AREA .45 Acres SITE CLASS. PS DESIGN FLOW 360 gpd L.T.A.R. .3

Septic Tank: 1000 Gallons; STB 1012 Date 3/16/98

Pump Tank: Gallons; PT Date

Pump Make: Model Serial No.

Nitrification Field: No Fields 1 Square Feet* 900 Linear Feet* 360

No Lines 6 at 50' Trench Width 36" Max Trench Bottom Depth 36" Gravel Depth N/A

☒ New System ☐ Repair System Type: I, II, (III), IV, V, VI

System Description: Geo-Plastic Chamber or Similar

Repair System Description: Same

Maintenance Agreement Required: ☐ Yes ☒ No

☐ House/Mod. Home ☒ Mobile Home ☐ Business ☐ Other

No. Bedrooms 3 No. Bathrooms 2 No. Employees


☐ Slab ☐ Crawl Space ☐ Basement w/plumbing ☐ Basement wo/plumbing

Water Supply: ☐ Individual ☒ Community ☐ Public

Comments: * 25% reduction of Septic System
* Install inspection ports near end of each lateral

Comments:

INITIAL SITE SKETCH Scale 1:50

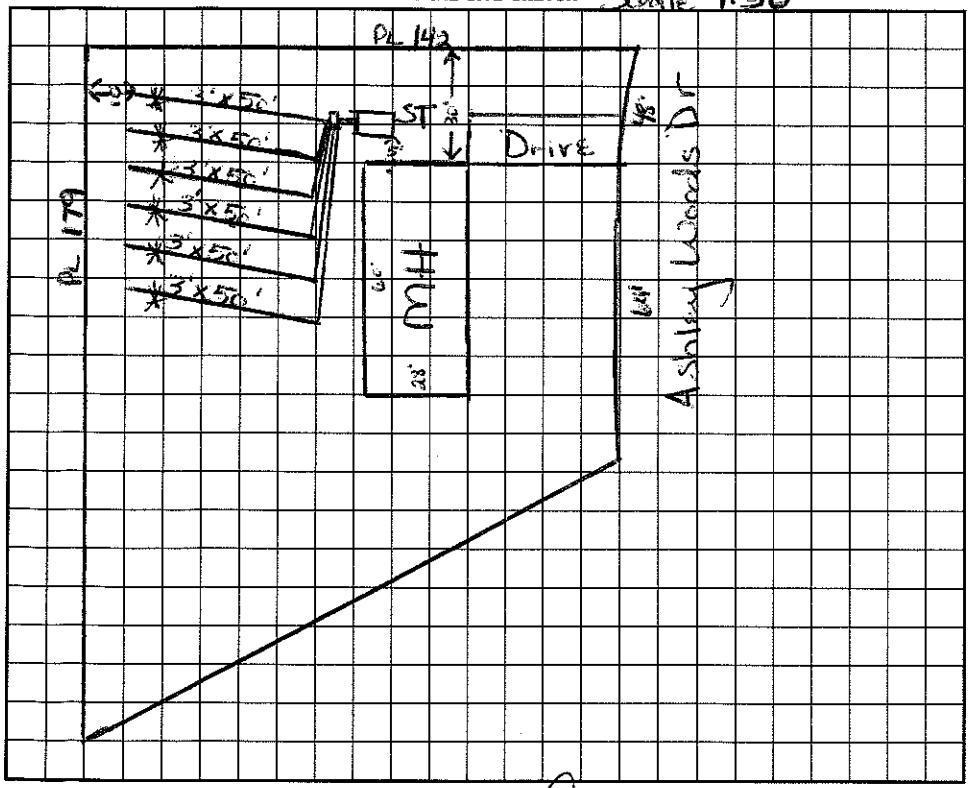

AS BUILT SKETCH

I understand that this permit can be suspended or revoked if any false information is supplied toward securing the permit/any unauthorized changes are made to the site/any unauthorized changes are made in the installation of the system. Improvement Permit is valid for 60 months from date of issuance.

Signed: [signature] 4-29-98

Improvement Permit by: Maina H. Dotson date 1/6/98

~~Existing System~~ Inspection by: Maina H. Dotson date 1/6/98

Installed by: A-1 Backhoe

Certificate of Completion by: Wesley Sparks RS. date 5/18/98

Operation Permit by: Wesley Sparks RS. date 5/18/98

HEALTH DEPT COPY: WHITE INSPECTION COPY (FINAL): GREEN OWNER COPY (FINAL): YELLOW INSPECTION COPY (INITIAL): PINK OWNER COPY (INITIAL): GOLD

Construct Auth