IREDELL COUNTY HEALTH DEPARTMENT

AUTHORIZATION TO CONSTRUCT

STATESVILLE 704-878-5305 MOORESVILLE 704-664-5281

IMPROVEMENT PERMIT / ~~CERTIFICATE OF COMPLETION~~ / OPERATION PERMIT / EXISTING SYSTEM INSPECTION

PROPERTY DESCRIPTION NO. 26215 DATE 4/2/97 TAX MAP NO. 4665422484 Watershed: ☐ Yes ☑ No

OWNER OR CONTRACTOR KEN NIEISWONGER PHONE: Business 4605422412 Home 664-4297

ADDRESS MOORESVILLE NC

LOCATION SHEARERS CHAPEL RD - TR WILDWOOD ACRES - 3RD LOT ON RT

SUBDIVISION WILDWOOD ACRES BLOCK / SECTION ____ LOT 27-B LOT AREA ____ SITE CLASS. PS DESIGN FLOW 360GPD L.T.A.R. 360/FT²

Septic Tank: 1000 Gallons; STB 794 Date 12-11-96

Pump Tank: ____ Gallons; PT ____ Date ____

Pump Make: ____ Model ____ Serial No. ____

Nitrification Field: No Fields 1 Square Feet 600 Linear Feet 200

No Lines 5 Trench Width 24" Max Trench Bottom Depth 36" Gravel Depth 1/4

☑ New System ☐ Repair System Type: I, II, ☑ III, IV, V, VI

System Description: GRAVITY PANEL

Repair System Description: PUMP OFF-SITE PANEL

Maintenance Agreement Required: ☐ Yes ☑ No

☐ House/Mod. Home ☑ Mobile Home ☐ Business ☐ Other

No. Bedrooms 3 No. Bathrooms 2 No. Employees ____


☐ Slab ☑ Crawl Space ☐ Basement w/plumbing ☐ Basement wo/plumbing

Water Supply: ☑ Individual ☐ Community ☐ Public


Comments:

Comments: Installed as drawn.

INITIAL SITE SKETCH 1" = 50'

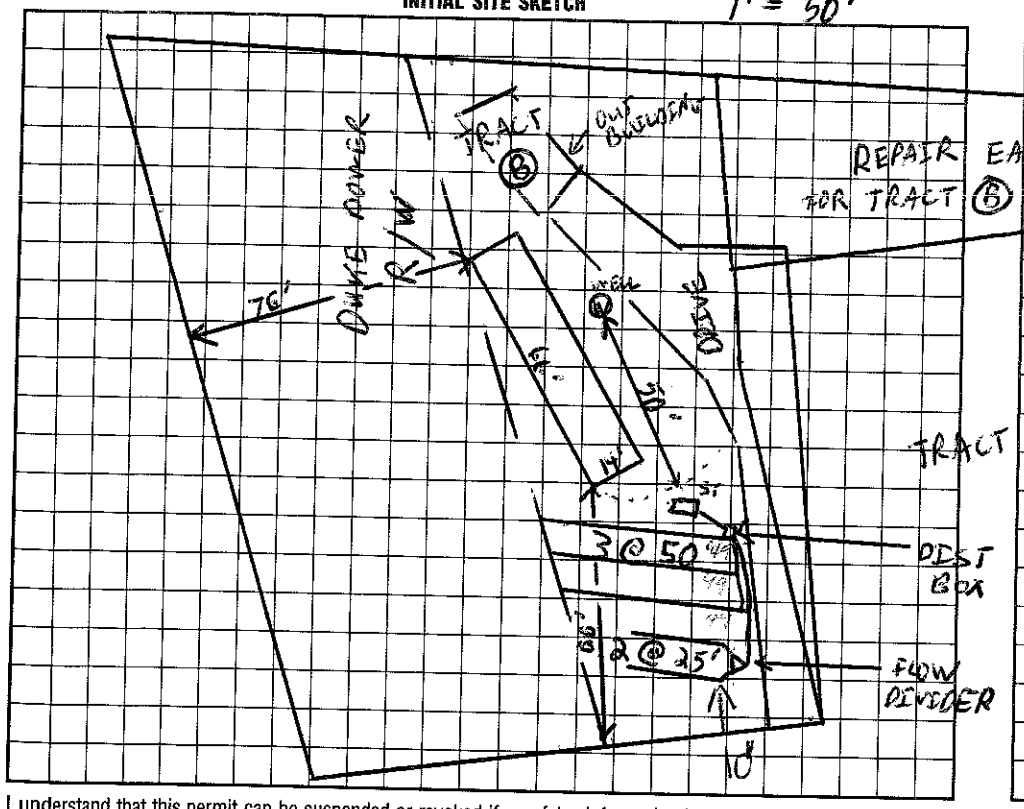

AS BUILT SKETCH

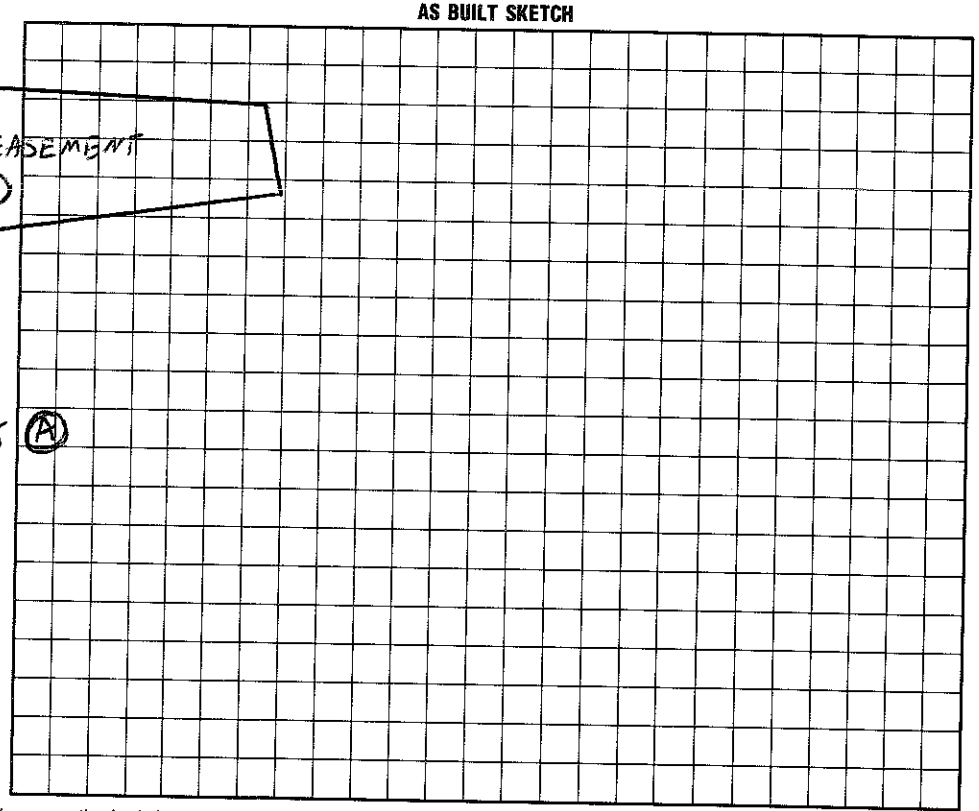

I understand that this permit can be suspended or revoked if any false information is supplied toward securing the permit/any unauthorized changes are made to the site/any unauthorized changes are made in the installation of the system. Improvement Permit is ~~valid for 60~~ months from date of issuance.

Signed: Kenneth D Nieswonger

Improvement Permit by: C. Tracy Green date 4/2/97

AUTHORIZATION TO CONSTRUCT ~~Existing System Inspection by:~~ C. Tracy Green date 4/2/97

Installed by: KENNY PEARSON

Certificate of Completion by: Maria Dotson date ____

Operation Permit by: Maria Dotson / for Lynn RS date 4/14/97

HEALTH DEPT. COPY: WHITE INSPECTION COPY (FINAL): GREEN OWNER COPY (FINAL): YELLOW INSPECTION COPY (INITIAL): PINK OWNER COPY (INITIAL): GOLD