IREDELL COUNTY HEALTH DEPARTMENT

STATESVILLE 704-878-5305 MOORESVILLE 704-664-5281

IMPROVEMENT PERMIT / AUTHORIZATION TO CONSTRUCT / OPERATION PERMIT / EXISTING SYSTEM INSPE ON

PERMIT# 074867 PIN# 4665422508 DATE 8/25/98

OWNER OR CONTRACTOR James McKnight PHONE: Business 664-9080 Home

ADDRESS 255 Rolling Hills J Mooresville NC 28115

LOCATION Shearers Rd after Rocky River TR onto Ashley Woods Dr

SUBDIVISION Ashley Woods BLOCK / SECTION LOT 23 LOT AREA .68 Acre SITE CLASS. DS DESIGN FLOW 360gpd L.T.A.R. .3+

Septic Tank: 1000 J Gallons; STB 1012 Date 7/17/98

Pump Tank: Gallons; PT Date

Pump Make: Model Serial No.

Nitrification Field: No Fields 1 Square Feet 900 Linear Feet 300

No Lines 4at 5' Trench Width 36" Max Trench Bottom Depth 36" Gravel Depth N/A

☒ New System ☐ Repair System Type: I, II, III, IV, V, VI

System Description: Gravity - 25% Reduction

Repair System Description: Pump/Grav. Modified

Maintenance Agreement Required: ☐ Yes ☐ No

☐ House/Mod. Home No. Bedrooms 3

☒ Mobile Home No. Bathrooms 2

☐ Business No. Employees

☐ Other

☐ Slab ☒ Crawl Space ☐ Basement w/plumbing ☐ Basement wo/plumbing


Water Supply: ☐ Individual ☐ Public ☒ Community

Comments:/Conditions: 25% Reduction in Drainfield Area. Keep Septic System 5' from house & 10' from PL.

Comments:/Conditions:

INITIAL SITE SKETCH

Scale 1:50

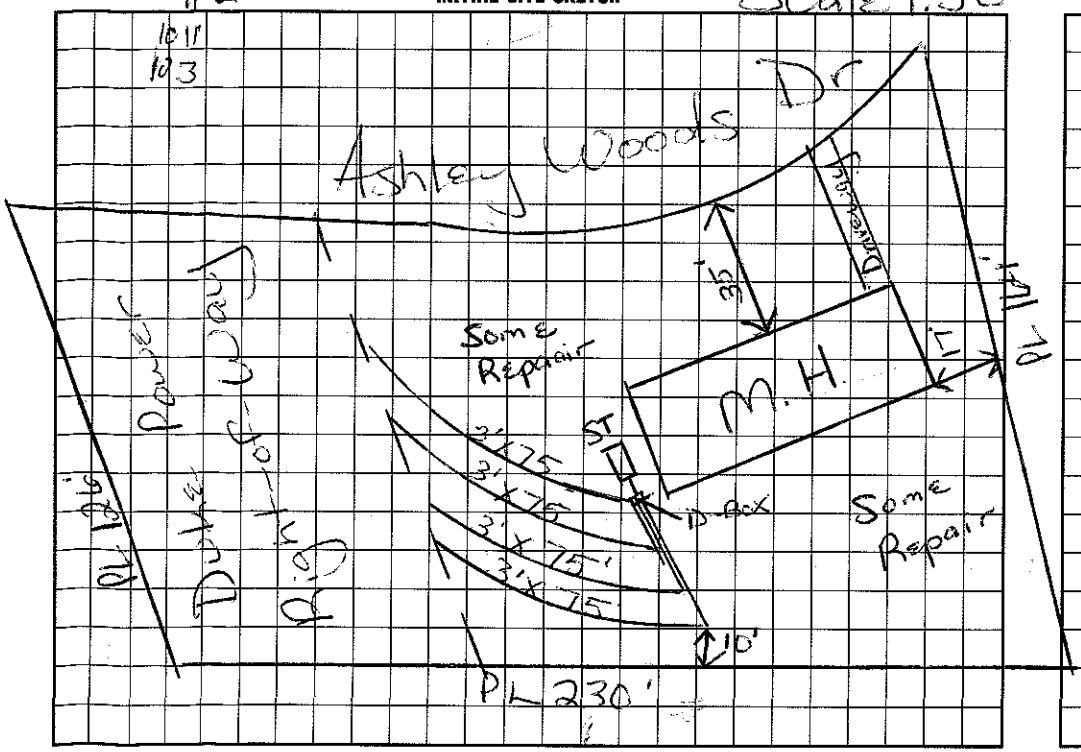

AS BUILT SKETCH

I understand that this permit can be suspended or revoked if any false information is supplied toward securing the permit/any unauthorized changes are made to the site/any unauthorized changes are made in the installation of the system. Improvement Permit with plat valid without expiration. Improvement Permit with site plan valid for sixty months. Authorization to Construct is valid for a period equal to that of Improvement Permit – not to exceed sixty months.

Signed: Debbie atwell date 9-4-98

Improvement Permit by: Maria H. Watson date 8/25/98

Authorization to Construct by: Maria H. Watson date 8/25/98

Installed by: A1 Backhoe

Operation Permit by: [signature] date 9/23/98

Existing System Inspection by: date

HEALTH DEPT. COPY: WHITE INSPECTION COPY (FINAL): GREEN OWNER COPY (FINAL): YELLOW INSPECTION COPY (INITIAL): PINK OWNER COPY (INITIAL): GOLD