11:60

IREDELL COUNTY HEALTH DEPARTMENT

Const. Auth

STATESVILLE 704-878-5305 MOORESVILLE 704-664-5281

IMPROVEMENT PERMIT / ~~CERTIFICATE OF COMPLETION~~ / OPERATION PERMIT / EXISTING SYSTEM INSPECTION

PROPERTY DESCRIPTION NO. 067418 DATE Aug 15, 97 TAX MAP NO. 4665 ~~28745~~ 42 2932 Watershed: ☐ Yes ☐ No

OWNER OR CONTRACTOR James McKnight PHONE: Business _____ Home _____

ADDRESS 255 Rolling Hills Rd, Mooresville

LOCATION Shearers Rd. TR Ashley Dr. on Right

SUBDIVISION Ashley Woods BLOCK / SECTION _____ LOT 5 LOT AREA .598ac SITE CLASS. 1S DESIGN FLOW 360gpd L.T.A.R. .3

Septic Tank: 1000 Gallons; STB 1012 Date 8/28/97

Pump Tank: _____ Gallons; PT _____ Date _____

Pump Make: _____ Model _____ Serial No. _____

Nitrification Field: No Fields 1 Square Feet 900 Linear Feet 300

No Lines 4@75' Trench Width 36" Max Trench Bottom Depth 36"

☑ New System ☐ Repair System Type: I, II, III, IV, V, VI

System Description: gravity chambered/similar type

Repair System Description: Same

Maintenance Agreement Required: ☐ Yes ☑ No

Gravel Depth NA

☐ House/Mod. Home No. Bedrooms 3

☑ Mobile Home SW No. Bathrooms 2

☐ Business No. Employees _____

☐ Other _____

☐ Slab ☑ Crawl Space ☐ Basement w/plumbing ☐ Basement wo/plumbing


Water Supply: ☐ Individual ☑ Community ☐ Public

Comments: X ONE INSPECTION PORT PER LATERAL

Comments:

1"=50'

INITIAL SITE SKETCH

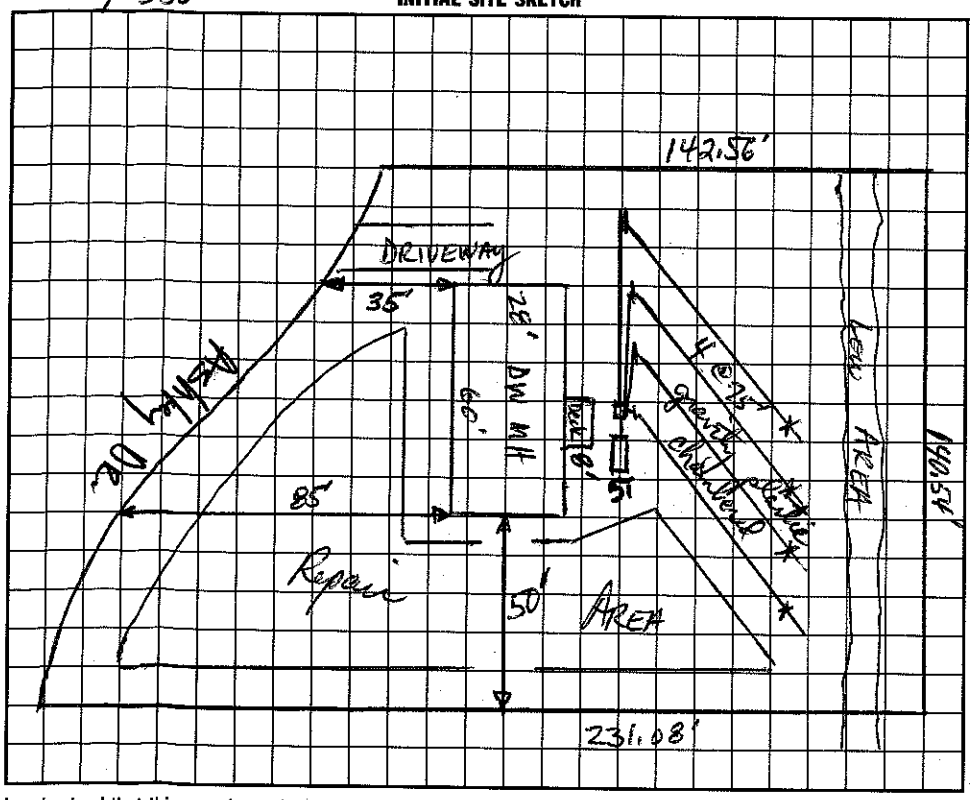

AS BUILT SKETCH

Same as Site Sketch

I understand that this permit can be suspended or revoked if any false information is supplied toward securing the permit/any unauthorized changes are made to the site/any unauthorized changes are made in the installation of the system. Improvement Permit is valid for 60 months from date of issuance.

Signed: Russell Dixon

Improvement Permit by: _____ date 8-15-97

~~Existing System Inspection by~~: _____ date 8-15-97

Installed by: A-1 Backhoe

Certificate of Completion by: _____ date _____

Operation Permit by: _____ date 9/4/97

HEALTH DEPT. COPY: WHITE INSPECTION COPY (FINAL): GREEN OWNER COPY (FINAL): YELLOW INSPECTION COPY (INITIAL): PINK OWNER COPY (INITIAL): GOLD