2:30

IREDELL COUNTY HEALTH DEPARTMENT

STATESVILLE 704-878-5305 MOORESVILLE 704-664-5281

IMPROVEMENT PERMIT / AUTHORIZATION TO CONSTRUCT / OPERATION PERMIT / EXISTING SYSTEM INSPECTION

PERMIT# 67417 PIN# 4606532894542 3899 DATE 4/30/98

OWNER OR CONTRACTOR James McKnight PHONE: Business 1064-9080 Home

ADDRESS 255 Rolling Hills Rd Mooresville, NC 28115

LOCATION 115 S TL Shearers Rd on Rt. after Rocky River TR Ashley Woods 4th on Rt

SUBDIVISION Ashley Woods BLOCK / SECTION I LOT 4 LOT AREA .64 Acre SITE CLASS. PS DESIGN FLOW 360 gpd L.T.A.R. .35-.275

Septic Tank: 1000 Gallons; STB 1212 Date 5-6-98

Pump Tank: Gallons; PT Date

Pump Make: Model Serial No.

Nitrification Field: No Fields 1 Square Feet 1320' Linear Feet 440'+

No Lines 4 at 110'+ Trench Width 36" Max Trench Bottom Depth 36" Gravel Depth 12"

☒ New System ☐ Repair System Type: I, II, III, IV, V, VI

System Description: Gravity Conventional

Repair System Description: Same

Maintenance Agreement Required: ☐ Yes ☒ No

☐ House/Mod. Home ☒ Mobile Home ☐ Business ☐ Other

No. Bedrooms 3 No. Bathrooms 2 No. Employees

☐ Slab ☒ Crawl Space ☐ Basement w/plumbing ☐ Basement wo/plumbing


Water Supply: ☐ Individual ☐ Public ☒ Community

Comments:/Conditions: Keep Septic System At- least 10' from PL & 5' from House

67 69
69 73

Comments:/Conditions:

INITIAL SITE SKETCH Scale 1:60

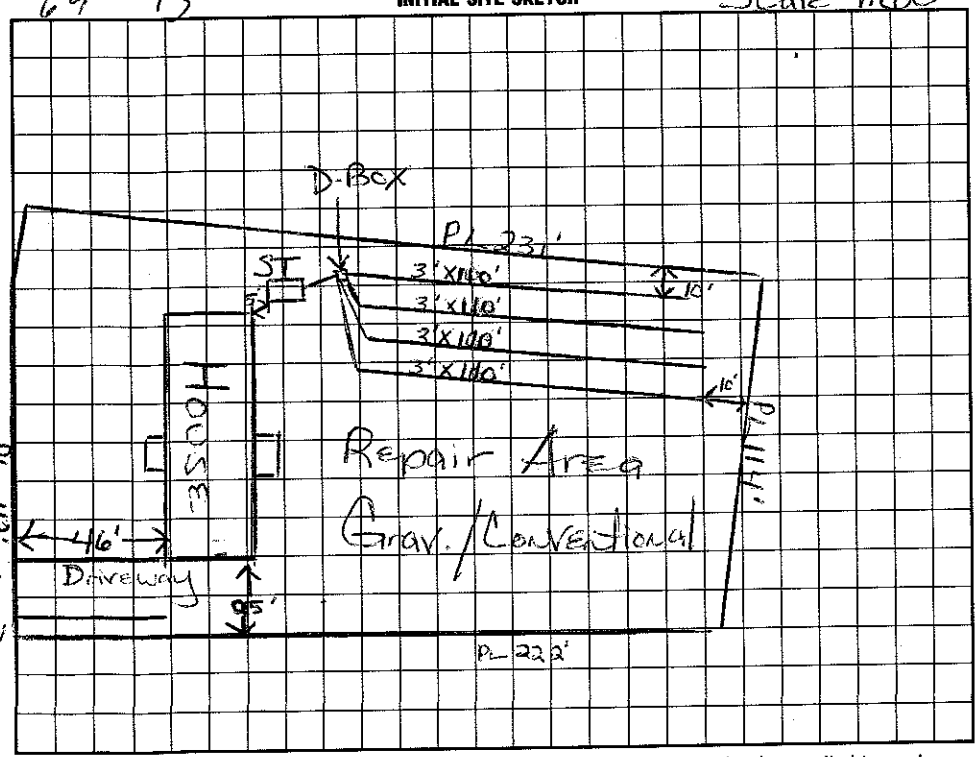

AS BUILT SKETCH

I understand that this permit can be suspended or revoked if any false information is supplied toward securing the permit/any unauthorized changes are made to the site/any unauthorized changes are made in the installation of the system. Improvement Permit with plat valid without expiration. Improvement Permit with site plan valid for sixty months. Authorization to Construct is valid for a period equal to that of Improvement Permit – not to exceed sixty months.

Signed: date 5/12/98

Improvement Permit by: Maria H. Dotson date 4/30/98

Authorization to Construct by: Maria H. Dotson date 4/30/98

Installed by: A1 Backhoe

Operation Permit by: date 6/8/98

Existing System Inspection by: date

HEALTH DEPT. COPY: WHITE INSPECTION COPY (FINAL): GREEN OWNER COPY (FINAL): YELLOW INSPECTION COPY (INITIAL): PINK OWNER COPY (INITIAL): GOLD