3 of

IREDELL COUNTY HEALTH DEPARTMENT Cont. Auth. STATESVILLE 704-878-5305 MOORESVILLE 704-664-5281

IMPROVEMENT PERMIT / ~~CERTIFICATE OF COMPLETION~~ / OPERATION PERMIT / EXISTING SYSTEM INSPECTION

PROPERTY DESCRIPTION NO. 067430 DATE July 12, 1997 TAX MAP NO. 4665-18745 424696 Watershed: ☐ Yes ☐ No

OWNER OR CONTRACTOR James McKnight PHONE: Business _____ Home _____

ADDRESS 253 Hollis Hall Rd, Mooresville

LOCATION Shepherds Chapel Rd S past Rocky River Rd TR Ashley Dr. ~400' on left

SUBDIVISION Ashley Woods BLOCK / SECTION _____ LOT 25 LOT AREA .68Ac SITE CLASS. 5 DESIGN FLOW 480gpd L.T.A.R. .3

Septic Tank: 1000 Gallons; STB 1012 Date 6/2/97

Pump Tank: _____ Gallons; PT _____ Date _____

Pump Make: _____ Model _____ Serial No. _____

Nitrification Field: No Fields 2 Square Feet 1200 Linear Feet 400

No Lines 4+4 Trench Width 36" Max Trench Bottom Depth 36" Gravel Depth N/A

☑ New System ☐ Repair System Type: I, II, III, IV, V, VI

System Description: gravity chambered

Repair System Description: Same

Maintenance Agreement Required: ☐ Yes ☑ No

☐ House/Mod. Home No. Bedrooms 4

☑ Mobile Home No. Bathrooms 2.5

☐ Business No. Employees _____

☐ Other _____

☐ Slab ☑ Crawl Space ☐ Basement w/plumbing ☐ Basement wo/plumbing


Water Supply: ☐ Individual ☑ Community ☐ Public

Comments: Septic TANK → Flow Divider → 2 D-boxes w/ speed levelers → Laterals


*ONE inspection port per Lateral

Comments:

INITIAL SITE SKETCH 1"=50'

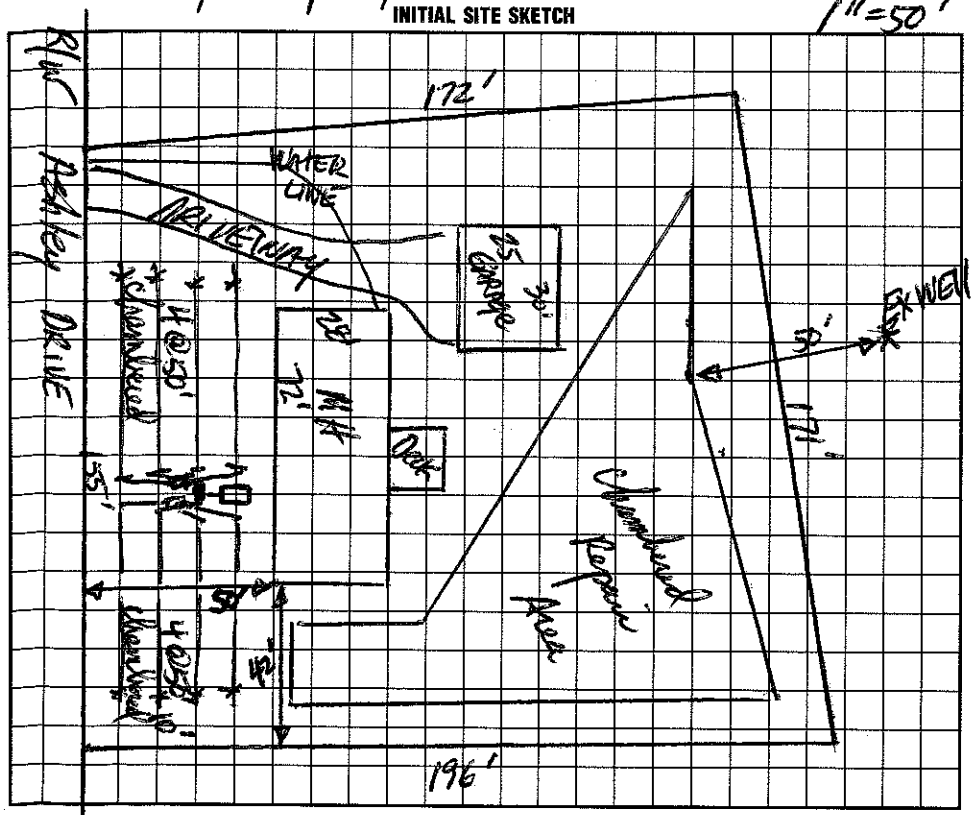

AS BUILT SKETCH

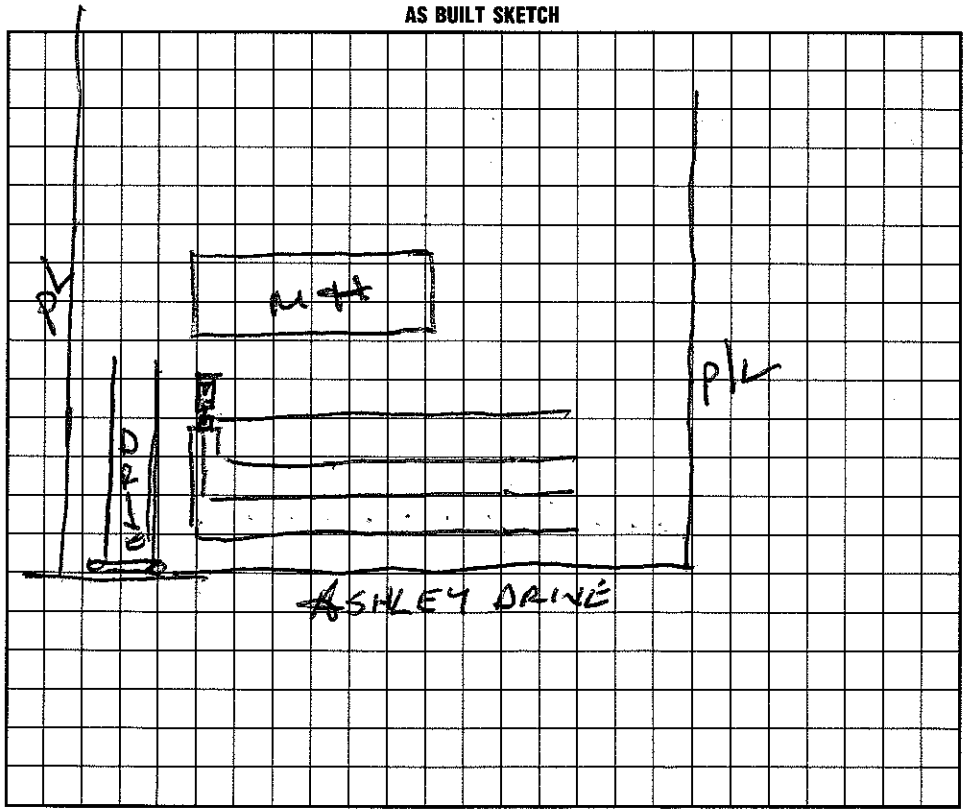

I understand that this permit can be suspended or revoked if any false information is supplied toward securing the permit/any unauthorized changes are made to the site/any unauthorized changes are made in the installation of the system. Improvement Permit is valid for 60 months from date of issuance.

Signed: * Russell Dees

Improvement Permit by: DR Hymon, RS date 7-12-97

~~Existing System Inspection by:~~ Construction Authorization DR Hymon, RS date 7-12-97

Installed by: Dennis Dalton

Certificate of Completion by: Wesley Sparks RS date 8/11/97

Operation Permit by: Wesley Sparks RS. date 8/11/97

HEALTH DEPT. COPY: WHITE INSPECTION COPY (FINAL): GREEN OWNER COPY (FINAL): YELLOW INSPECTION COPY (INITIAL): PINK OWNER COPY (INITIAL): GOLD