IREDELL COUNTY HEALTH DEPARTMENT

STATESVILLE 704-878-5305 MOORESVILLE 704-664-5281

IMPROVEMENT PERMIT / AUTHORIZATION TO CONSTRUCT / OPERATION PERMIT / EXISTING SYSTEM INSPECTION

PERMIT# 674160 PIN# ~~4665328745~~ 42 9899 DATE 4/30/98

OWNER OR CONTRACTOR James McKnight PHONE: Business 866-9540 Home

ADDRESS 255 Rolling Hill Rd Mooresville NC 28115

LOCATION 115 S TL Shearers Rd on Rt after Rocky River TR Ashley Woods Dr

SUBDIVISION Ashley Woods BLOCK / SECTION I LOT 3 LOT AREA .60 Acres SITE CLASS. PS DESIGN FLOW 360gpd L.T.A.R. .3-.25

Septic Tank: 1000 Gallons; STB Date

Pump Tank: Gallons; PT Date

Pump Make: Model Serial No.

Nitrification ~~Field~~ Area(s) 1 Square Feet 1260' Linear Feet 400'

No Lines ~~1 2 3 4~~ Trench Width 36" Max Trench Bottom Depth 36" Gravel Depth 12"

☒ New System ☐ Repair System Type: I, (II), III, IV, V, VI

System Description: Gravity Conventional

Repair System Description: Same

Maintenance Agreement Required: ☐ Yes ☐ No

☐ House/Mod. Home No. Bedrooms 3

☒ Mobile Home No. Bathrooms 2

☐ Business No. Employees

☐ Other


☐ Slab ☒ Crawl Space ☐ Basement w/plumbing ☐ Basement wo/plumbing

Water Supply: ☐ Individual ☒ Public ☐ Community

Comments:/Conditions: Keep Septic System at least 10' from PL & 5' from house & 100' from Existing Well.

Comments:/Conditions:

INITIAL SITE SKETCH Scale 1:60

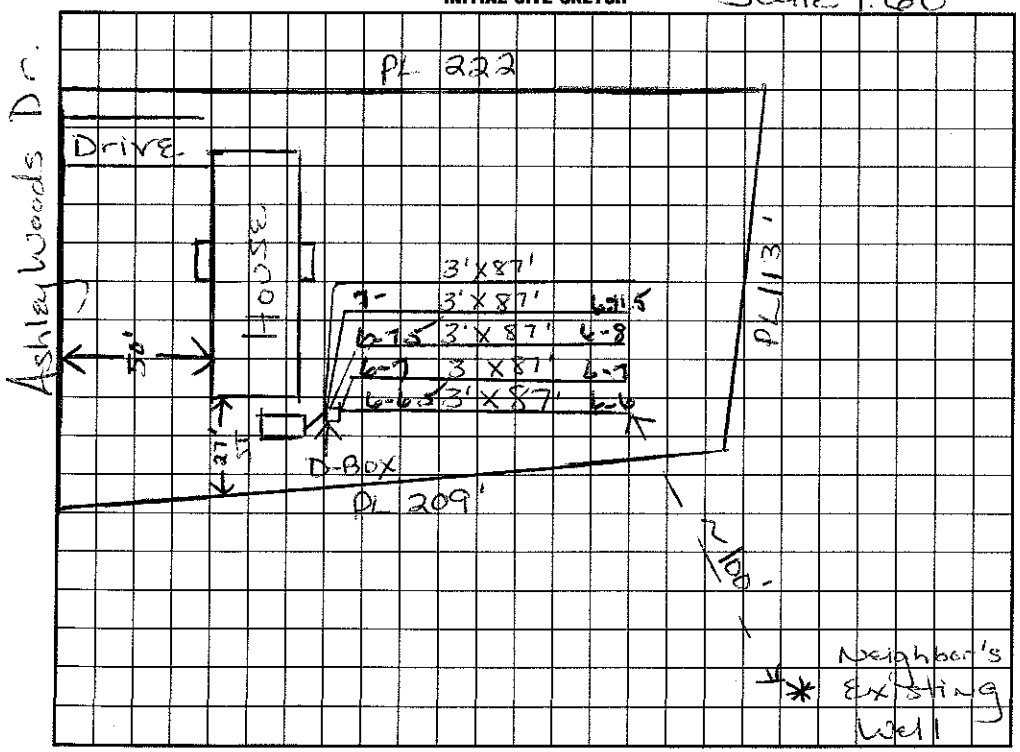

AS BUILT SKETCH

I understand that this permit can be suspended or revoked if any false information is supplied toward securing the permit/any unauthorized changes are made to the site/any unauthorized changes are made in the installation of the system. Improvement Permit with plat valid without expiration. Improvement Permit with site plan valid for sixty months. Authorization to Construct is valid for a period equal to that of Improvement Permit – not to exceed sixty months.

Signed: [signature] date 5-12-98 Installed by: A-1 Backhoe

Improvement Permit by: Maria H. Dotson date 4/30/98 Operation Permit by: Wesley Sparks RS. date 5/18/98

Authorization to Construct by: Maria H. Dotson date 4/30/98 Existing System Inspection by: Wesley Sparks RS date 5/18/98

HEALTH DEPT. COPY: WHITE INSPECTION COPY (FINAL): GREEN OWNER COPY (FINAL): YELLOW INSPECTION COPY (INITIAL): PINK OWNER COPY (INITIAL): GOLD