2:30

IREDELL COUNTY HEALTH DEPARTMENT

STATESVILLE 704-878-5305 MOORESVILLE 704-664-5281

IMPROVEMENT PERMIT / AUTHORIZATION TO CONSTRUCT / OPERATION PERMIT / EXISTING SYSTEM INSPECTI

PERMIT# 67431 PIN# 4665328945 42 4648 DATE 8/25/9

OWNER OR CONTRACTOR James McKnight PHONE: Business 1664-9080 Agent ~~Home~~ Paul Sprinkle 1662-8436

ADDRESS 255 Rolling Hill Rd Mooresville, NC 28115

LOCATION Hwy 115 S to Shearers Rd TR into Ashley Woods lot on left.

SUBDIVISION Ashley Woods BLOCK / SECTION LOT 26 LOT AREA SITE CLASS. PS DESIGN FLOW 480 gpd L.T.A.R. .25-.3

Septic Tank: 1000 Gallons; STB 780 (SST) Date 4/26/99

Pump Tank: Gallons; PT Date

Pump Make: Model Serial No.

Nitrification Field: No Fields 1 Square Feet 1440* Linear Feet *480'

No Lines 5 at 96' Trench Width 36" Max Trench Bottom Depth 36" Gravel Depth N/A

☒ New System ☐ Repair System Type: I, II, III, IV, V, VI *

System Description: Gravity - 25% Innovative

Repair System Description: Repl

Maintenance Agreement Required: ☐ Yes ☒ No

☐ House/Mod. Home ☒ Mobile Home ☐ Business ☐ Other

No. Bedrooms 4 No. Bathrooms 2 No. Employees

☐ Slab ☒ Crawl Space ☐ Basement w/plumbing ☐ Basement wo/plumbing


Water Supply: ☐ Individual ☐ Public ☒ Community

Comments:/Conditions: *25% Reduction in Drainfield area. Keep Septic at least 10' from PL & 5' from House

Comments:/Conditions: (25% Innovative = Chamber or E-Z Lay) Replaces permit issued 5/7/98

MH Not set up yet at time of inspection

INITIAL SITE SKETCH Scale 1:40'

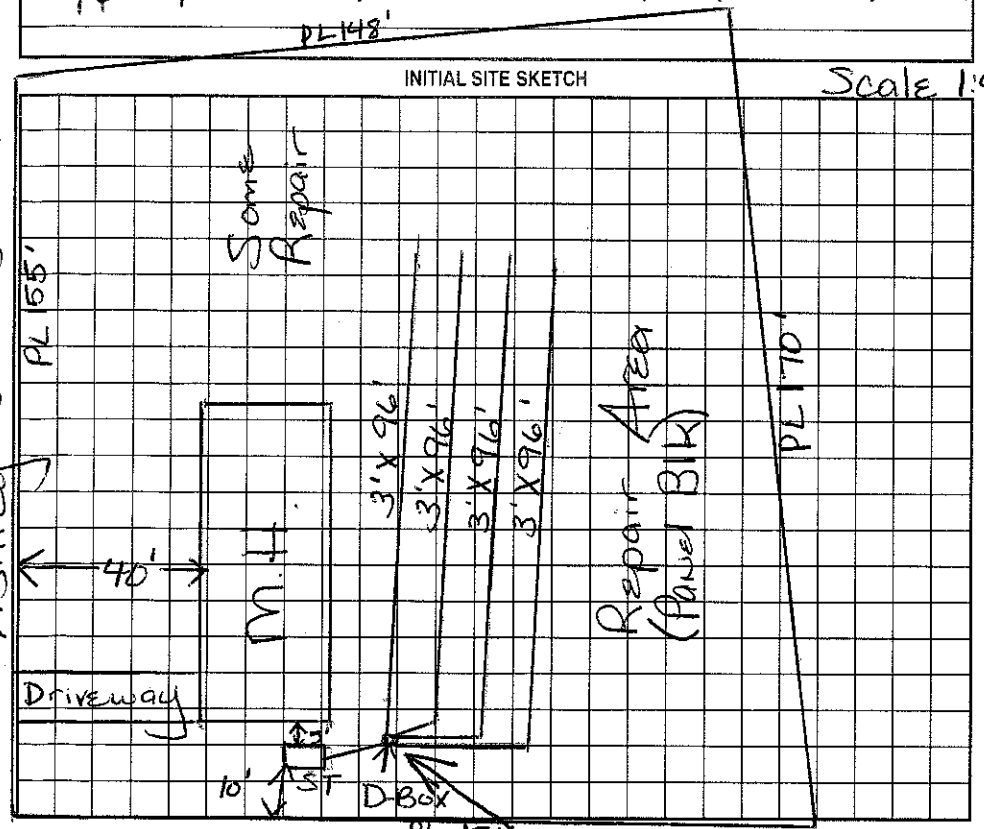

AS BUILT SKETCH

Installed as Drawn

Permit can be suspended or revoked if any false information is supplied toward securing the permit/any unauthorized changes are made to the site/any unauthorized changes are made in the installation of the system. Improvement Permit with plan valid without expiration. Improvement Permit with Site plan valid for sixty months. Authorization to Construct is valid for a period equal to that of Improvement Permit – not to exceed sixty months.

Signed: Mary P Poole date 8/30/99 Installed by: Randy Miller

Improvement Permit by: Maint HH Deloan RS date 8/27/99 Operation Permit by: Maint HH Deloan RS date 9/1/99

Authorization to Construct by: Maint HH Deloan RS date 8/27/99 Existing System Inspection by: date

HEALTH DEPT. COPY: WHITE OWNER COPY (FINAL): YELLOW OWNER COPY (INITIAL): PINK