48'

IREDELL COUNTY HEALTH DEPARTMENT

STATESVILLE 704-878-5305 MOORESVILLE 704-664-5281

IMPROVEMENT PERMIT / AUTHORIZATION TO CONSTRUCT / OPERATION PERMIT / EXISTING SYSTEM INSPECTION

PERMIT# 67431 PIN# 4665328745 DATE 5/7/98

OWNER OR CONTRACTOR James McKnight PHONE: Business 664-9080 Home

ADDRESS 255 Rolling Hill Rd Mooresville, NC 28115

LOCATION Hwy 115 S. TL Shearers Rd TR into Ashley Woods (on Rt. after Rocky River) lot on left


SUBDIVISION Ashley Woods BLOCK / SECTION LOT 36 LOT AREA SITE CLASS. DESIGN FLOW L.T.A.R. .25-.3

- Septic Tank: 1000 Gallons; STB Date
- Pump Tank: Gallons; PT Date
- Pump Make: Model Serial No.
- Nitrification Field: No Fields 2 Square Feet *1080 Linear Feet *360
- No Lines 6 at 60' Trench Width 36" Max Trench Bottom Depth 36" Gravel Depth N/A
- ☒ New System ☐ Repair System Type: I, II, (III), IV, V, VI
- System Description: Gravity-Plastic Chamber or Similar
- Repair System Description: Same
- Maintenance Agreement Required: ☐ Yes ☒ No
- ☐ Slab ☒ Crawl Space ☐ Basement w/plumbing ☐ Basement wo/plumbing
- ☐ House/Mod. Home ☒ Mobile Home ☐ Business ☐ Other
- No. Bedrooms 3/4 No. Bathrooms 2 No. Employees
- Water Supply: ☐ Individual ☐ Public ☒ Community


Comments:/Conditions: *25% Reduction in Drainfield Area
Keep Septic System at least 10' from PL & 5' from House
5 at 96'

Comments:/Conditions:

INITIAL SITE SKETCH Scale 1:40

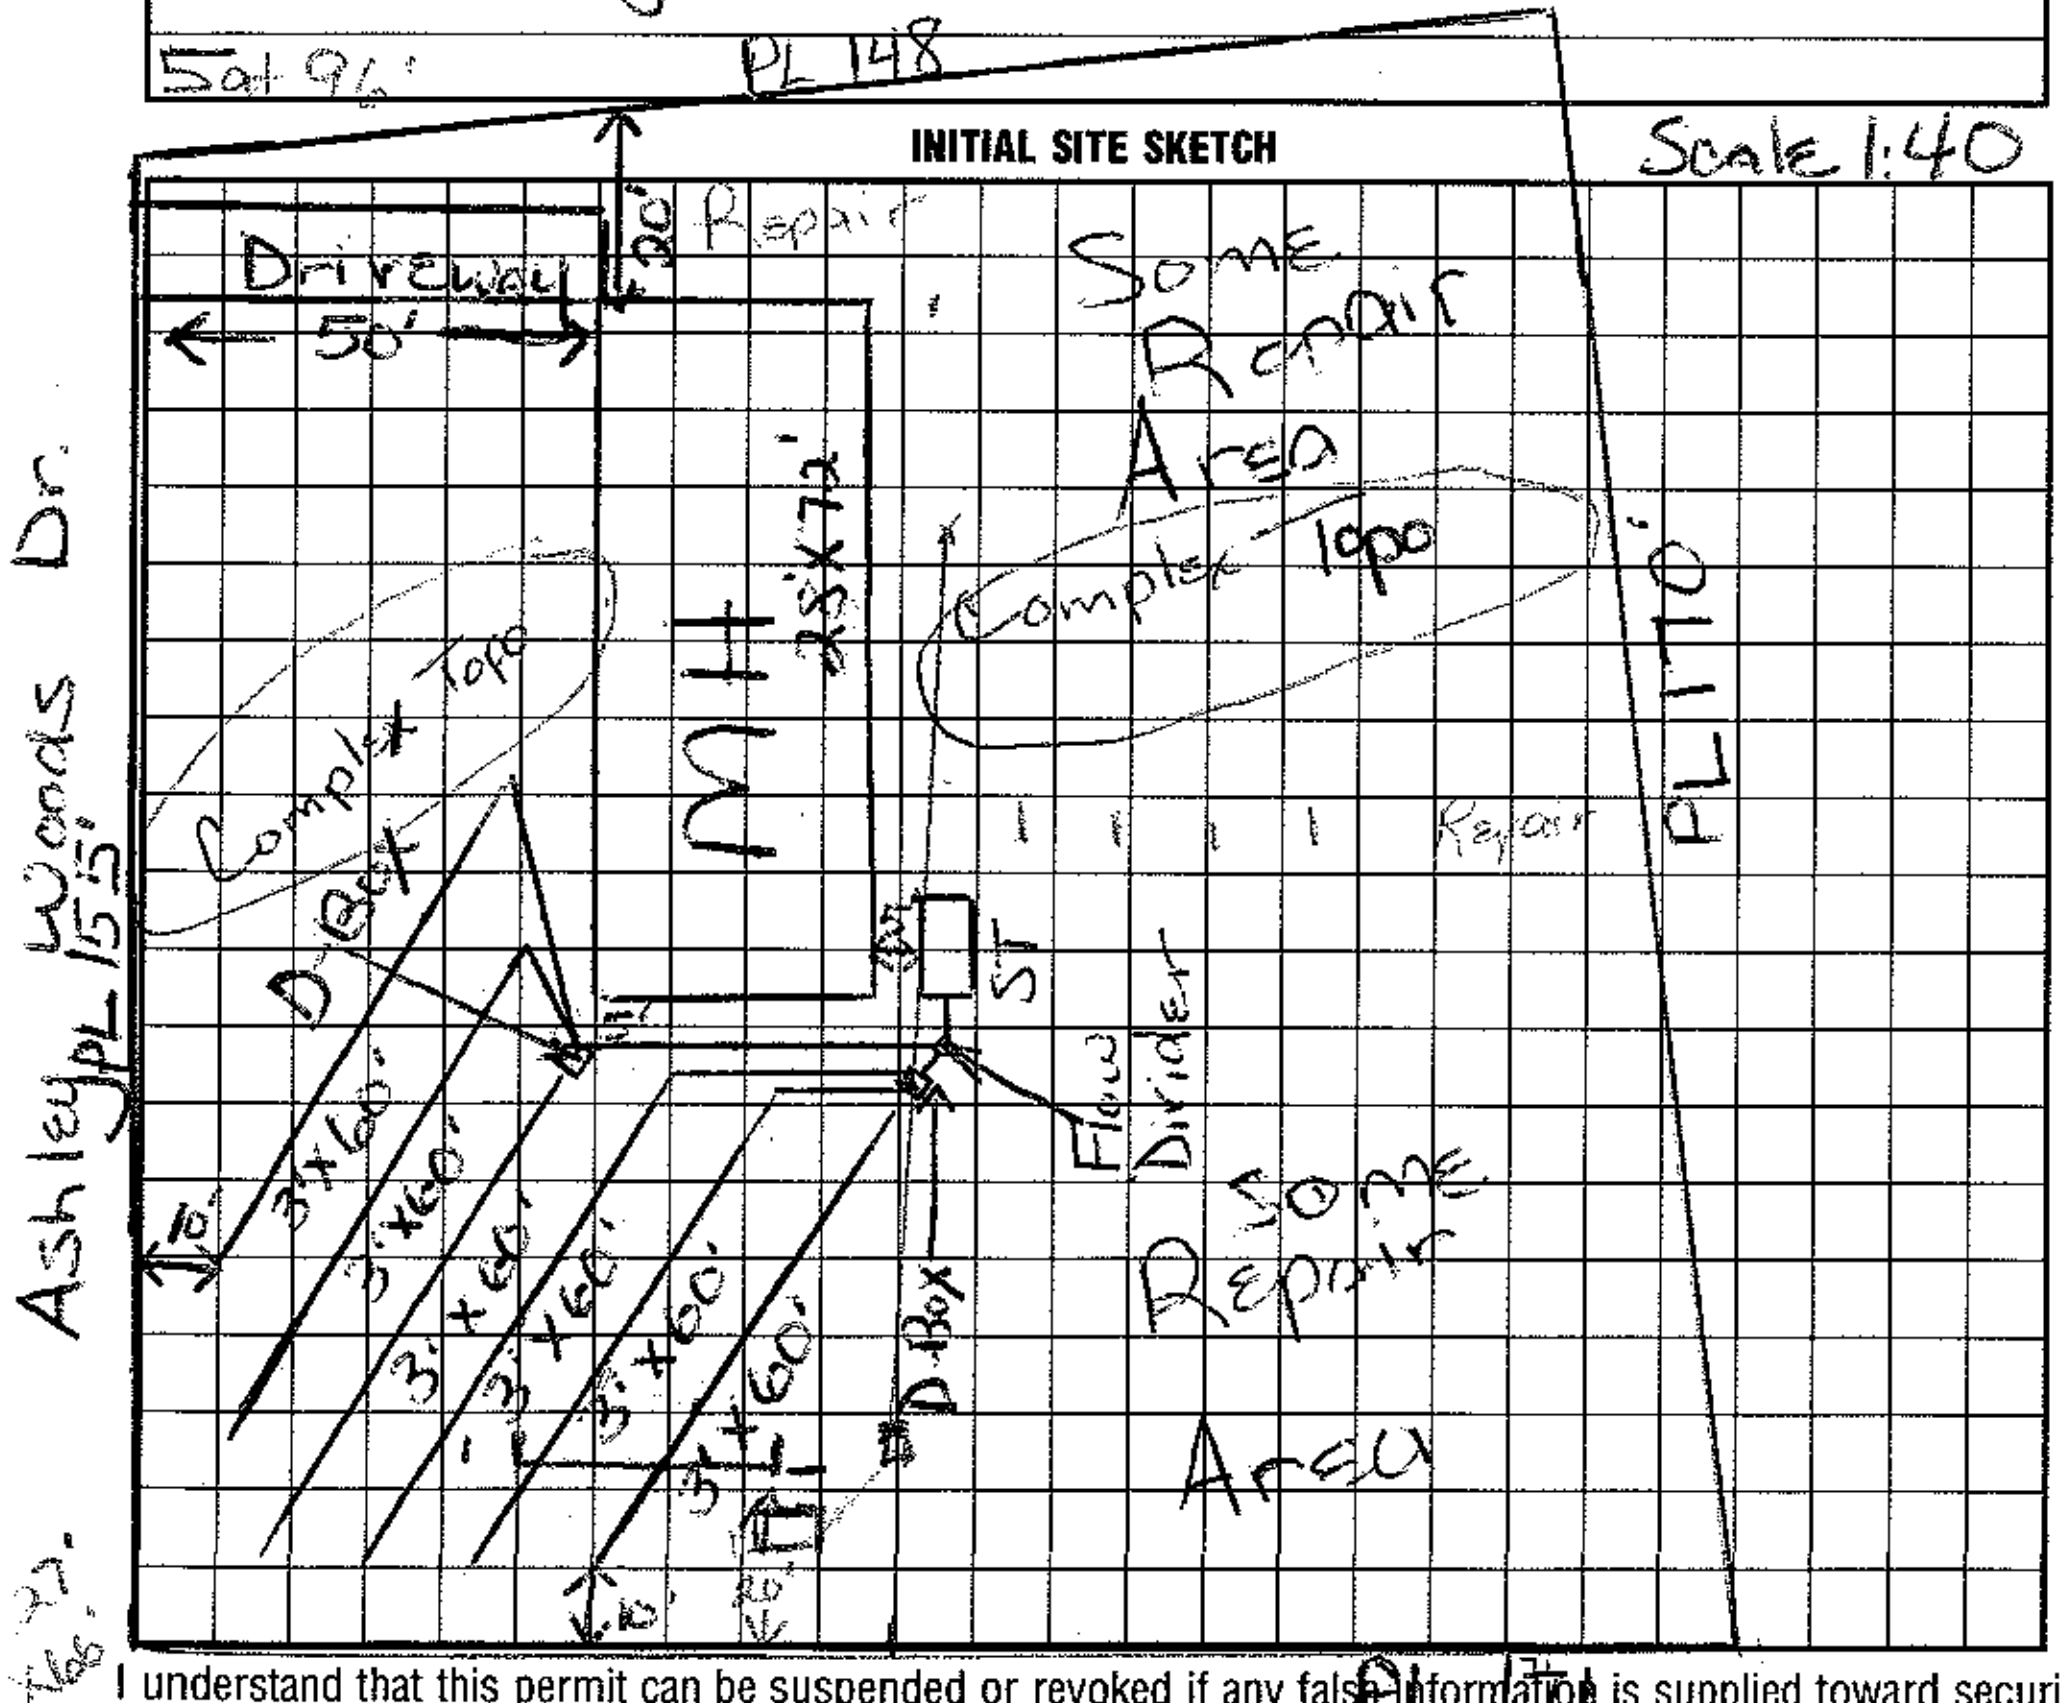

AS BUILT SKETCH

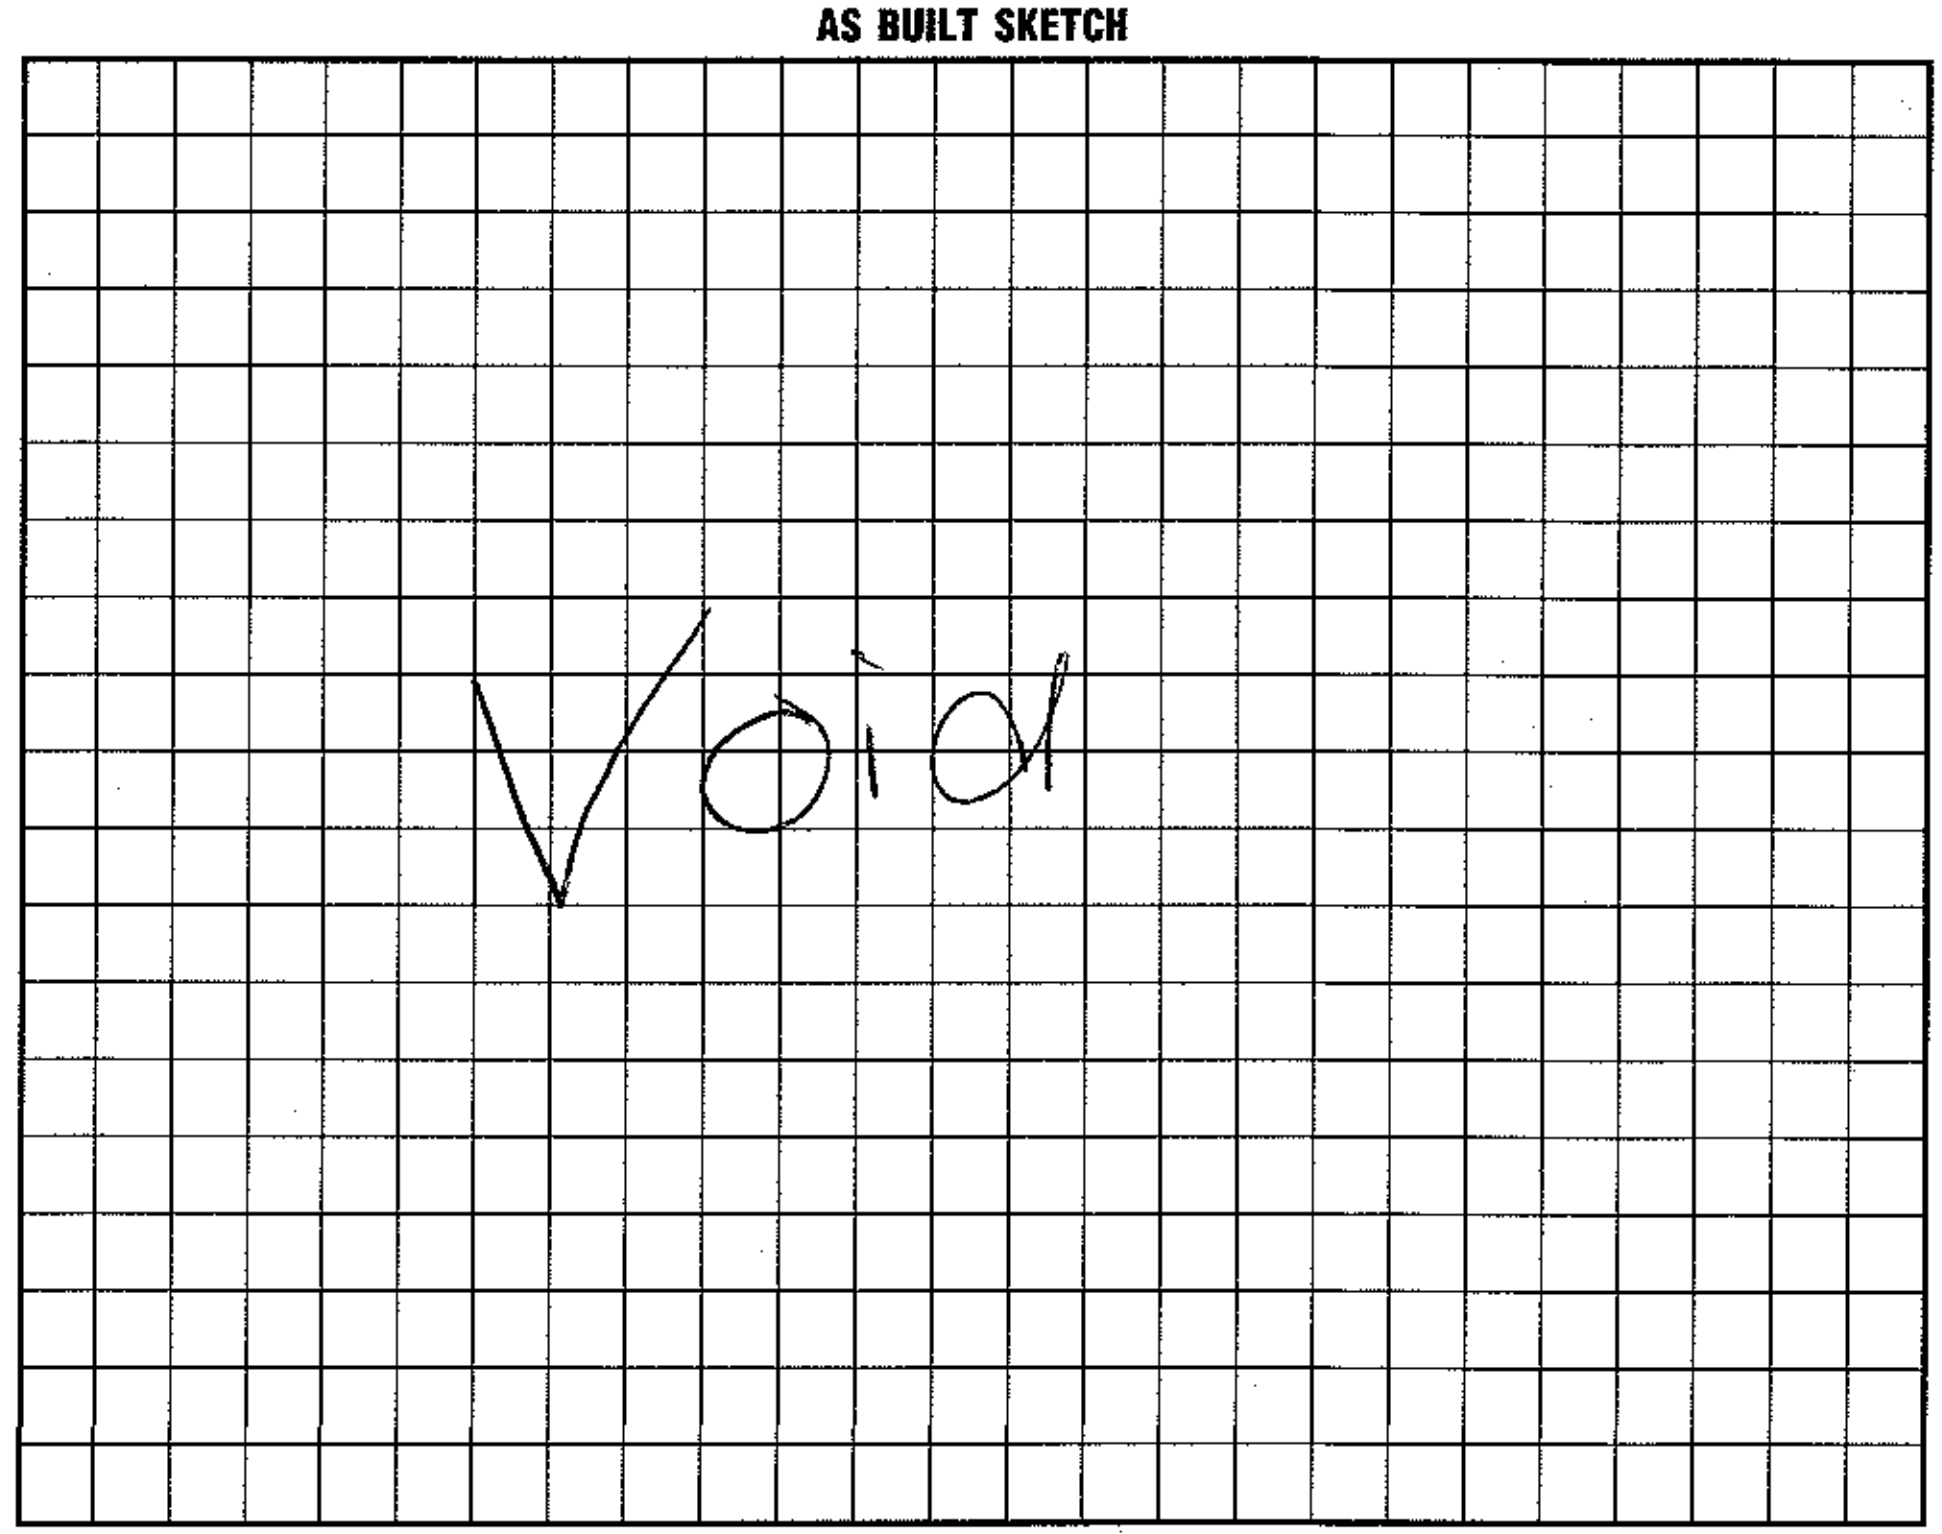

I understand that this permit can be suspended or revoked if any false information is supplied toward securing the permit/any unauthorized changes are made to the site/any unauthorized changes are made in the installation of the system. Improvement Permit with plat valid without expiration. Improvement Permit with site plan valid for sixty months. Authorization to Construct is valid for a period equal to that of Improvement Permit – not to exceed sixty months.

Signed: [signature] date 5/12/98 Installed by:

Improvement Permit by: Maria Dotson date 5/7/98 Operation Permit by: date

Authorization to Construct by: Maria H. Dotson date 5/7/98 Existing System Inspection by: date

HEALTH DEPT. COPY: WHITE INSPECTION COPY (FINAL): GREEN OWNER COPY (FINAL): YELLOW INSPECTION COPY (INITIAL): PINK OWNER COPY (INITIAL): GOLD