IREDELL COUNTY HEALTH DEPARTMENT

STATESVILLE 704-878-5305 MOORESVILLE 704-664-5281

IMPROVEMENT PERMIT / AUTHORIZATION TO CONSTRUCT / OPERATION PERMIT / EXISTING SYSTEM INSPECTION

PERMIT# 69814 PIN# 4665.32 ~~87 45~~ 42 6828 DATE 5/1/98

OWNER OR CONTRACTOR James Mc Knight PHONE: Business (704) 866-9540 Home

ADDRESS 255 Rolling Hill Rd. Mooresville, NC 28115

LOCATION Hwy 115 S. TR Shearers Rd TR (after Rocky River) Ashley Woods Dr 2nd lot on Rt.

SUBDIVISION Ashley Woods BLOCK / SECTION I LOT 2 LOT AREA .59 Acre SITE CLASS. PS DESIGN FLOW 360gpd L.T.A.R. .3

Septic Tank: 1000 Gallons; STB 1012 Date 6/9/98
Pump Tank: Gallons; PT Date
Pump Make: Model Serial No.
Nitrification Field: No Fields 1 Square Feet ~~X~~ 900' Linear Feet ~~X~~ 300'
No Lines 3 at 100' Trench Width 36" Max Trench Bottom Depth 36" Gravel Depth 12"

☒ New System ☐ Repair System Type: I, II, III, IV, V, VI
System Description: Grav - Plastic Chamber or Similar
Repair System Description: Grav - Plastic Chamber Similar
Maintenance Agreement Required: ☐ Yes ☒ No

☐ House/Mod. Home No. Bedrooms 3
☒ Mobile Home No. Bathrooms 2
☐ Business No. Employees
☐ Other


☐ Slab ☒ Crawl Space ☐ Basement w/plumbing ☐ Basement wo/plumbing

Water Supply: ☐ Individual ☐ Public ☒ Community

Comments:/Conditions: ~~X~~ 25% reduction in drainfield area
Keep Septic System at least 5' from house, 10' from PL & 50' from Existing well
Can't place house any farther than 150' from Street.

Comments:/Conditions:

INITIAL SITE SKETCH Scale 1:40

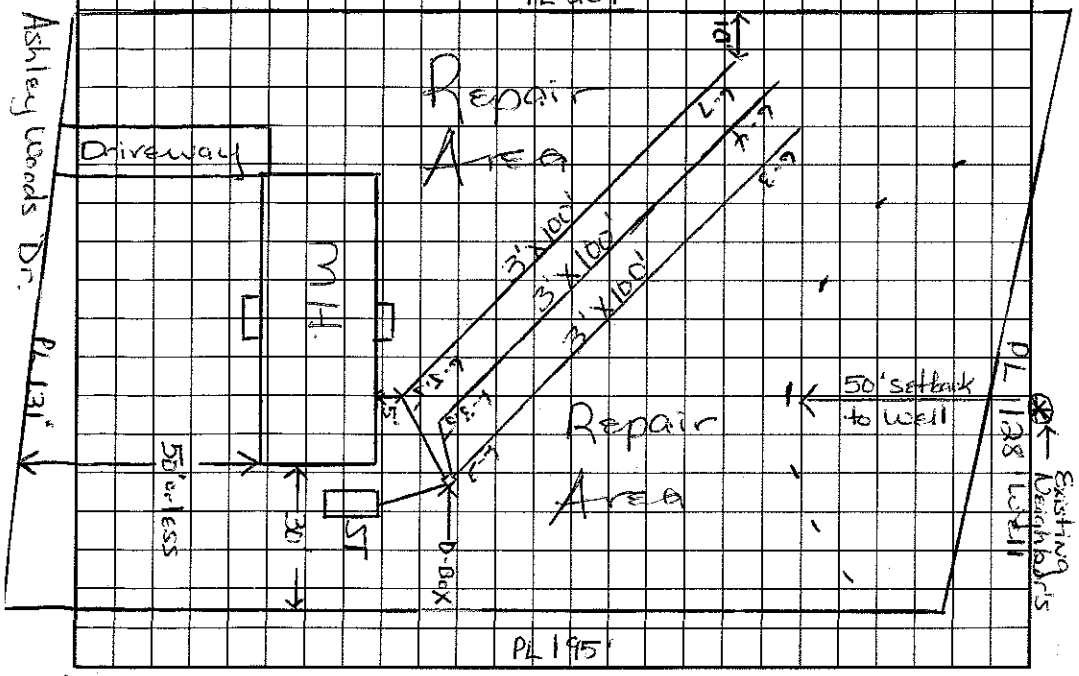

AS BUILT SKETCH

I understand that this permit can be suspended or revoked if any false information is supplied toward securing the permit/any unauthorized changes are made to the site/any unauthorized changes are made in the installation of the system. Improvement Permit with plat valid without expiration. Improvement Permit with site plan valid for sixty months. Authorization to Construct is valid for a period equal to that of Improvement Permit – not to exceed sixty months.

Site Evaluated: [signature] date 5/12/98 Installed by: Al Barkhor

Improvement Permit by: [signature] date 5/1/98 Operation Permit by: Wesley Sparks RS. date 11/19/98

Authorization to Construct by: [signature] date 5/1/98 Existing System Inspection by: date

HEALTH DEPT. COPY: WHITE INSPECTION COPY (FINAL): GREEN OWNER COPY (FINAL): YELLOW INSPECTION COPY (INITIAL): PINK OWNER COPY (INITIAL): GOLD