$ 450

IREDELL COUNTY HEALTH DEPARTMENT

STATESVILLE 704-878-5305 MOORESVILLE 704-664-5281

IMPROVEMENT PERMIT / AUTHORIZATION TO CONSTRUCT / OPERATION PERMIT / EXISTING SYSTEM INSPECTION

PERMIT# 131158 PIN# 4665 31 5665 .30 / 4665 42 8133 DATE 8/9/06

OWNER OR APPLICANT Robinson Builders PHONE: Business 704-361-7347 Home

ADDRESS 1503 BURNING LANTERN LN. KANNAPOLIS, NC. 28081

LOCATION Shearin Rd. TR Streamside Ln., 2ND lot on (R)

SUBDIVISION Creek Edge BLOCK / SECTION LOT 30 LOT AREA .53AC SITE CLASS PS DESIGN FLOW 480 L.T.A.R. .3

Septic Tank: 1000 Gallons; STB 350 Date 1/21/06

Pump Tank: 1000 Gallons; PT 350 Date 1/21/06

Pump Make: Model Serial No.

Nitrification Field: No Fields 1 Square Feet 800 Linear Feet 267

No Lines 3@89' Trench Width 3' Max Trench Bottom Depth 3'

☒ New System ☐ Repair ☐ Expansion System Type: I II III (IV) V VI

System Description: PBBS - LPP DST.

Repair System Description: SAME

Maintenance Agreement Required: ☒ Yes ☐ No

☒ House/Mod. Home ☐ Mobile Home ☐ Business ☐ Other

No. Bedrooms 4 No. Persons 3 No. Employees


Water Supply: ☒ Individual ☐ Public ☐ Community

Gravel Depth No ☐ Gravity ☐ Pressure ☐ Slab ☒ Crawl Space ☐ Basement w/plumbing ☐ Basement wo/plumbing

Comments/Conditions: Tank locations important - No VARIANCE

Comments/Conditions:

INITIAL SITE SKETCH

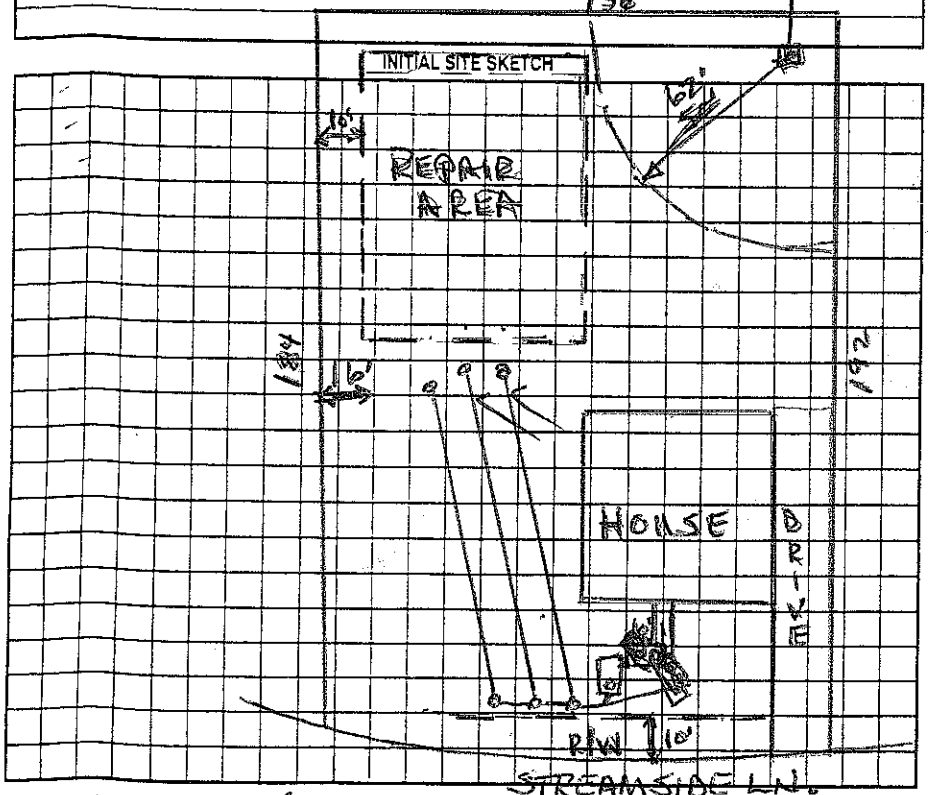

AS BUILT SKETCH

Permit can be suspended or revoked if any false information is supplied toward securing the permit/any unauthorized changes are made to the site/any unauthorized changes are made in the installation of the system. Improvement Permit with plat valid without expiration ☐ Improvement Permit with site plan valid for sixty months ☐ Authorization to Construct is valid for a period equal to that of Improvement Permit – not to exceed sixty months.

Signed: [signature] date

Improvement Permit by: Wesley Sparks RS. date 8/9/06

Authorization to Construct by: Wesley Sparks RS date 8/9/06

Installed by: Prudential

Operation Permit by: Wesley Sparks RS date 9/8/06

Existing System Inspection by: date

HEALTH DEPT. COPY: WHITE OWNER COPY (FINAL): YELLOW OWNER COPY (INITIAL): PINK