IREDELL COUNTY HEALTH DEPARTMENT

AUTHORIZATION TO CONSTRUCT

STATESVILLE 704-878-5305 MOORESVILLE 704-664-5281

IMPROVEMENT PERMIT / ~~CERTIFICATE OF COMPLETION~~ / OPERATION PERMIT / EXISTING SYSTEM INSPECTION

PROPERTY DESCRIPTION NO. 24257 DATE 7/30/96

OWNER OR CONTRACTOR Debbie Fields TAX MAP NO. 1C-3-A-1 4665428329

ADDRESS 501 Antler Ave Mooresville 28115 PHONE: Business _____ Watershed: ☐ Yes ☒ No

LOCATION 115 S - TL Stevens - TR Wildwood Acres - Corner Lot Home 663-5590

SUBDIVISION Wildwood Acres BLOCK / SECTION _____ LOT 1 LOT AREA _____ SITE CLASS B

Septic Tank: 1000 Gallons; STB 794 Date 6/19/96 DESIGN FLOW ~~440~~ gpd L.T.A.R. .3 gpd/sf

Pump Tank: _____ Gallons; PT _____ Date _____

Pump Make: _____ Model _____ Serial No. _____

Nitrification Field: No Fields 1 Square Feet ~~1440~~ 1300 Linear Feet 400

No Lines 5 Trench Width 36" Max Trench Bottom Depth 36" ~~Gravel Depth~~ Sand

☑ New System ☐ Repair System Type: I, II, III, IV, V, VI

System Description: Gravity Chambered

Repair System Description: Gravity Panel

Maintenance Agreement Required: ☐ Yes ☒ No

☐ House/Mod. Home ☑ Mobile Home ☐ Business ☐ Other

No. Bedrooms 4 No. Bathrooms 2 No. Employees _____


☐ Slab ☑ Crawl Space ☐ Basement w/plumbing ☐ Basement wo/plumbing

Water Supply: ☑ Individual ☐ Community ☐ Public


Comments:

Comments:

INITIAL SITE SKETCH

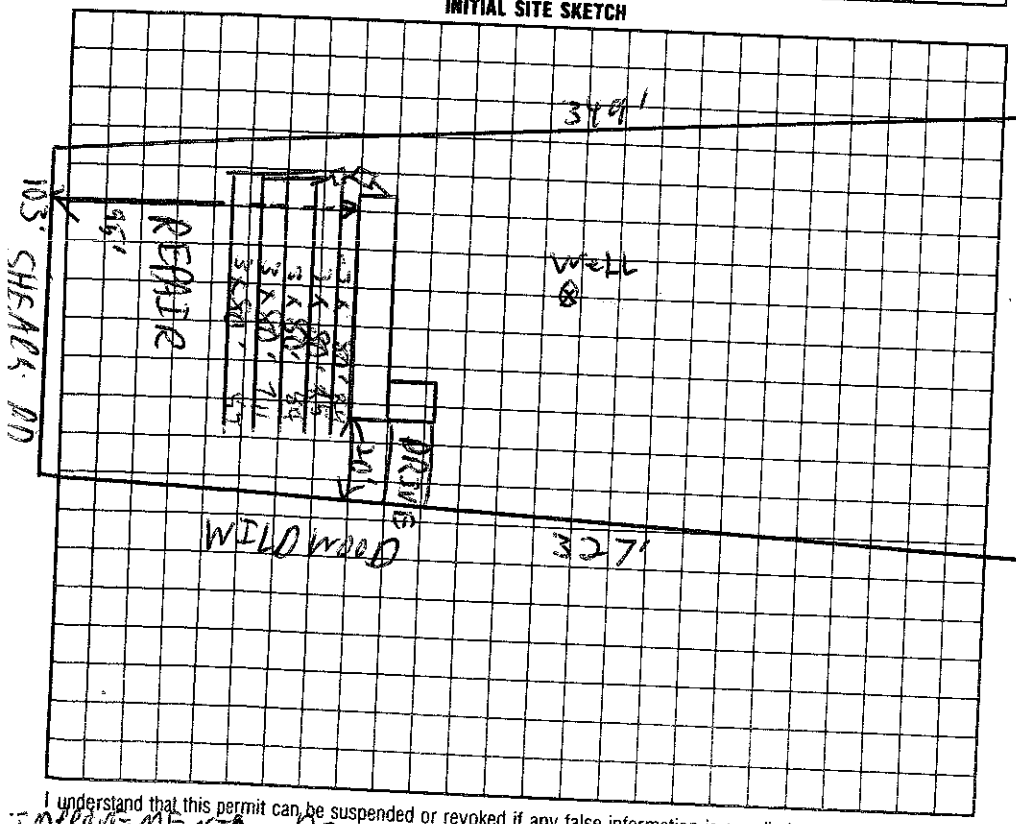

AS BUILT SKETCH

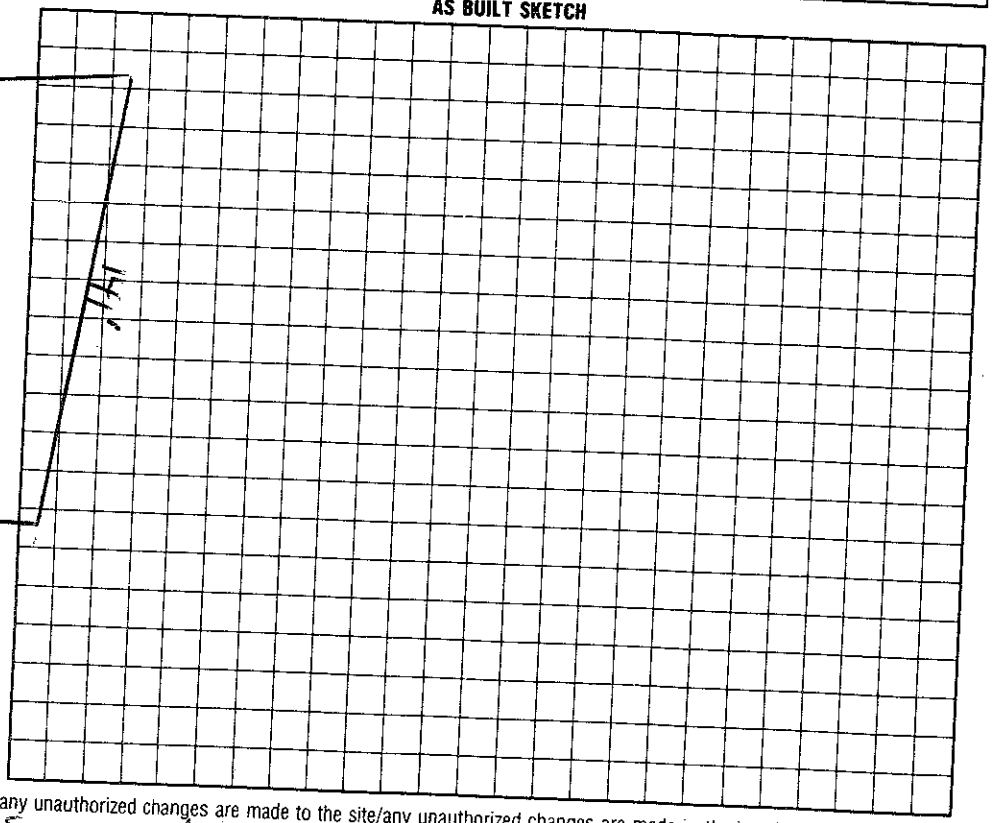

I understand that this permit can be suspended or revoked if any false information is supplied toward securing the permit/any unauthorized changes are made to the site/any unauthorized changes are made in the installation of the system.

IMPROVEMENT PERMIT EXPIRES IN 60 MONTHS.

Signed: Ricky D Fields

Improvement Permit by: C. Parker Thomas EHSI date 7/30/96

Authorization to ~~Existing System Inspection~~ by: C. Parker Thomas EHSI date 7/30/96

Installed by: A-1 BACKHOE

Certificate of Completion by: _____ date _____

Operation Permit by: C. Parker Thomas date 6/23/96

HEALTH DEPT. COPY: WHITE INSPECTION COPY (FINAL): GREEN OWNER COPY (FINAL): YELLOW INSPECTION COPY (INITIAL): PINK OWNER COPY (INITIAL): GOLD

AUTHORIZATION TO CONSTRUCT IS VALID FOR 60 MONTHS FROM ISSUE DATE