GALIHER - 1/28

IREDELL COUNTY HEALTH DEPARTMENT

STATESVILLE 704-878-5305 MOORESVILLE 704-664-5281

IMPROVEMENT PERMIT / AUTHORIZATION TO CONSTRUCT / OPERATION PERMIT / EXISTING SYSTEM INSPECTIO

PERMIT# 074868 PIN# 4665428609 DATE 1/28/99

OWNER OR CONTRACTOR McKNIGHT ENTERPRISES PHONE: Business 664-9050 Home

ADDRESS 255 ROLLING HILLS RD. MOORESVILLE NC 28115

LOCATION SHEARERS RD TO JR BAILEY WOODS ON LT

SUBDIVISION ASHLEY WOODS BLOCK / SECTION LOT 27 LOT AREA .5 AC SITE CLASS. 05 DESIGN FLOW 360 L.T.A.R. -3

Septic Tank: 1000 Gallons; STB 1012 Date 6-4-99
Pump Tank: Gallons; PT Date
Pump Make: Model Serial No.
Nitrification Field: No Fields 1 Square Feet 900 Linear Feet 300
No Lines 3@100 Trench Width 36" Max Trench Bottom Depth 36" Gravel Depth

☐ New System ☐ Repair System Type: I, II, III, IV, V, VI
System Description: GRAVITY CHAMBER
Repair System Description: PANEL
Maintenance Agreement Required: ☐ Yes ☐ No


☐ House/Mod. Home No. Bedrooms 3
☐ Mobile Home No. Bathrooms 2
☐ Business No. Employees
☐ Other
☐ Slab ☑ Crawl Space ☐ Basement w/plumbing ☐ Basement wo/plumbing

Water Supply:
☐ Individual
☐ Public
☑ Community

Comments:/Conditions:

Comments:/Conditions:

INITIAL SITE SKETCH 1"=50'

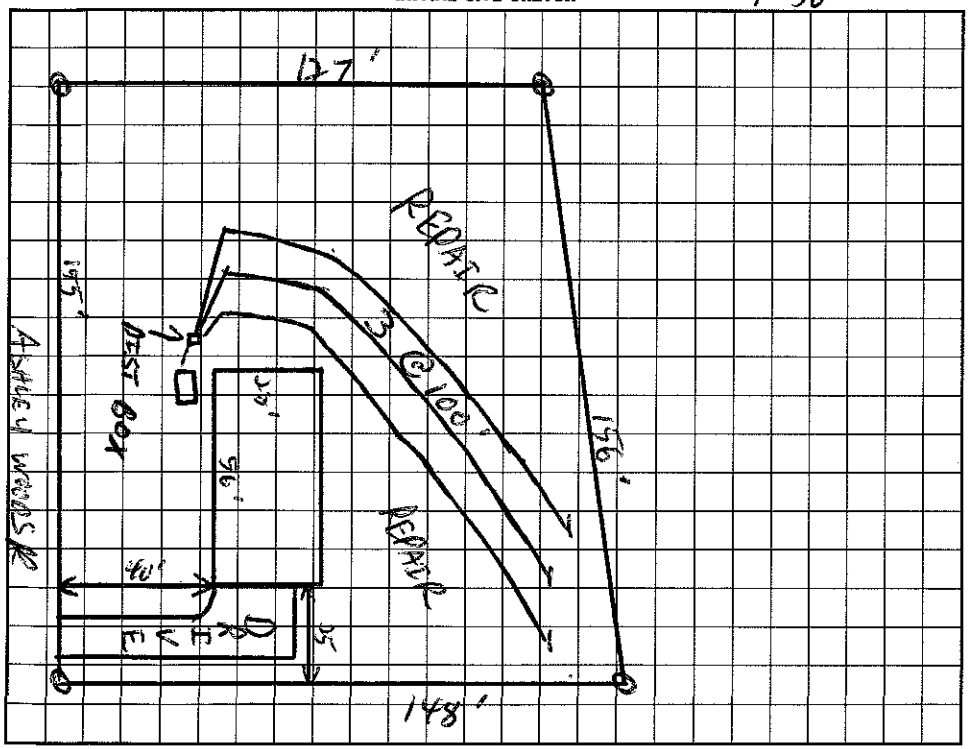

AS BUILT SKETCH

I understand that this permit can be suspended or revoked if any false information is supplied toward securing the permit/any unauthorized changes are made to the site/any unauthorized changes are made in the installation of the system. Improvement Permit with plat valid without expiration. Improvement Permit with site plan valid for sixty months. Authorization to Construct is valid for a period equal to that of Improvement Permit – not to exceed sixty months.

Signed: Lloyd Haun date

Improvement Permit by: [signature] date 1/28/99

Authorization to Construct by: [signature] date 1/28/99

Installed by: A-1 Backhoe

Operation Permit by: [signature] date 8/13/99

Existing System Inspection by: date

HEALTH DEPT. COPY: WHITE INSPECTION COPY (FINAL): GREEN OWNER COPY (FINAL): YELLOW INSPECTION COPY (INITIAL): PINK OWNER COPY (INITIAL): GOLD