4665433687

IREDELL COUNTY HEALTH DEPARTMENT

STATESVILLE 704-878-5305 MOORESVILLE 704-664-5281

IMPROVEMENT PERMIT / CERTIFICATE OF COMPLETION / OPERATION PERMIT / EXISTING SYSTEM INSPECTION

PROPERTY DESCRIPTION NO. REPAIR DATE 7/22/94 TAX MAP NO. REPAIR Watershed: ☐ Yes ☒ No

OWNER OR CONTRACTOR Jerry Mayhew PHONE: Business _____ Home 663-7443

ADDRESS 1380 Sherrills Rd Mooresville, NC 28115

LOCATION 1st House on R past Sherrills Machine Shop

SUBDIVISION _____ BLOCK / SECTION _____ LOT _____ LOT AREA _____ SITE CLASS. _____ DESIGN FLOW _____ L.T.A.R. _____

Septic Tank: EXISTING Gallons; STB _____ Date _____

Pump Tank: _____ Gallons; PT _____ Date _____

Pump Make: _____ Model _____ Serial No. _____

Nitrification Field: No Fields 1 Square Feet 600 Linear Feet 200

No Lines 3 & 4 Trench Width 36" Max Trench Bottom Depth 30" Gravel Depth _____

☐ New System ☑ Repair System Type: I (II) III, IV, V, VI

System Description: DROP BOX - CONV.

Repair System Description: _____

Maintenance Agreement Required: ☐ Yes ☑ No

☑ House/Mod. Home No. Bedrooms 2

☐ Mobile Home No. Bathrooms 1

☐ Business No. Employees _____

☐ Other _____


☐ Slab ☑ Crawl Space ☐ Basement w/plumbing ☐ Basement wo/plumbing

Water Supply: ☑ Individual ☐ Community ☐ Public (2)

Comments: CHECK - REPLACE SANITARY TIF NECESSARY

Comments:

INITIAL SITE SKETCH

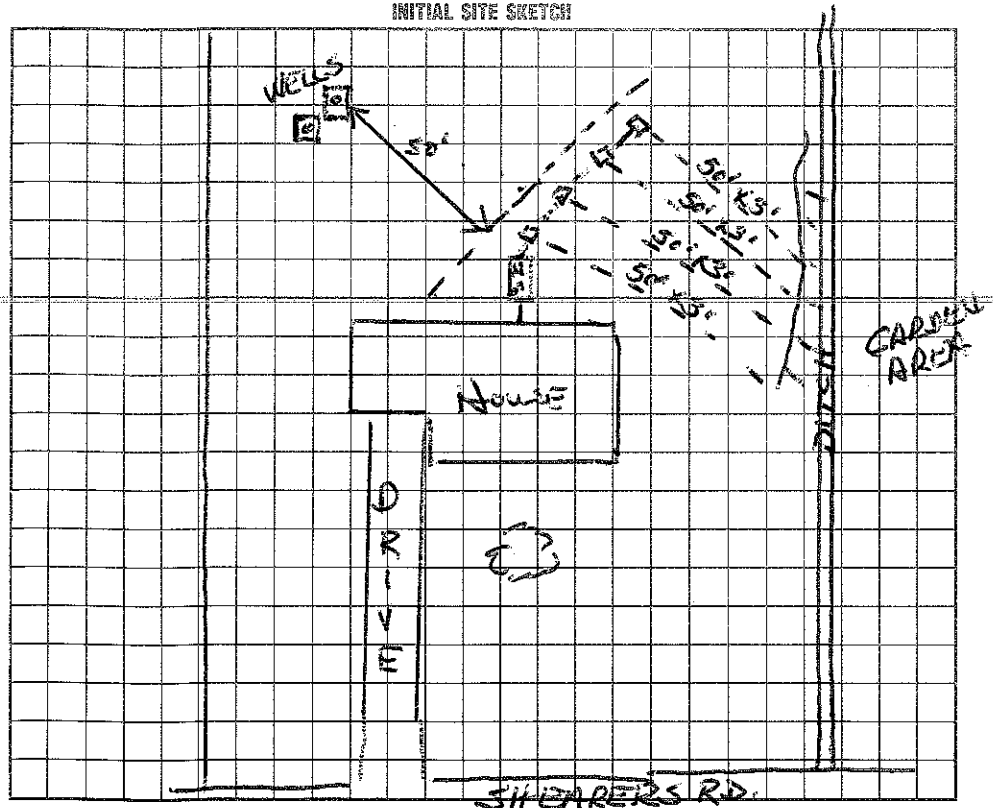

AS BUILT SKETCH

I understand that this permit can be suspended or revoked if any false information is supplied toward securing the permit/any unauthorized changes are made to the site/any unauthorized changes are made in the installation of the system. Improvement Permit is valid for 60 months from date of issuance.

Signed: _____ Installed by: Tim Ammons

Improvement Permit by: Wesley Sparks RS date 7/22/94 Certificate of Completion by: Wesley Sparks RS date 8/8/94

Existing System Inspection by: _____ date _____ Operation Permit by: _____ date _____

HEALTH DEPT. COPY: WHITE INSPECTION COPY (FINAL): GREEN OWNER COPY (FINAL): YELLOW INSPECTION COPY (INITIAL): PINK OWNER COPY (INITIAL): GOLD