ICHD - ENVIRONMENTAL HEALTH DIVISION

Statesville Office (704) 878-5305 | Mooresville Office (704) 660-3625 | PERMIT # AP 314957

SEPTIC: IMPROVEMENT PERMIT / AUTHORIZATION TO CONSTRUCT / OPERATION PERMIT / EXISTING SYSTEM

PIN # 4665 -- 43 -- 9070

APPLICANT/OWNER: Freedom Homes LLC | APPLICANT ADDRESS: 1124 Charlotte Hwy Troutman NC 28166

SITE ADDRESS: 1419 Shearers Rd Mooresville NC 28115 | PHONE: 704-881-2326 | ALT. PHONE 704-528-7960

SITE DIRECTIONS: NC 3 N to R on Sistler Farm Rd, R on Rocky River Rd, L on Shearers Rd, Lot on L | SAP CONTROLLED: [X] YES [ ] NO

SUBDIVISION: Bobby Sherrill Property | SECTION: — | LOT # 3 | LOT AREA: 0.51 acres | DESIGN FLOW: 360GPD | L.T.A.R.: Existing


Septic Tank	Existing (gal)	STB Existing	Date Existing	[ ] New System [ ] Repair [ ] Expansion	System Type: [I] II III IV V VI	[X] Residence	No. Bedrooms 3
Pump Tank	— (gal)	PT —	Date —	System Description: Existing		[ ] Business	No. Persons 6
Pump Make	—	Model —	Serial # —	Repair System Description: Existing		[ ] Other	No. Employees
# Nitrification Fields	1	# Lines 3	Linear Ft 120	Maintenance Agreement Required:	[ ] YES [X] NO	[ ] Slab	[X] Crawl Space
Trench Width	24"	Trench Bottom Depth (Low side)		Gravel Depth Existing	[X] GRAVITY [ ] PRESSURE	[ ] Basement w/plumbing	[ ] Basement w/o plumbing

Water Supply: [X] Private [ ] Public [ ] Community

Comments / Conditions: Do NOT drive on, store material, or manipulate drainfield in any way. At time of inspection no signs of failure


INITIAL SITE SKETCH

1" = 40'

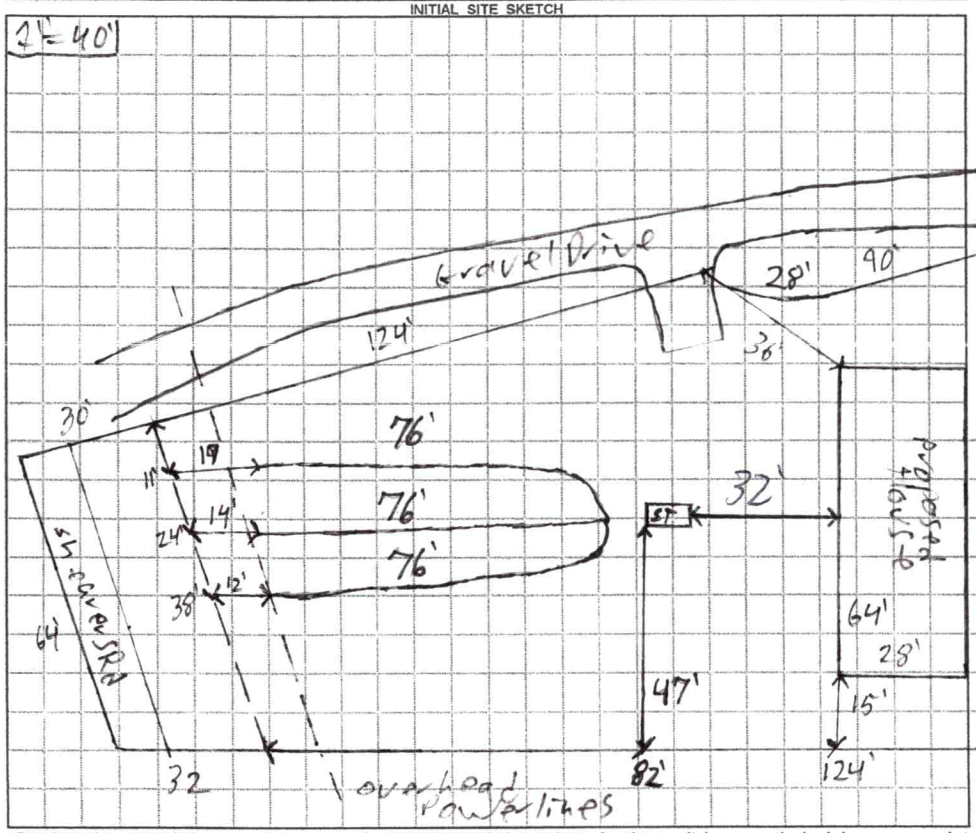

AS BUILT SKETCH

FOR SEPTIC FINAL INSPECTION CALL: 704-664-3703 between 8am-9am the day the inspection is needed. Be sure to speak with an inspector to confirm your time.

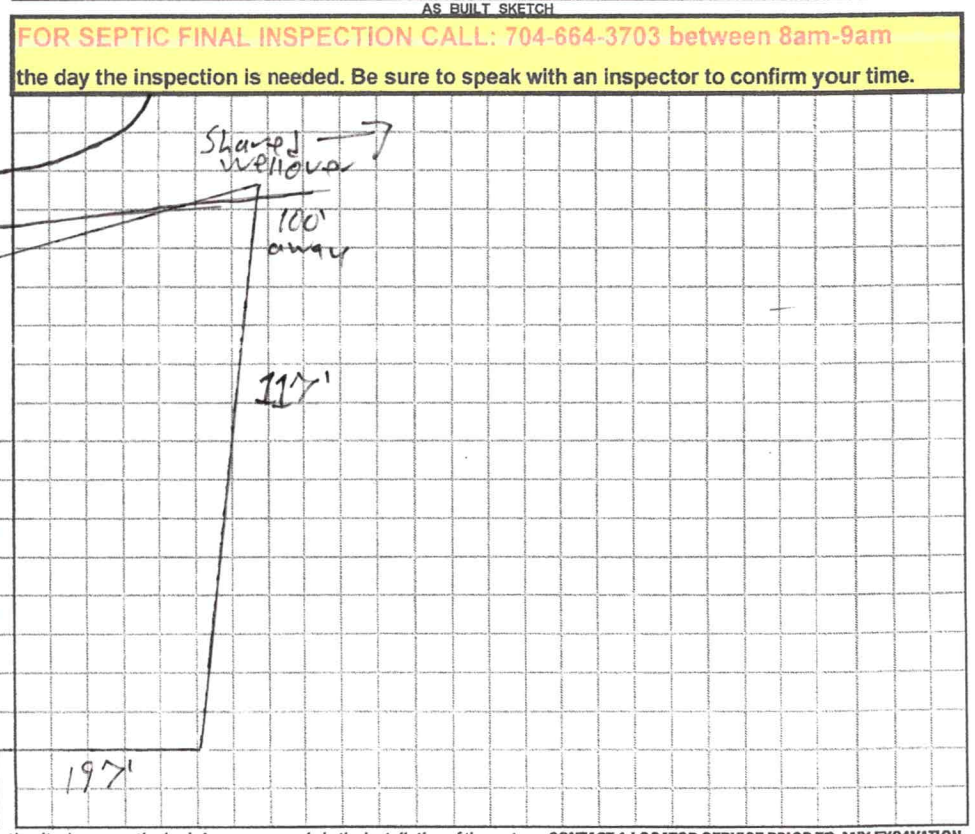

Permit can be suspended or revoked if any false information is supplied toward securing the permit / any unauthorized changes are made to the site / any unauthorized changes are made in the installation of the system. CONTACT A LOCATOR SERVICE PRIOR TO ANY EXCAVATION


[ ] IMPROVEMENT PERMIT *with plat valid without expiration.* [ ] IMPROVEMENT PERMIT *with site plan valid for 60 mos.* [ ] AUTHORIZATION TO CONSTRUCT *valid for period equal to IMPROVEMENT PERMIT--not to exceed 60 mo.*

Owner / Applicant Signature: Kelley Sanz | Date: 4-27-21 | Installed by:

IMPROVEMENT PERMIT by: | Date: | OPERATION PERMIT by: | Date:

AUTHORIZATION TO CONSTRUCT by: | Date: | Existing System Inspected by: Patrick J Boyce III | Date: 3/29/2021

FOR SEPTIC FINAL INSPECTION: CALL 704-664-3703 between 8am-9am the day the inspection is needed.

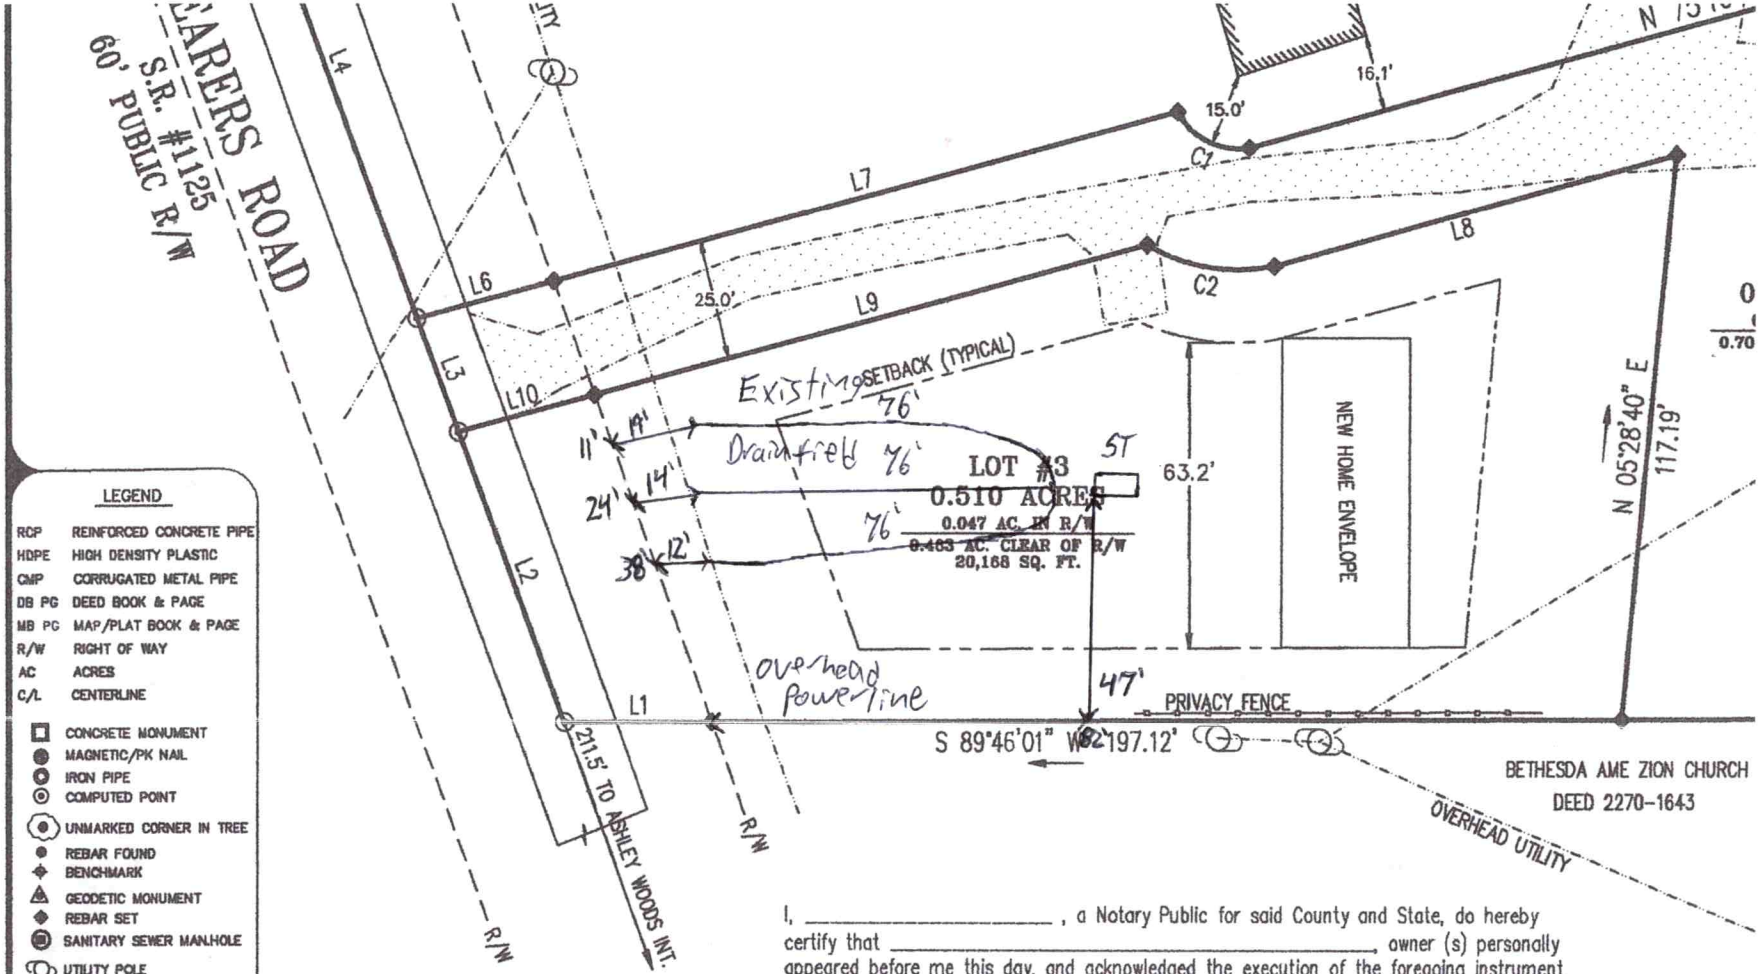

LEGEND

RCP	REINFORCED CONCRETE PIPE
HDPE	HIGH DENSITY PLASTIC
CMP	CORRUGATED METAL PIPE
DB PG	DEED BOOK & PAGE
MB PG	MAP/PLAT BOOK & PAGE
R/W	RIGHT OF WAY
AC	ACRES
C/L	CENTERLINE

- CONCRETE MONUMENT
- MAGNETIC/PK NAIL
- IRON PIPE
- COMPUTED POINT
- UNMARKED CORNER IN TREE
- REBAR FOUND
- BENCHMARK
- GEODETIC MONUMENT
- REBAR SET
- SANITARY SEWER MANHOLE
- UTILITY POLE
- HVAC
- WATER WELL
- WATER VALVE
- HYDRANT

- BOUNDARY LINE (AS SURVEYED)
- TIE LINE (NO SCALE)
- WOODLINE
- FENCE
- EDGE OF GRAVEL
- CURB & GUTTER
- BOUNDARY LINE (BY REFERENCE)
- RIGHT-OF-WAY LINE
- EASEMENT LINE
- TIE LINE
- OVERHEAD POWER LINE
- CENTERLINE OF BRANCH / CREEK
- FEMA 100 YEAR FLOOD LINE

LINE	BEARING	DISTANCE
L1	S 89°46'01" W	32.17'
L2	N 20°55'23" W	64.34'
L3	N 20°55'22" W	25.15'
L4	N 20°55'22" W	110.50'
L5	N 73°42'10" E	30.37'
L6	N 75°25'34" E	30.36'
L7	N 75°25'34" E	139.70'
L8	S 75°10'05" W	89.82'
L9	S 75°25'34" W	123.74'
L10	S 75°25'34" W	30.34'

CURVE	RADIUS	ARC LENGTH	CHORD LENGTH	CHORD BEARING	DELTA ANGLE
C1	15.00'	18.28'	17.17'	S 64°26'42" E	69°49'23"
C2	40.00'	28.42'	27.82'	N 81°07'43" W	40°42'09"

I, _____, a Notary Public for said County and State, do hereby certify that _____, owner (s) personally appeared before me this day, and acknowledged the execution of the foregoing instrument. Witness my hand and official seal, this ____ day of _____, 2019.


_____
Notary Public
My Commission Expires: _____

This property, or portions thereof, is not located within one half (1/2) mile of a designated (Enhanced) Farmland Preservation District

As of the date of this recording, the lots represented on this plat have not been inspected or approved by the Iredell County Health Department. Until inspected, there is no assurance that a building permit will be issued.

SUBDIVISION NOTES:
1. TOTAL ACREAGE TO BE DIVIDED: 2.466
2. NUMBER OF NEW PARCELS CREATED: 3
3. ACREAGE IN THE SMALLEST LOT: 0.469
4. ALL LOTS SHALL HAVE INDIVIDUAL SEPTIC SYSTE
5. A 10' DRAINAGE AND UTILITY EASEMENT SHALL EXIST ALONG ALL LOT LINES

Not A Permit

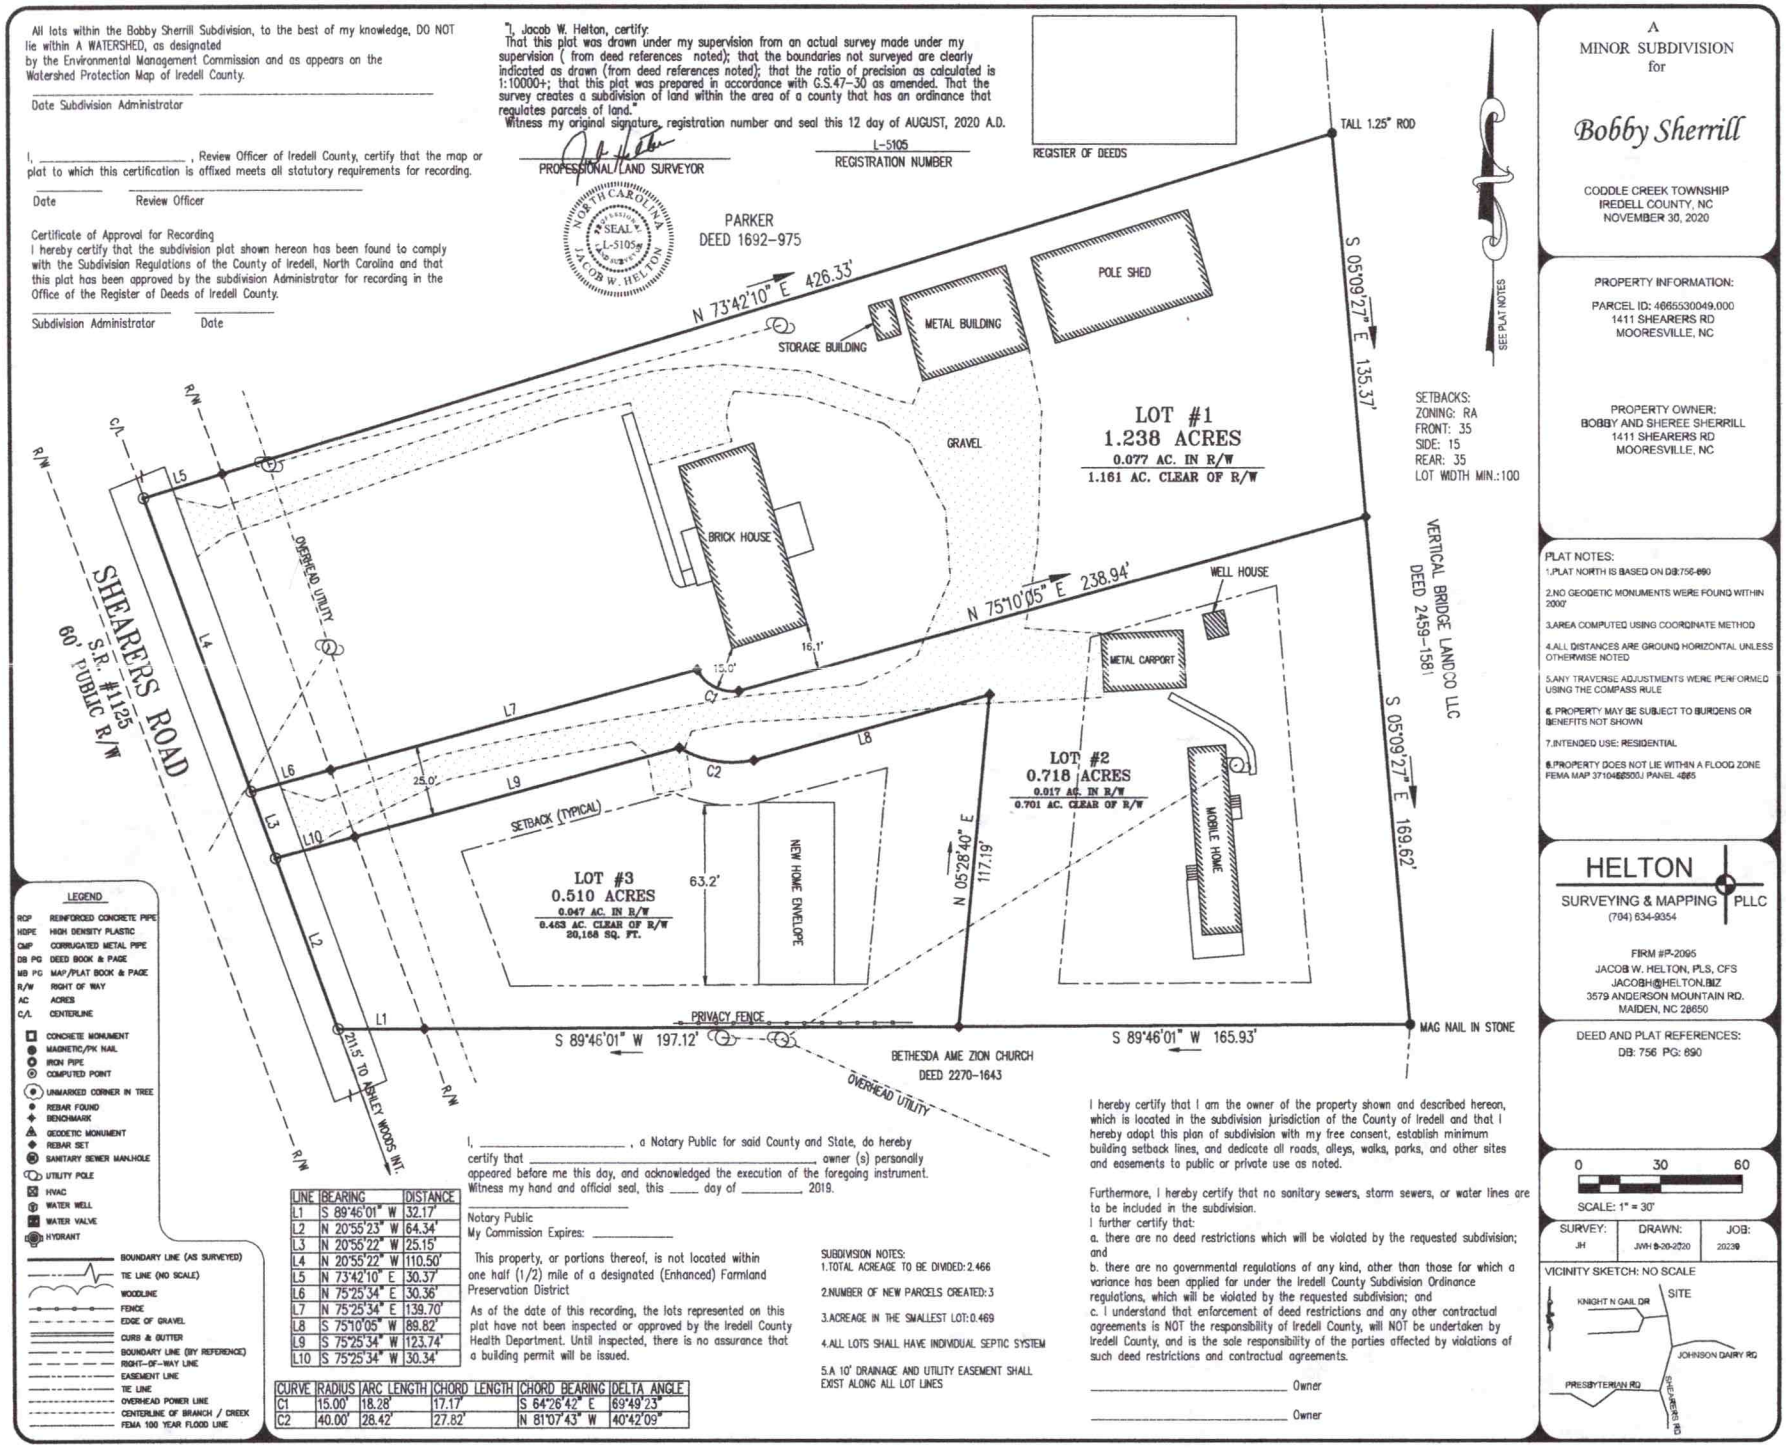
All lots within the Bobby Sherrill Subdivision, to the best of my knowledge, DO NOT lie within A WATERSHED, as designated by the Environmental Management Commission and as appears on the Watershed Protection Map of Iredell County.
Date Subdivision Administrator
I, _____, Review Officer of Iredell County, certify that the map or plat to which this certification is affixed meets all statutory requirements for recording.
Date
Review Officer
Certificate of Approval for Recording
I hereby certify that the subdivision plat shown hereon has been found to comply with the Subdivision Regulations of the County of Iredell, North Carolina and that this plat has been approved by the subdivision Administrator for recording in the Office of the Register of Deeds of Iredell County.
Subdivision Administrator
Date
I, Jacob W. Helton, certify:
That this plat was drawn under my supervision from an actual survey made under my supervision (from deed references noted); that the boundaries not surveyed are clearly indicated as drawn (from deed references noted); that the ratio of precision as calculated is 1:10000+; that this plat was prepared in accordance with G.S.47-30 as amended. That the survey creates a subdivision of land within the area of a county that has an ordinance that regulates parcels of land."
Witness my original signature, registration number and seal this 12 day of AUGUST, 2020 A.D.
PROFESSIONAL LAND SURVEYOR
L-5105
REGISTRATION NUMBER
NORTH CAROLINA SEAL L-5105 JACOB W. HELTON
REGISTER OF DEEDS
PARKER DEED 1692-975
TALL 1.25" ROD
N 73°42'10" E 426.33'
S 05°09'27" E 135.37'
SEE PLAT NOTES
POLE SHED
METAL BUILDING
STORAGE BUILDING
GRAVEL
LOT #1
1.238 ACRES
0.077 AC. IN R/W
1.161 AC. CLEAR OF R/W
SETBACKS:
ZONING: RA
FRONT: 35
SIDE: 15
REAR: 35
LOT WIDTH MIN.: 100
R/W
C/L
L5
SHEARERS ROAD
S.R. #1125
60' PUBLIC R/W
OVERHEAD UTILITY
BRICK HOUSE
16.1'
15.0'
C1
N 75°10'05" E 238.94'
WELL HOUSE
METAL CARPORT
VERTICAL BRIDGE LANDCO LLC
DEED 2459-158
S 05°09'27" E 169.62'
L7
L8
L6
25.0'
L9
C2
L3
L10
SETBACK (TYPICAL)
LOT #2
0.718 ACRES
0.017 AC. IN R/W
0.701 AC. CLEAR OF R/W
LOT #3
0.510 ACRES
0.047 AC. IN R/W
0.463 AC. CLEAR OF R/W
20,168 SQ. FT.
63.2'
NEW HOME ENVELOPE
N 05°28'40" E 117.19'
MOBILE HOME
L2
L1
PRIVACY FENCE
S 89°46'01" W 197.12'
S 89°46'01" W 165.93'
MAG NAIL IN STONE
BETHESDA AME ZION CHURCH
DEED 2270-1643
OVERHEAD UTILITY
21.5' TO ASHLEY WOODS INT.
R/W
A
MINOR SUBDIVISION
for
Bobby Sherrill
CODDLE CREEK TOWNSHIP
IREDELL COUNTY, NC
NOVEMBER 30, 2020
PROPERTY INFORMATION:
PARCEL ID: 4665530049.000
1411 SHEARERS RD
MOORESVILLE, NC
PROPERTY OWNER:
BOBBY AND SHEREE SHERRILL
1411 SHEARERS RD
MOORESVILLE, NC
PLAT NOTES:
1.PLAT NORTH IS BASED ON DB:756-890
2.NO GEODETIC MONUMENTS WERE FOUND WITHIN 2000'
3.AREA COMPUTED USING COORDINATE METHOD
4.ALL DISTANCES ARE GROUND HORIZONTAL UNLESS OTHERWISE NOTED
5.ANY TRAVERSE ADJUSTMENTS WERE PERFORMED USING THE COMPASS RULE
6. PROPERTY MAY BE SUBJECT TO BURDENS OR BENEFITS NOT SHOWN
7.INTENDED USE: RESIDENTIAL
8.PROPERTY DOES NOT LIE WITHIN A FLOOD ZONE FEMA MAP 3710468500J PANEL 4685
HELTON
SURVEYING & MAPPING PLLC
(704) 634-9354
FIRM #P-2095
JACOB W. HELTON, PLS, CFS
JACOBH@HELTON.BIZ
3579 ANDERSON MOUNTAIN RD.
MAIDEN, NC 28650
DEED AND PLAT REFERENCES:
DB: 756 PG: 890
0 30 60
SCALE: 1" = 30'
SURVEY: JH
DRAWN: JWH 8-26-2020
JOB: 20239
VICINITY SKETCH: NO SCALE
SITE
KNIGHT N GAIL DR
JOHNSON DAIRY RD
PRESBYTERIAN RD
SHEARERS RD
LEGEND
RCP REINFORCED CONCRETE PIPE
HDPE HIGH DENSITY PLASTIC
CMP CORRUGATED METAL PIPE
DB PG DEED BOOK & PAGE
MB PG MAP/PLAT BOOK & PAGE
R/W RIGHT OF WAY
AC ACRES
C/L CENTERLINE
CONCRETE MONUMENT
MAGNETIC/PK NAIL
IRON PIPE
COMPUTED POINT
UNMARKED CORNER IN TREE
REBAR FOUND
BENCHMARK
GEODETIC MONUMENT
REBAR SET
SANITARY SEWER MANHOLE
UTILITY POLE
HVAC
WATER WELL
WATER VALVE
HYDRANT
BOUNDARY LINE (AS SURVEYED)
TIE LINE (NO SCALE)
WOODLINE
FENCE
EDGE OF GRAVEL
CURB & GUTTER
BOUNDARY LINE (BY REFERENCE)
RIGHT-OF-WAY LINE
EASEMENT LINE
TIE LINE
OVERHEAD POWER LINE
CENTERLINE OF BRANCH / CREEK
FEMA 100 YEAR FLOOD LINE
LINE BEARING DISTANCE
L1 S 89°46'01" W 32.17'
L2 N 20°55'23" W 64.34'
L3 N 20°55'22" W 25.15'
L4 N 20°55'22" W 110.50'
L5 N 73°42'10" E 30.37'
L6 N 75°25'34" E 30.36'
L7 N 75°25'34" E 139.70'
L8 S 75°10'05" W 89.82'
L9 S 75°25'34" W 123.74'
L10 S 75°25'34" W 30.34'
CURVE RADIUS ARC LENGTH CHORD LENGTH CHORD BEARING DELTA ANGLE
C1 15.00' 18.28' 17.17' S 64°26'42" E 69°49'23"
C2 40.00' 28.42' 27.82' N 81°07'43" W 40°42'09"
I, _____, a Notary Public for said County and State, do hereby certify that _____, owner (s) personally appeared before me this day, and acknowledged the execution of the foregoing instrument. Witness my hand and official seal, this _____ day of _____, 2019.
Notary Public
My Commission Expires: _____
This property, or portions thereof, is not located within one half (1/2) mile of a designated (Enhanced) Farmland Preservation District
As of the date of this recording, the lots represented on this plat have not been inspected or approved by the Iredell County Health Department. Until inspected, there is no assurance that a building permit will be issued.
SUBDIVISION NOTES:
1.TOTAL ACREAGE TO BE DIVIDED: 2.466
2.NUMBER OF NEW PARCELS CREATED: 3
3.ACREAGE IN THE SMALLEST LOT: 0.469
4.ALL LOTS SHALL HAVE INDIVIDUAL SEPTIC SYSTEM
5.A 10' DRAINAGE AND UTILITY EASEMENT SHALL EXIST ALONG ALL LOT LINES
I hereby certify that I am the owner of the property shown and described hereon, which is located in the subdivision jurisdiction of the County of Iredell and that I hereby adopt this plan of subdivision with my free consent, establish minimum building setback lines, and dedicate all roads, alleys, walks, parks, and other sites and easements to public or private use as noted.
Furthermore, I hereby certify that no sanitary sewers, storm sewers, or water lines are to be included in the subdivision.
I further certify that:
a. there are no deed restrictions which will be violated by the requested subdivision; and
b. there are no governmental regulations of any kind, other than those for which a variance has been applied for under the Iredell County Subdivision Ordinance regulations, which will be violated by the requested subdivision; and
c. I understand that enforcement of deed restrictions and any other contractual agreements is NOT the responsibility of Iredell County, will NOT be undertaken by Iredell County, and is the sole responsibility of the parties affected by violations of such deed restrictions and contractual agreements.
_____ Owner
_____ Owner


Sherrill

Acknowledgement Of
Plans Submittal ONLY!

* Date 2-12-2021

Date 3/15/2021

28x64

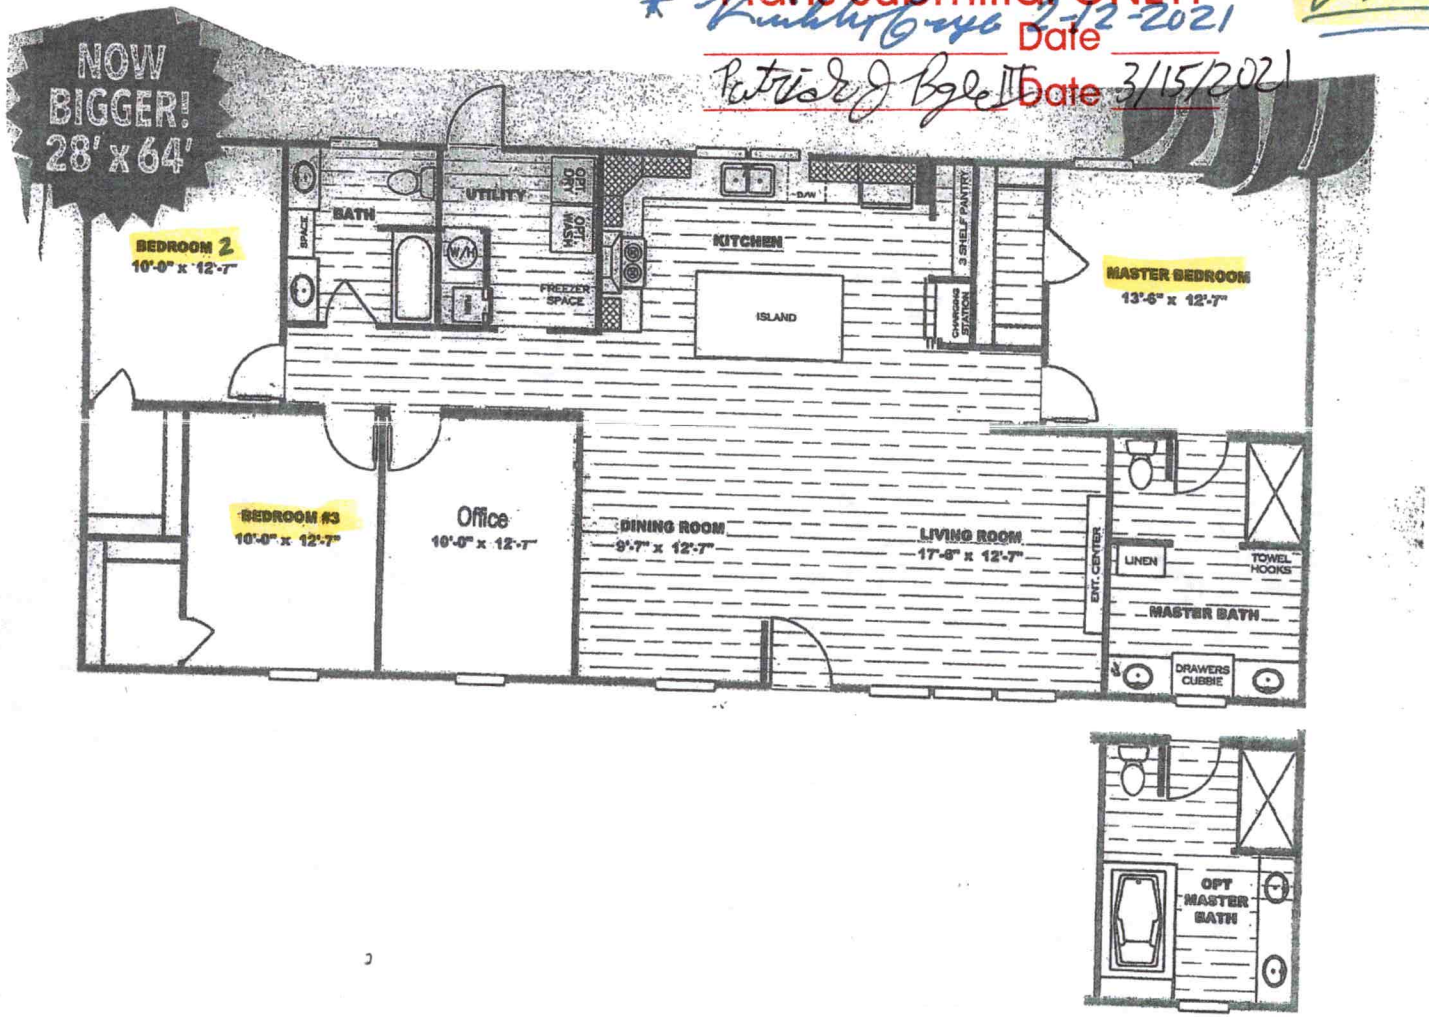

APPLICATION MUST BE FILLED OUT COMPLETELY & BE LEGIBLE
OR IT WILL NOT BE PROCESSED

Iredell County Health Department – Environmental Health Division

PAGE 1: *APPLICATION FORM*

Application For: ( ) New Well Permit ( ) Well Repair Permit ( ) Well Abandonment
( ) Septic Improvement Permit ( ) Authorization to Construct (X) Existing System Inspection ( ) Septic System Repair

THE ABOVE PERMIT DOCUMENTS WILL BECOME INVALID IF INFORMATION PROVIDED ON THIS APPLICATION IS FALSIFIED OR CHANGED, OR IF THE SITE IS ALTERED. THE IMPROVEMENT PERMIT IS VALID FOR EITHER 60 MONTHS OR WITHOUT EXPIRATION DEPENDING UPON DOCUMENTATION SUBMITTED. APPLICATION WITH SITE PLAN 60 MONTHS, APPLICATION WITH COMPLETE, SCALED PLAT WITHOUT EXPIRATION. SEE 15A NCAC 18A .1937(f) FOR DETAILS.

Page 2: *Site Plan Worksheet* form MUST accompany this application

The following optional attachments may also be submitted: ( ) Survey Plat, scaled no more than 1 inch = 60 feet
Place an (X) beside whichever is submitted if applicable (X) Custom Site Plan, scaled no more than 1 inch = 60 feet

Applicant Information: (PRINT CLEARLY)

Applicant Name: Freedom Homes / Kimberly Frye **Address:** 1124 Charlotte Hwy Troutman NC **Zip:** 28166
Applicant Email: Kimsneed.Sneed04@gmail.com **Phone:** 704-881-2326 **Alt. Phone:** 704-528-7960
Owner Name: Bobby Sherrill **Address:** 1411 Shearers Rd Mooresville, NC **Zip:** 28115
Owner Email: _____ **Phone:** 704-305-3491 **Alt. Phone:** _____

Property Information:

Street Address: 1419 Shearers Rd Mooresville, NC 28115

Subdivision Name: _____ **Section/Phase:** _____ **Lot Number:** _____

Driving Directions: I-77 toward Charlotte, Exit 33 (L) onto Williamson Rd, Straight Charlotte Hwy, (R) Fairview Rd, (R) onto Meck Hwy, (L) Faith Rd, (R) Shearers Rd Lot on Left

Site Development Information: *(check or complete ALL that apply*

(X) New Single Family Residence
( ) New Multi-Family Residence
( ) Accessory Building
( ) Bedroom(s) Addition
( ) Repair to failing septic system ___ Tank ___ Drain lines Describe Problem: _____
Non-Residential Site Development: Type of Business: _____
Square Footage of Building: _____ Max. Number of Employees: _____ Max. Number of Seats/Beds/Other: _____

Maximum Number of Bedrooms: 3
Maximum Number of Occupants: 2
( ) Swimming Pool
( ) Other Addition/Structure: _____

CHECK FOUNDATION TYPE
(X) Crawl Space Foundation
( ) Concrete Slab Foundation
( ) Basement with Plumbing
( ) Basement without Plumbing

Water Supply: ( ) Replacement Well – Reason: _____
*Shared well (X) Multi-connection Well Number of Houses: 2 Number of Persons: 3
( ) New Well ( ) Existing Well ( ) Community Well ( ) City Water ( ) Other Public Water

Desired Septic System Type: *(you may rank in order of preference)* Year existing system installed: _____
( ) No Preference ( ) Alternative (X) Conventional ( ) Innovative ( ) Modified Conventional ( ) Other: _____

Please answer the following to the best of your ability:
( ) Yes (X) No Does the site contain any jurisdictional wetlands?
( ) Yes (X) No Is any non-domestic sewage (i.e. industrial) to be generated?
( ) Yes (X) No Is the site subject to approval by any other public agency?

I have read this application and certify that the information provided herein is true, complete, and correct. Authorized county and state officials are granted right of entry to conduct necessary inspections to determine compliance with applicable laws and rules. I understand that I am solely responsible for the proper identification and labeling of all property lines and corners and making the site accessible so that a complete site evaluation can be performed.


Signature: Kimberly Frye 2-12-2021
Property owner or owner's legal representative signature (SIGNATURE REQUIRED) DATE

IREDELL COUNTY HEALTH DEPARTMENT

ENVIRONMENTAL HEALTH DIVISION

PAGE 2: *SITE PLAN WORKSHEET*

SEE THE "SAMPLE SITE PLAN" BELOW. INCOMPLETE SITE PLANS WILL BE RETURNED TO YOU FOR COMPLETION AND MAY RESULT IN A DELAY IN THE ISSUANCE OF YOUR SEPTIC SYSTEM PERMIT!!!

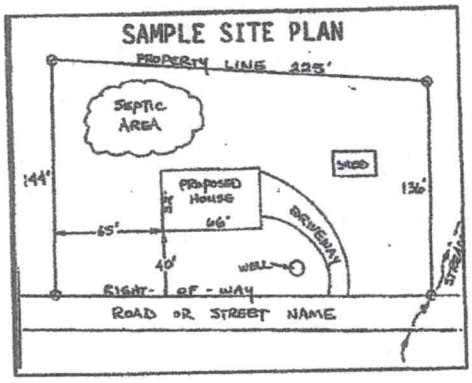

Place an (X) beside each item as you complete the site plan:

- (X) **Property Line measurements are clearly identified**
- (X) **All proposed structures are indicated**
- (X) **Front and side setbacks from property line**
- (X) **Preferred driveway location and well location**
- (X) **Area you prefer your septic system to be placed**
- ( ) **North arrow, or other sufficient indicator of direction**

Circle N/A on the following if appropriate:

Location of septic systems and wells within 100' of your property (N/A)
Location of easements and rights of ways on your property (N/A)
Location of any designated wetlands on the property (N/A)

USE THIS SPACE TO DRAW YOUR SITE PLAN

Show: proposed house or business footprint, wells, water lines, patios, pools and decks, and any other item that will occupy space on the site

Attached

Signature: _____
Property owner or owner's legal representative signature (SIGNATURE REQUIRED)


2-12-2021
DATE

PLOT PLAN

N.T.S.

Sherrill

TBD Shearers Rd.
Mooresville, NC

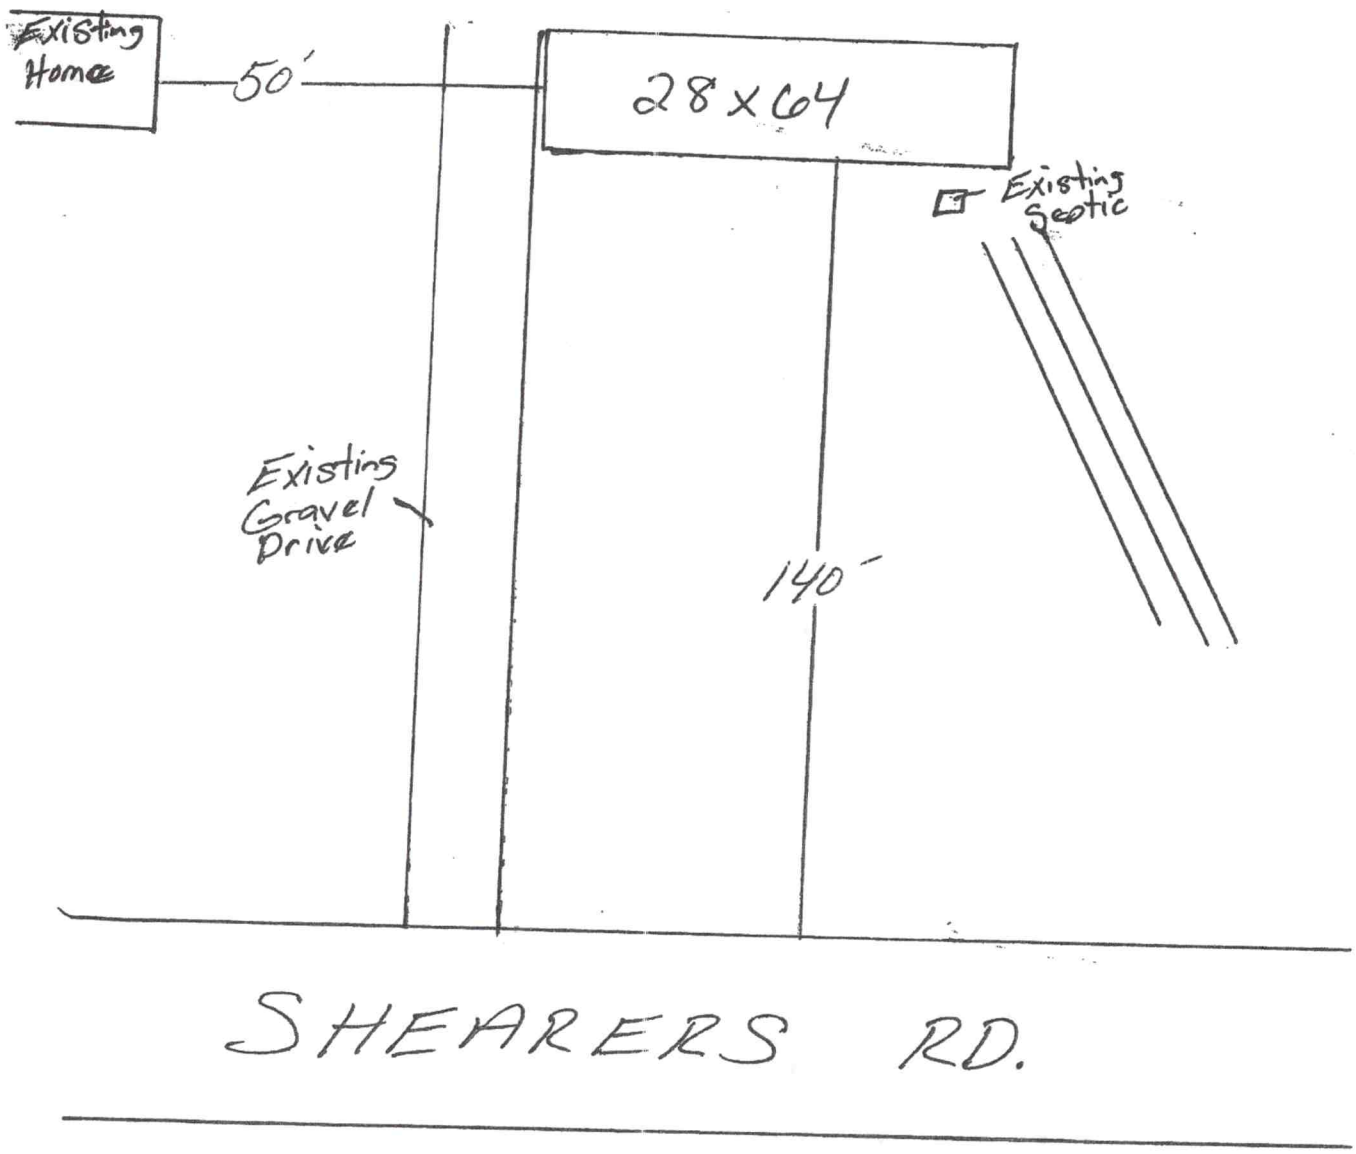

DOCUMENTATION TO AUTHORIZE AN OWNER'S LEGAL REPRESENTATIVE

Applications for permits require the "signature of the owner or owner's legal representative" (15A NCAC 18A .1937). If the owner does not sign the application himself or herself, they can submit any one of the following documents to designate their legal representative:

Power of Attorney; Real Estate Contract; Estate executor; Bankruptcy trustee; Court ordered guardianship

In the absence of the above documentation, the property owner may provide the local health department with documentation that designates a legal representative. A property owner may:
Complete this form to document his or her legal representative, or provide his or her own form that contains the information in this form.
If there are multiple property owners, then all property owners must sign the form that designates a legal representative.

By signing a form that designates a legal representative for purposes of 15A NCAC 18A .1937, the property owner authorizes that representative to act on their behalf in matters pertaining to the application and permitting process, including signing or receiving any application, document or permit. The owner retains full responsibility to meet all permit conditions specified by the local health department.

I, Bobby D. Sherrill, am the legal owner(s) of the property located at 1419 Shearers Rd Mooresville, NC 28115, identified as PIN (Parcel Identification Number) 4665-43-9070, located in Iredell County, North Carolina.

I do hereby authorize (**print legal representative/company name**) Kimberly Frye, to act as an agent on my behalf in applying for/signing/obtaining any of the documents described below.

- Application for Improvement Permit (IP) / Authorization to Construct (AC)
- Improvement Permit (IP) / Authorization to Construct (AC)
- Application for soil-site evaluation (new/repair)
- Application/permit for private drinking water well/well abandonment
- Application for Compliance Inspection

I agree to abide by all decisions and/or conditions between the legal representative acting on my behalf and the Iredell County Department of Public Health, Environmental Health Division.

Bobby D Sherrill — Signature of Owner(s) — 8-19-2020 — Date

[signature] — Signature of Witness — 8-19-20 — Date

Please return this signed form to the appropriate office:

Mooresville - Environmental Health
ronda.hart@co.iredell.nc.us
Fax: 704-662-3239
610 E. Center Avenue, Mooresville, NC 28115

Statesville - Environmental Health
adrienne.shea@co.iredell.nc.us
Fax: 704-871-3483
349 N. Center Street, Statesville, NC 28677

ENVIRONMENTAL HEALTH REQUIREMENTS for SEPTIC and WELL PERMITS

The following items must be completed *PRIOR* to the *SUBMITTAL* of any Environmental Health Application. Incomplete applications will be returned to the applicant and cannot be processed or placed on the work list.

** *Initial all lines below to indicate you have submitted each form and completed every site requirement* **

KH **Complete all Environmental Health forms:**

_____ Application
_____ Site Plan including the dimensions of proposed structure, addition, pool etc.
_____ Documentation to Authorize Owner Agent (even if the property owner is the applicant -- complete section 1 or 2)
_____ Copy of Zoning Permit when applicable
_____ Sign this sheet after you have completed all items

KH **Lot must be cleared of heavy undergrowth.** In order to evaluate the lot, the footprint of the proposed structure must be visible. Adequate area for the septic drain field and repair area must be sufficiently cleared of heavy undergrowth, with 50 feet of visibility in all directions. Inspectors must be able to evaluate the property, shoot laser level elevations, layout the drain field, do soils work, etc. **If the lot is not cleared sufficiently, then a $100 site revisit fee will be charged and the evaluation will be put on HOLD until the requirement is met.**

KH **Clearly mark all property corners by locating existing iron or concrete markers.** Flag all property lines every 25 feet if adjacent corners are not visible when standing on any given corner. Property lines must be flagged by a licensed NC surveyor & easily identified **prior to application submittal** (exception may apply for septic repair evaluations only). 'Mow lines' and/or fence lines do NOT constitute marked lines. **If the property lines are not properly marked when the lot is ready to be evaluated, then the application will be put on HOLD and a $100 site re-visit fee charged.**

KH **Stake or flag the footprint of the proposed structure, addition, pool etc. to match the site plan submitted.** The propose structure, etc. must be staked out on the property as per the site plan.

KH **If an Authorization to Construct (AC) is desired,** submit a recorded copy of the plat for newly created or subdivided lot(s) ar a LEGIBLE copy of the basic floor plan no larger than 8 ½" x 14" for each floor of the structure including decks, porches, etc. **The overall dimensions must be clearly noted & the rooms labeled.**

Any site not meeting the above requirements when staff arrives for the evaluation will result in a $100 site revisit fee being charged and the request being placed on HOLD. This will delay the processing of the application. *Once work by Environmental Health staff begins, the up-front fees paid toward securing any health department permit are nonrefundable. Refunds for work not started, due to a customer changing their mind or plans, are subject to an administrative fee of $50 to defray a portion of the costs of processing the refund.*

Backhoe pits are required for all applications that require a soils evaluation.
DO NOT DIG PITS UNTIL THE EH SPECIALIST HAS AUTHORIZED AND SCHEDULED YOUR EVALUATION TIME.

- All utilities shall be marked before pits are dug. Call NC 811 for this service.
- The applicant/agent is responsible for securing these services
- Backhoe pits are to be dug at the locations and depths determined by the Environmental Health Specialist or a NC Licensed Soil Scientist. A minimum of four pits must be dug.
- The EH specialist will contact you when your application is ready to be processed for pit scheduling.
- Your backhoe operator must be on site during the EH Specialist's evaluation to prevent your operator from having to return to the property for additional work.

By signing below, I am acknowledging the above specifications have been met and the site is READY to be evaluated AND I understand the backhoe pit requirement and will secure those services (if applicable).

Signature Kirby Cox **Date** 2-12-2021

Questions? Contact the Environmental Health Offices below:

Statesville Office
349 North Center Street (2nd Floor Building Standards)
Statesville, NC 28677-4063
Phone: (704)878-5305 ext. 3456

Mooresville Office
610 East Center Avenue (2nd Floor Govt. Center South)
Mooresville, NC 28115-2548
Phone: (704)660-3625