3:30

IREDELL COUNTY HEALTH DEPARTMENT

STATESVILLE 704-878-5305 MOORESVILLE 704-664-5281

IMPROVEMENT PERMIT / AUTHORIZATION TO CONSTRUCT / OPERATION PERMIT / EXISTING SYSTEM INSPECTION

PERMIT# 093974 PIN# 4665 33 6444 Pt / 4065420 11 DATE 1/30/01

OWNER OR CONTRACTOR Ben Johnson PHONE: Business 704-637-4417 Home

ADDRESS 1358 Shoemes Rd. Mooresville, NC. 28115

LOCATION Shoemes Rd. S TR 1358 follow driveway to rear of property

SUBDIVISION BLOCK / SECTION LOT LOT AREA 1-2.0 AC SITE CLASS. PS DESIGN FLOW 360 L.T.A.R. .3

Septic Tank: 1000 Gallons; STB 1017 Date 4/24/01

Pump Tank: Gallons; PT Date

Pump Make: Model Serial No.

Nitrification Field: No Fields 1 Square Feet 1200 Linear Feet 400

No Lines 3@133' Trench Width 3' Max Trench Bottom Depth 3' Gravel Depth 12"

☒ New System ☐ Repair System Type: I. II. III. IV. V. VI.

System Description: Drw - Conventional

Repair System Description: Same

Maintenance Agreement Required: ☐ Yes ☒ No

☒ House/Mod. Home No. Bedrooms 3

☐ Mobile Home No. Bathrooms 3

☐ Business No. Employees


☐ Other

☐ Slab ☒ Crawl Space ☐ Basement w/plumbing ☐ Basement wo/plumbing

Water Supply: ☒ Individual ☐ Public ☐ Community

Comments:/Conditions:

INITIAL SITE SKETCH

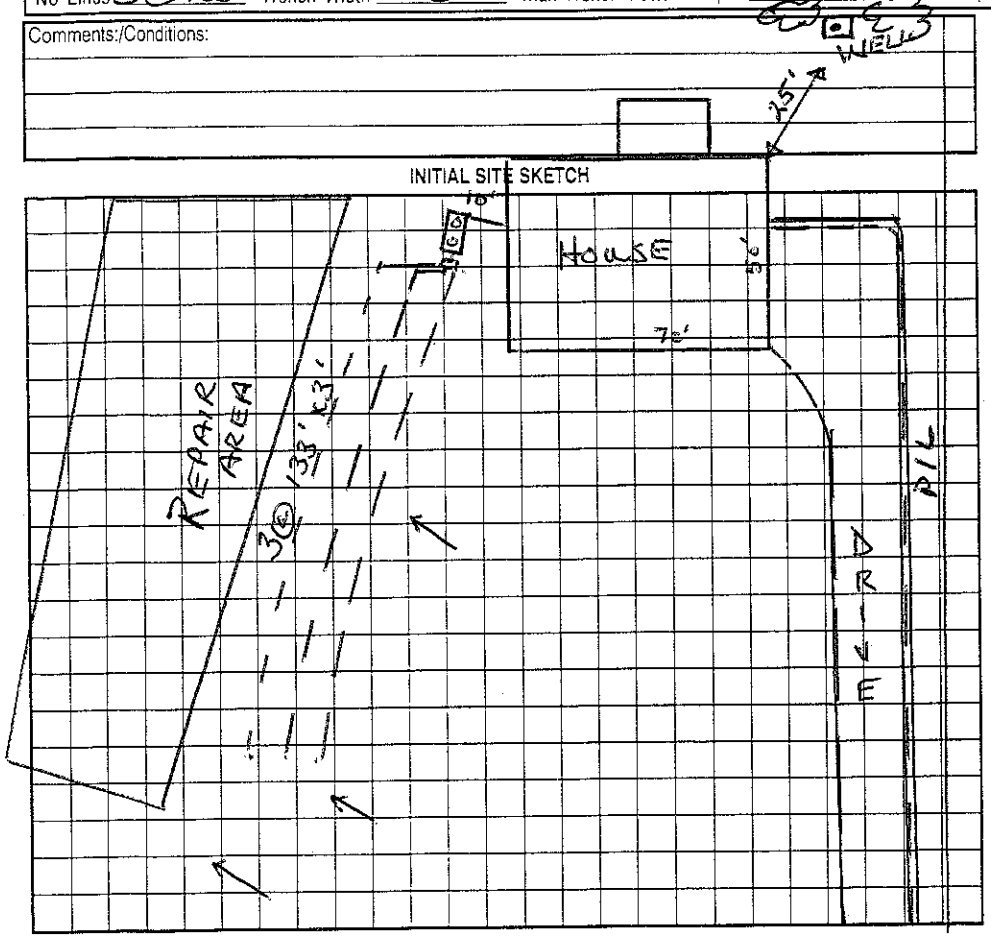

Comments:/Conditions:

AS BUILT SKETCH

Permit can be suspended or revoked if any false information is supplied toward securing the permit/any unauthorized changes are made to the site/any unauthorized changes are made in the installation of the system. Improvement Permit with plat valid without expiration. Improvement Permit with site plan valid for sixty months. Authorization to Construct is valid for a period equal to that of Improvement Permit – not to exceed sixty months.

Signed: * Ben John date 2/6/01

Improvement Permit by: Wesley Sparks RS. date 1/30/01

Authorization to Construct by: Wesley Sparks RS. date 1/30/01

Installed by: A1 Backhoe

Operation Permit by: [signature] date 6/15/01

Existing System Inspection by: date

HEALTH DEPT. COPY: WHITE OWNER COPY (FINAL): YELLOW OWNER COPY (INITIAL): PINK