IREDELL COUNTY HEALTH DEPARTMENT

STATESVILLE 704-878-5305 4665514727 MOORESVILLE 704-664-5281 4:00

IMPROVEMENT PERMIT / AUTHORIZATION TO CONSTRUCT / OPERATION PERMIT / EXISTING SYSTEM INSPECTION

PERMIT# 083585 PIN# DATE 10/4/99

OWNER OR CONTRACTOR Delbert Pennington PHONE: Business Home 875-1943

ADDRESS 307 Elenora Dr. Hyattsville, NC 28078

LOCATION Shearers Chapel Rd TC Timberview 1st lot on left (on corner of Shearers & Timberview)

SUBDIVISION Timber view BLOCK / SECTION ~~22~~ LOT 22 LOT AREA 1.0 Acre SITE CLASS. RS DESIGN FLOW 480 gpd L.T.A.R. .3 mD

Septic Tank: 1000 Gallons; STB 1012 Date 11-2-99

Pump Tank: Gallons; PT Date

Pump Make: Model Serial No.

Nitrification Field: No Fields 1 Square Feet 1200' Linear Feet 400'

No Lines 5 Trench Width 36" Max Trench Bottom Depth 36"

☒ New System ☐ Repair System Type: I II III IV V Conv.

System Description: Gravity - 25% Reduction

Repair System Description: Pump/Grav. - Modified

Maintenance Agreement Required: ☐ Yes ☒ No

Gravel Depth N/A ☐ Slab ☒ Crawl Space ☐ Basement w/plumbing ☐ Basement wo/plumbing

☒ House/Mod. Home No. Bedrooms ~~4~~ 3

☐ Mobile Home No. Bathrooms 2

☐ Business No. Employees

☐ Other


Water Supply: ☒ Individual ☐ Public ☐ Community

Comments/Conditions: Keep Septic System at least 10' from PL & 5' from House & 50-100' from any well.

Comments/Conditions: 1/6/2000 Owner changed home to 3 Bdrm instead of 4 Bedroom therefore 400' of Conventional Drainfield Okay (System is now Type II) mD


INITIAL SITE SKETCH

Scale 1:50

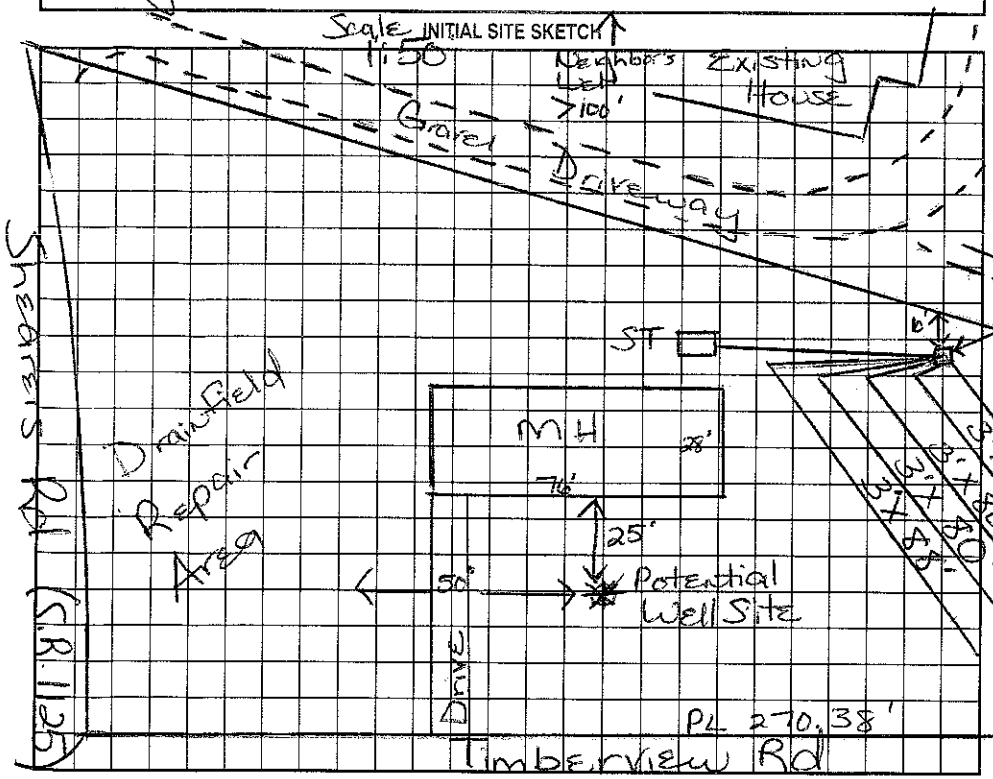

AS BUILT SKETCH

Scale = 1:50'

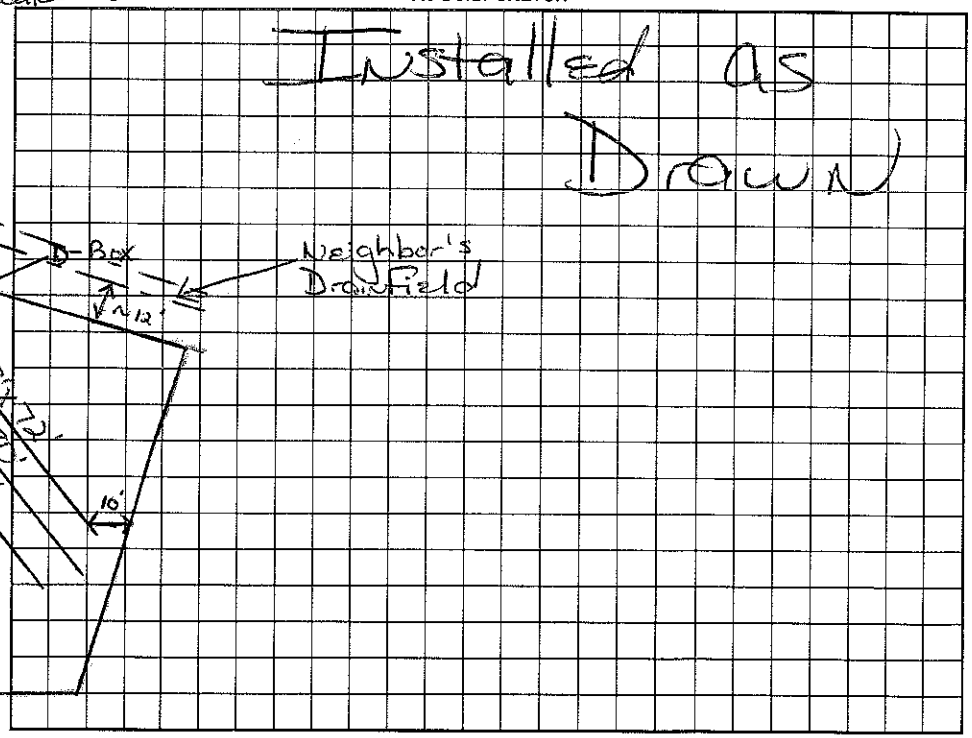

Permit can be suspended or revoked if any false information is supplied toward securing the permit/any unauthorized changes are made to the site/any unauthorized changes are made in the installation of the system. Improvement Permit with plat valid without expiration. Improvement Permit with site plan valid for sixty months. Authorization to Construct is valid for a period equal to that of Improvement Permit – not to exceed sixty months.

Signed: Delbert L. Pennington date 10/13/99

Improvement Permit by: Maria H. Dolan RS date 10/5/99

Authorization to Construct by: Maria H. Dolan RS date 10/5/99

Installed by: A-1 Backhoe

Operation Permit by: Maria H. Dolan RS date 2/23/2000

Existing System Inspection by: date

HEALTH DEPT. COPY: WHITE OWNER COPY (FINAL): YELLOW OWNER COPY (INITIAL): PINK