IREDELL COUNTY HEALTH DEPARTMENT

STATESVILLE 704-878-5305 MOORESVILLE 704-664-5281

IMPROVEMENT PERMIT / AUTHORIZATION TO CONSTRUCT / OPERATION PERMIT / EXISTING SYSTEM INSPECTION

PERMIT # PIN # 4665514829 DATE 7-17-2012

OWNER or APPLICANT Kale & Rebecca Kahne PHONE: ~~Business~~ 704838-6538 Home: 704836 6536

OWNER or APPLICANT ADDRESS 1473 Shearers Rd

LOCATION / DIRECTIONS Shearers Rd past Food Lion right Bd Timberview Ln

SUBDIVISION BLOCK / SECTION LOT # 9 LOT AREA ~1.33Ac DESIGN FLOW 480gpd L.T.A.R.

Septic Tank 1000 Gallons: STB 312 Date 3-6-12

Pump Tank Gallons: PT Date

Pump Make Model Serial #

Nitrification Field No Fields No Lines Linear Feet

Trench Width Max. Trench Bottom Depth Gravel Depth

☐ New System ☒ Repair ☐ Expansion System Type I II III IV V VI

System Description: ST Gravity Conventional

Repair System Description:

Maintenance Agreement Required ☐ YES ☒ NO

☐ GRAVITY ☐ PRESSURE

☒ Residence No. Bedrooms 4

☐ Business No. Persons

☐ Other No. Employees

☐ Slab ☐ Crawl Space


☐ Basement w/plumbing ☐ Basement w/o plumbing

Water Supply ☒ Private ☐ Public ☐ Community

Comments / Conditions: Installed new ST ~ 7-8 ft from House, 2 Drainfields @ House, 1 towards back & 1 washer towards front.

Comments / Conditions

INITIAL SITE SKETCH

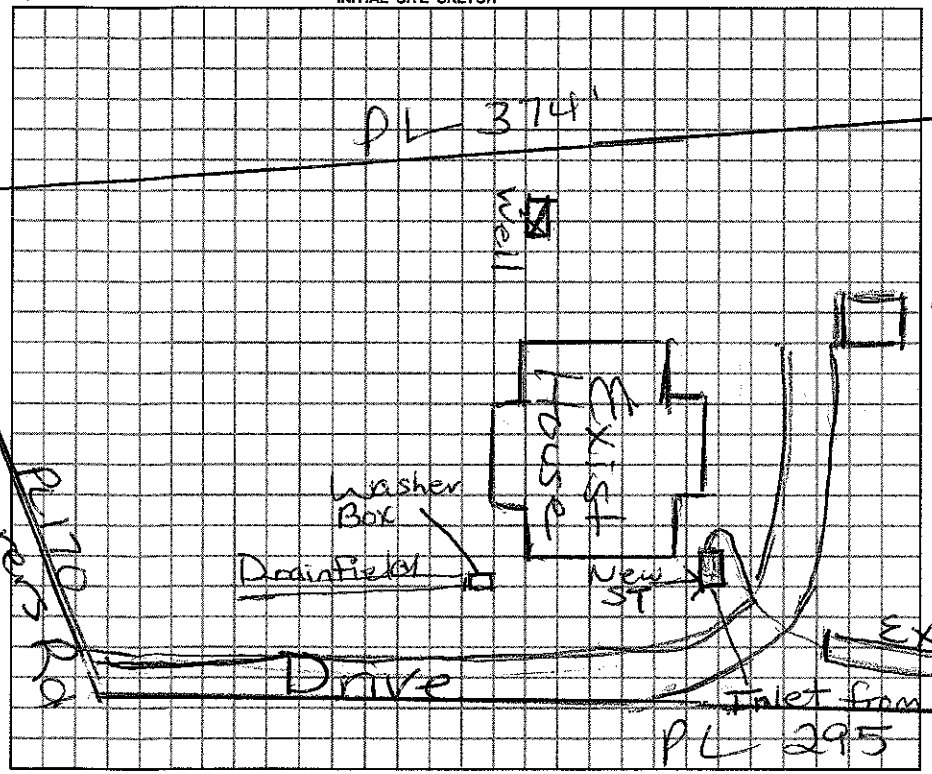

AS BUILT SKETCH

Permit can be suspended or revoked if any false information is supplied toward securing the permit / any unauthorized changes are made to the site / any unauthorized changes are made in the installation of the system.

☐ *IMPROVEMENT PERMIT w / plat valid without expiration.* ☒ *IMPROVEMENT PERMIT w / site plan valid for 60 mos.* ☐ *AUTHORIZATION TO CONSTRUCT valid for period equal to IMPROVEMENT PERMIT-not to exceed 60 mo.*

Owner / Applicant Signature: Date

Improvement Permit by: Maria Dolan RS Date 7/17/12

Authorization to Construct by: Maria Dolan RS Date 7/17/12

YOU SHOULD CONTACT A LOCATOR SERVICE PRIOR TO ANY EXCAVATION.

Installed by: T W Amamons

Operation Permit by: Maria Dolan Date: 7/17/12

Existing System Inspected by: Date:

WHITE COPY Environmental Health YELLOW COPY (Final) Owner / Applicant PINK COPY (Initial) Owner / Applicant