IREDELL COUNTY HEALTH DEPARTMENT

STATESVILLE 704-878-5305 MOORESVILLE 704-664-5281

IMPROVEMENT PERMIT / AUTHORIZATION TO CONSTRUCT / OPERATION PERMIT / EXISTING SYSTEM INSPECTION

PERMIT# 083388 PIN# 4665 52 3057 DATE 9/1/99

OWNER OR CONTRACTOR Brenda Alexander PHONE: Business Home 660-6705

ADDRESS 302 Dexter Ave. Mooresville, NC. 28115

LOCATION Shearers Rd. TL Springtime Lane (R) corner lot.

SUBDIVISION TIMBERVIEW BLOCK / SECTION LOT 23 LOT AREA 1.0 Ac SITE CLASS. PS DESIGN FLOW 360 L.T.A.R. .35

Septic Tank: 1000 Gallons; STB 1012 Date 11/20/99
Pump Tank: Gallons; PT Date
Pump Make: Model Serial No.
Nitrification Field: No Fields 1 Square Feet 1029 Linear Feet 342
No Lines 4@85'x3 Trench Width 36" Max Trench Bottom Depth 36" Gravel Depth 12"

[X] New System [ ] Repair System Type: I, (II) III, IV, V, VI
System Description: GRAV - CONVENTIONAL
Repair System Description: GRAV - HDS ORCHARD PLUS
Maintenance Agreement Required: [ ] Yes [X] No

[X] House/Mod. Home No. Bedrooms 3
[ ] Mobile Home No. Bathrooms 2
[ ] Business No. Employees
[ ] Other
[ ] Slab [X] Crawl Space [ ] Basement w/plumbing [ ] Basement wo/plumbing


Water Supply: [X] Individual [ ] Public [ ] Community

Comments:/Conditions:


Comments:/Conditions:

(1"=50')

INITIAL SITE SKETCH

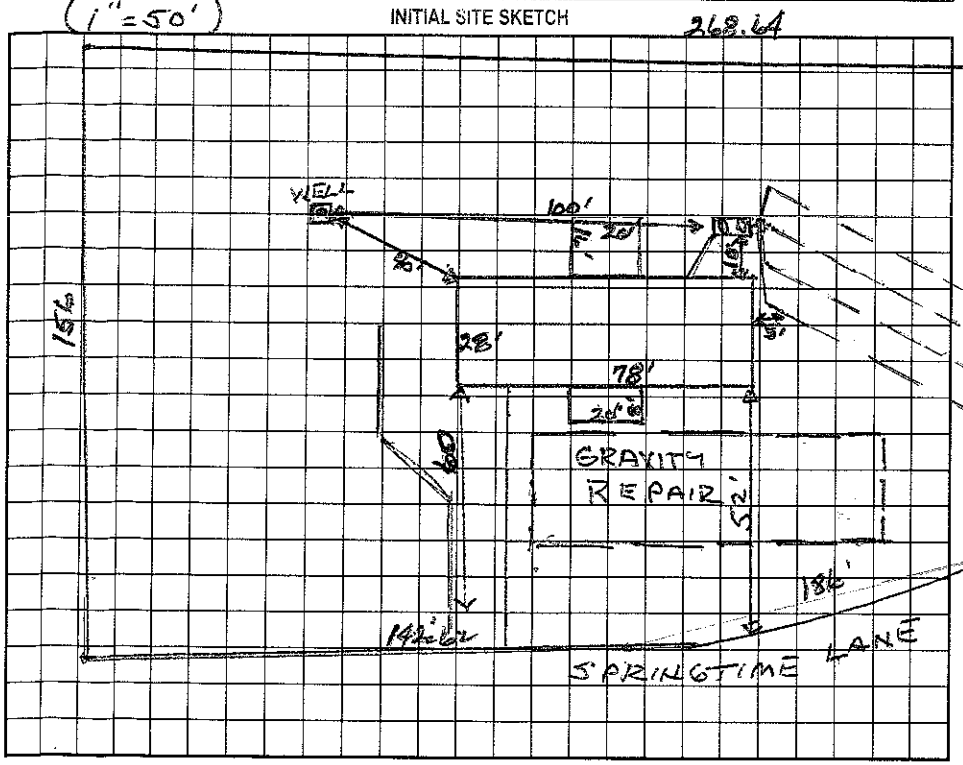

AS BUILT SKETCH

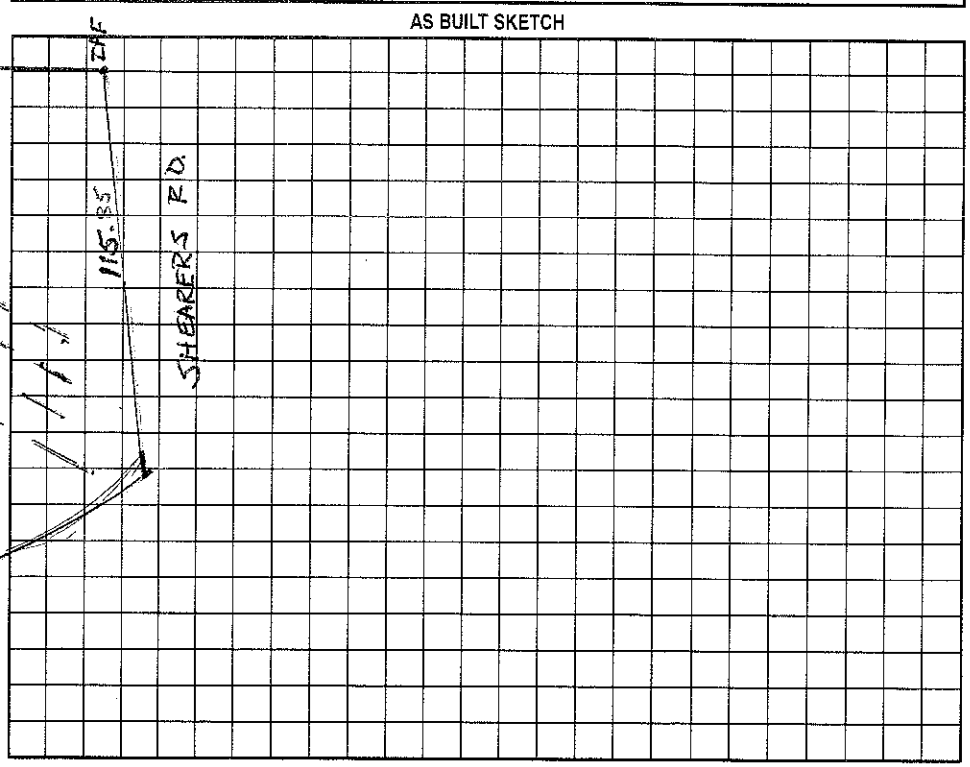

Permit can be suspended or revoked if any false information is supplied toward securing the permit/any unauthorized changes are made to the site/any unauthorized changes are made in the installation of the system. Improvement Permit with plat valid without expiration. Improvement Permit with site plan valid for sixty months. Authorization to Construct is valid for a period equal to that of Improvement Permit – not to exceed sixty months.

Signed: * Brenda Alexander date 9/7/99

Improvement Permit by: Wesley Sparks RS. date 9/1/99

Authorization to Construct by: Wesley Sparks RS. date 9/1/99

Installed by: A-1 Backhoe

Operation Permit by: Wesley Sparks RS. date 3/10/00

Existing System Inspection by: date

HEALTH DEPT. COPY: WHITE OWNER COPY (FINAL): YELLOW OWNER COPY (INITIAL): PINK