4665 53 0228

IREDELL COUNTY HEALTH DEPARTMENT

STATESVILLE 704-878-5305 MOORESVILLE 704-664-5281

IMPROVEMENT PERMIT / CERTIFICATE OF COMPLETION / OPERATION PERMIT / EXISTING SYSTEM INSPECTION

PROPERTY DESCRIPTION NO. 18295 DATE 4/19/94 TAX MAP NO. IEA 166 Watershed: ☒ Yes ☐ No

OWNER OR CONTRACTOR CHIFEN PARKER PHONE: Business _____ Home 664-4096

ADDRESS Shearers Rd. to 2nd house before church, blue house on (L) past Rocky River Rd.

LOCATION _____

SUBDIVISION N/A BLOCK / SECTION _____ LOT _____ LOT AREA ~1.3AC SITE CLASS. P DESIGN FLOW 240 L.T.A.R. _____

Septic Tank: 1000 Gallons; STB 825 Date 4/2/94

Pump Tank: _____ Gallons; PT _____ Date _____

Pump Make: _____ Model _____ Serial No. _____

Nitrification Field: No Fields 1 Square Feet 960 Linear Feet 320 Hwy

No Lines 5 Trench Width 3' Max Trench Bottom Depth 32" Gravel Depth 12"

☒ New System ☐ Repair System Type: I (II) III, IV, V, VI

System Description: CONV - DROP BOXES

Repair System Description: SAME

Maintenance Agreement Required: ☐ Yes ☒ No

☐ House/Mod. Home No. Bedrooms 2

☒ Mobile Home No. Bathrooms 2

☐ Business No. Employees ____

☐ Other _____


☐ Slab ☐ Crawl Space ☐ Basement w/plumbing ☐ Basement wo/plumbing

Water Supply:
☒ Individual
☐ Community
☐ Public
PARKERS

Comments: Keep trenches no deeper than 32" to trench bottom

Comments: Installed as drawn.

INITIAL SITE SKETCH

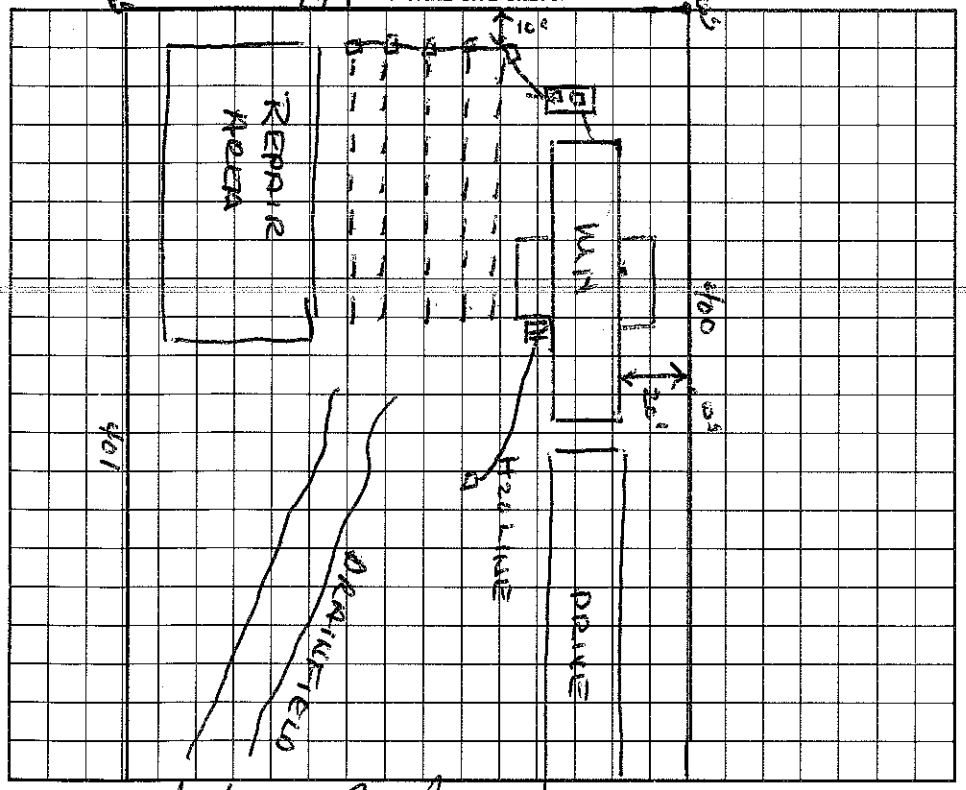

AS BUILT SKETCH

I understand that this permit can be suspended or revoked if any false information is supplied toward securing the permit/any unauthorized changes are made to the site/any unauthorized changes are made in the installation of the system. Improvement Permit is valid for 60 months from date of issuance.

Signed: _____

Improvement Permit by: Wesley Sparks R.S. date 4/19/94

Existing System Inspection by: _____ date _____

Installed by: Rowan Septic Tanks

Certificate of Completion by: Wesley Sparks R.S. date 5/25/94

Operation Permit by: _____ date _____

HEALTH DEPT. COPY: WHITE INSPECTION COPY (FINAL): GREEN OWNER COPY (FINAL): YELLOW INSPECTION COPY (INITIAL): PINK OWNER COPY (INITIAL): GOLD