IREDELL COUNTY HEALTH DEPARTMENT

STATESVILLE 704-878-5305 MOORESVILLE 704-664-5281

IMPROVEMENT PERMIT / CERTIFICATE OF COMPLETION / OPERATION PERMIT / EXISTING SYSTEM INSPECTION

PROPERTY DESCRIPTION NO. 20245 DATE 2/8/95 TAX MAP NO. 1E-4A 65 Watershed: ☐ Yes ☒ No

OWNER OR CONTRACTOR Robert Puskas PHONE: Business Home 664-4972

ADDRESS Millpond Ln. Mooresville, NC. 4066537270

LOCATION Millpond Ln. on D Lot 65

SUBDIVISION Timberview BLOCK / SECTION LOT 65 LOT AREA SITE CLASS. DESIGN FLOW L.T.A.R.

Septic Tank: ~~Equity~~ Gallons; ~~STB~~ Septech Date

Pump Tank: Gallons; ~~PT~~ Date

Pump Make: Model Serial No.

Nitrification Field: No Fields Square Feet Linear Feet

No Lines Trench Width Max Trench Bottom Depth Gravel Depth

☐ New System ☐ Repair System Type: I, (II), III, IV, V, VI

System Description: Existing System

Repair System Description:

Maintenance Agreement Required: ☐ Yes ☐ No

☒ ~~House/Mod. Home~~ No. Bedrooms 3

☐ Mobile Home No. Bathrooms 2

☐ Business No. Employees

☐ Other

☐ Slab ☐ Crawl Space ☐ Basement w/plumbing ☐ Basement wo/plumbing


Water Supply:
☒ ~~Individual~~
☐ Community
☐ Public

Comments:

Comments:

INITIAL SITE SKETCH

AS BUILT SKETCH

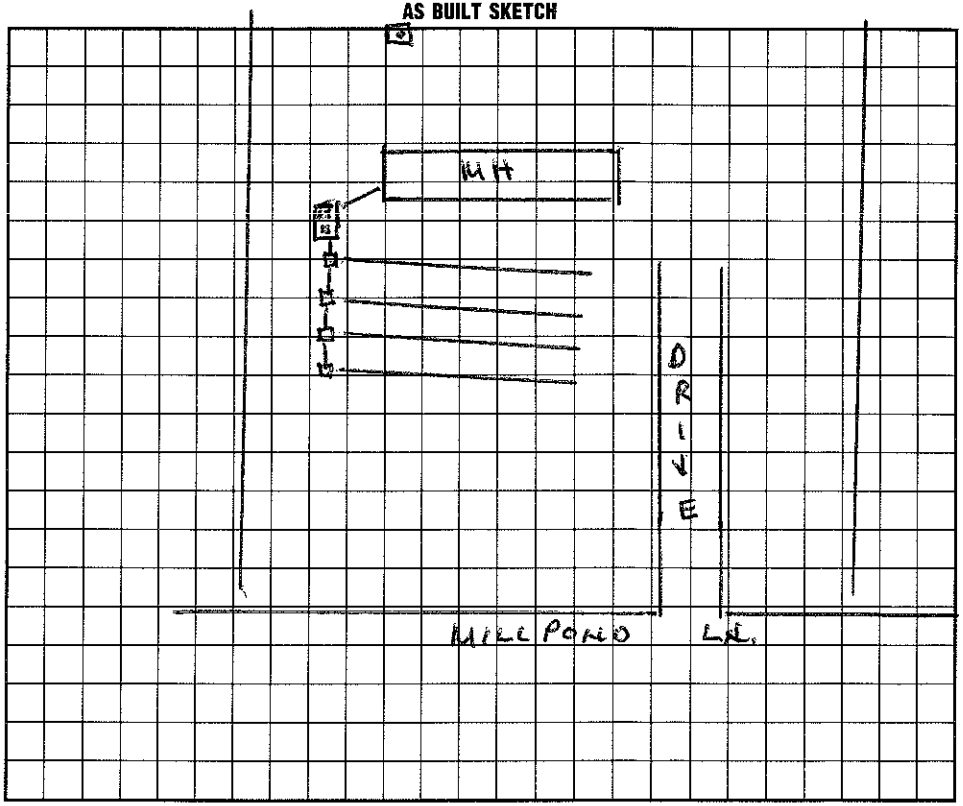

I understand that this permit can be suspended or revoked if any false information is supplied toward securing the permit/any unauthorized changes are made to the site/any unauthorized changes are made in the installation of the system. Improvement Permit is valid for 60 months from date of issuance.

Signed: Installed by:

Improvement Permit by: date Certificate of Completion by: date

Existing System Inspection by: Wesley Sparks RS. date 2/8/95 Operation Permit by: date

HEALTH DEPT. COPY: WHITE INSPECTION COPY (FINAL): GREEN OWNER COPY (FINAL): YELLOW INSPECTION COPY (INITIAL): PINK OWNER COPY (INITIAL): GOLD