2100-3100

IREDELL COUNTY HEALTH DEPARTMENT

STATESVILLE 704-878-5305 MOORESVILLE 704-664-5281

IMPROVEMENT PERMIT / AUTHORIZATION TO CONSTRUCT / OPERATION PERMIT / EXISTING SYSTEM INSPECTION

PERMIT# 086446 PIN# 4665611457 DATE 12/10/99

OWNER OR CONTRACTOR Michael (JOHN) Mode PHONE: Business 528-4516 Home 4062-6589

ADDRESS 153 Johnson Dairy Rd Mooresville, NC 28115

LOCATION Hwy 136 (Coddle Creek) TR Johnson Dairy 3 miles on left (3rd lot past Liberty Baptist Church)

SUBDIVISION Timberview BLOCK / SECTION LOT 3 LOT AREA .75 Acre SITE CLASS. PS DESIGN FLOW 360 gpd L.T.A.R. .3

Septic Tank: 1000 Gallons; STB 212 Date 12-13-99
Pump Tank: Gallons; PT Date
Pump Make: Model Serial No.
Nitrification Field: No Fields 1 Square Feet 900' Linear Feet 300'
No Lines 3 at 100' Trench Width 36" Max Trench Bottom Depth 36" Gravel Depth N/A

☒ New System ☐ Repair System Type: I, II, (III), IV, V, VI
System Description: Gravity - 25% Reduction
Repair System Description: Pumped - 25% Reduction
Maintenance Agreement Required: ☐ Yes ☒ No


☐ House/Mod. Home ☒ Mobile Home ☐ Business ☐ Other
No. Bedrooms 3 No. Bathrooms 2 No. Employees
☐ Slab ☒ Crawl Space ☐ Basement w/plumbing ☐ Basement wo/plumbing

Water Supply: ☒ Individual ☐ Public ☐ Community


Comments:/Conditions: Keep Septic System at least 10' from PL & out of Right-of-way, 50' from any well & =5' from House. Install lines on Contour

Comments:/Conditions:

INITIAL SITE SKETCH Scale 1:50'

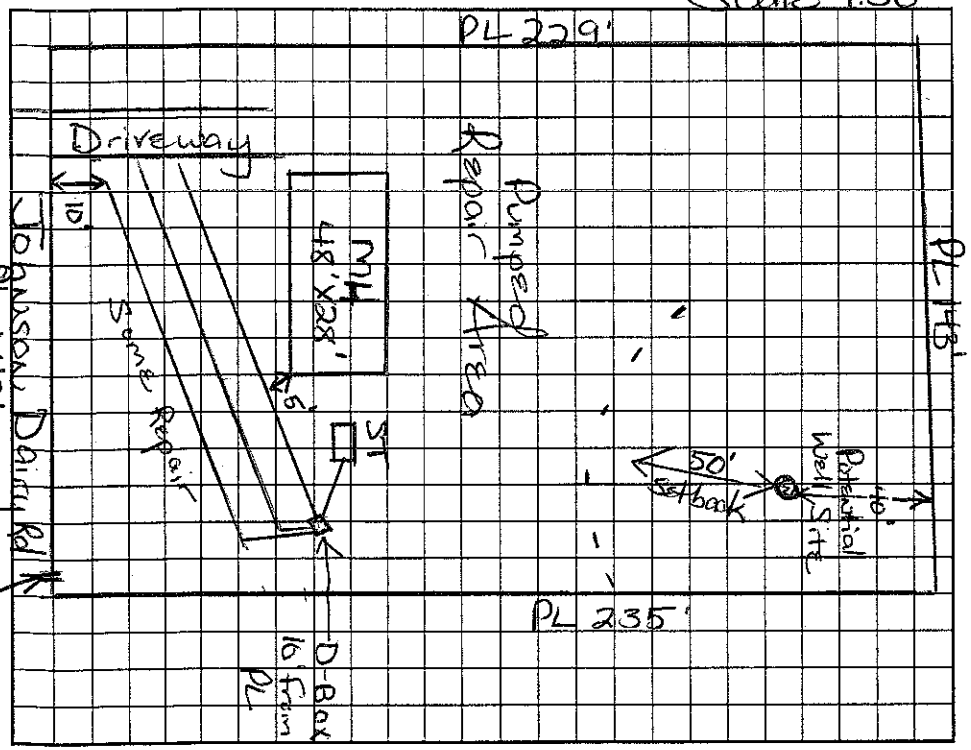

AS BUILT SKETCH

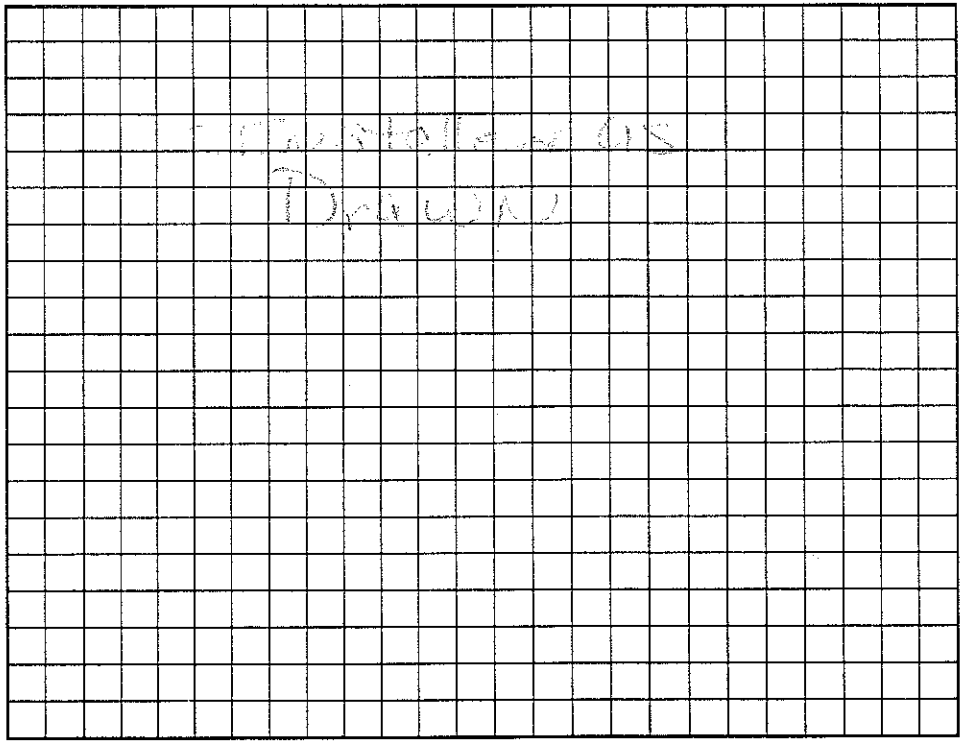

Permit can be suspended or revoked if any false information is supplied toward securing the permit/any unauthorized changes are made to the site/any unauthorized changes are made in the installation of the system. Improvement Permit with plat valid without expiration. Improvement Permit with site plan valid for sixty months. Authorization to Construct is valid for a period equal to that of Improvement Permit – not to exceed sixty months.

Signed: Crystal Nguyen date 1-10-00 Installed by: Madison Rhodes

Improvement Permit by: Maria H. Dotson RS date 12/10/99 Operation Permit by: Maria H. Dotson R.S. date 1/27/2000

Authorization to Construct by: Maria H. Dotson RS date 12/10/99 Existing System Inspection by: date

HEALTH DEPT. COPY: WHITE OWNER COPY (FINAL): YELLOW OWNER COPY (INITIAL): PINK