IREDELL COUNTY HEALTH DEPARTMENT

STATESVILLE 704-878-5305 MOORESVILLE 704-664-5281

IMPROVEMENT PERMIT / AUTHORIZATION TO CONSTRUCT / OPERATION PERMIT / EXISTING SYSTEM INSPECTION

PERMIT# 139945 PIN# 4665 61 4925 DATE 5/6/06

OWNER OR APPLICANT Jonathan Autzenhaym PHONE: Business _____ Home 704-799-1124

ADDRESS 131 Timberview Ln. Mooresville, NC. 28115

LOCATION Shearer Rd. TL Timberview, on (L) off Culde sac

SUBDIVISION Timberview BLOCK / SECTION _____ LOT 17 LOT AREA ~ 1.15AC SITE CLASS. PS DESIGN FLOW 360 L.T.A.R. _____

Septic Tank: EXISTING Gallons: STB _____ Date _____

Pump Tank: _____ Gallons: PT _____ Date _____

Pump Make: _____ Model _____ Serial No. _____

Nitrification Field: No Fields ___ Square Feet _____ Linear Feet _____

No Lines _____ Trench Width EXISTING Max Trench Bottom Depth _____ Gravel Depth _____

☐ New System ☐ Repair ☐ Expansion System Type: I (II) III IV V VI

System Description: EXISTING

Repair System Description: SYSTEM

Maintenance Agreement Required: ☐ Yes ☒ No

☐ House/Mod. Home No. Bedrooms ___

☒ Mobile Home No. Persons 3

☐ Business No. Employees ___

☒ Other AUX. GARAGE

Water Supply: ☒ Individual ☐ Public ☐ Community


☒ Gravity ☐ Pressure ☐ Slab ☐ Crawl Space ☐ Basement w/plumbing ☐ Basement wo/plumbing

Comments:/Conditions:

Comments:/Conditions:

INITIAL SITE SKETCH

AS BUILT SKETCH

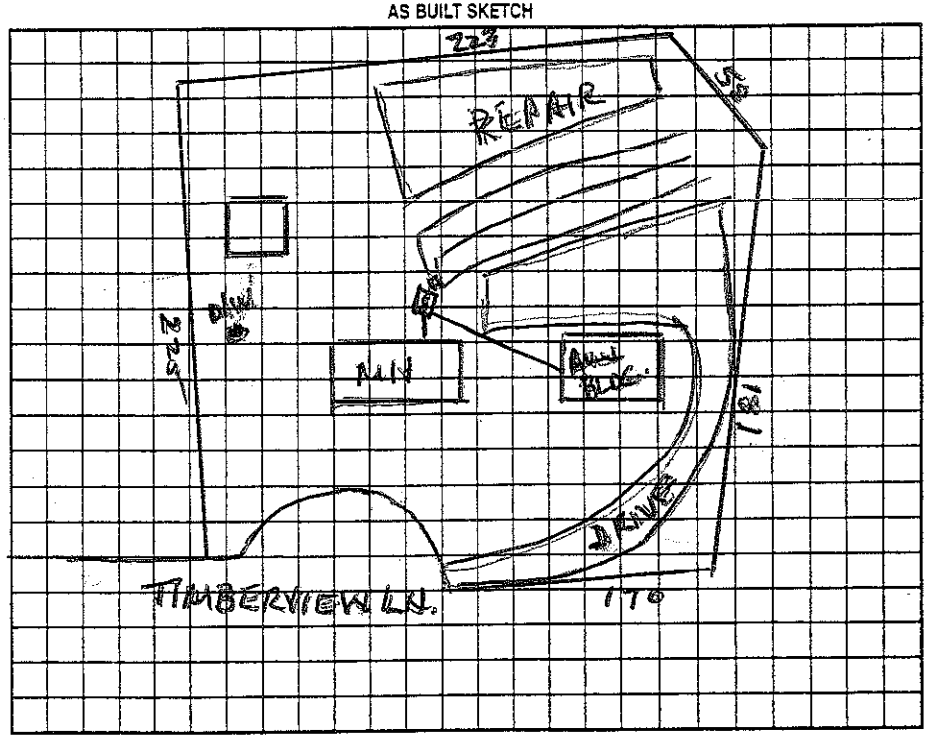

Permit can be suspended or revoked if any false information is supplied toward securing the permit/any unauthorized changes are made to the site/any unauthorized changes are made in the installation of the system. Improvement Permit with plat valid without expiration ☐ Improvement Permit with site plan valid for sixty months ☐ Authorization to Construct is valid for a period equal to that of Improvement Permit – not to exceed sixty months.

Signed: Jonathan Autzenhaym date 5/12/06

Improvement Permit by: _____ date _____

Authorization to Construct by: _____ date _____

Installed by: _____

Operation Permit by: _____ date _____

Existing System Inspection by: Wesley Sparks RS. date 5/6/06

HEALTH DEPT. COPY: WHITE OWNER COPY (FINAL): YELLOW OWNER COPY (INITIAL): PINK