IREDELL COUNTY HEALTH DEPARTMENT

STATESVILLE 704-878-5305 MOORESVILLE 704-664-5281

IMPROVEMENT PERMIT / AUTHORIZATION TO CONSTRUCT / OPERATION PERMIT / EXISTING SYSTEM INSPECTION

PERMIT# 109264 PIN# 4665620124 DATE 10/25/2002

OWNER OR CONTRACTOR Fleetwood Homes / Tim Ward PHONE: Business 363-6964 Home

ADDRESS 1040 Charlotte Hwy Troutman, NC 28166

LOCATION Hwy 115 S TR Timberland TR Shearers TC Springtime Ln #140

SUBDIVISION Timberview BLOCK / SECTION LOT 27 LOT AREA SITE CLASS. PS DESIGN FLOW 360gpd L.T.A.R.

Septic Tank: Existing Gallons: STB Date

Pump Tank: Existing Gallons: PT Date

Pump Make: Model Serial No.

Nitrification Field: No Fields Square Feet Linear Feet

No Lines Trench Width Existing Max Trench Bottom Depth Gravel Depth

☐ New System ☐ Repair System Type: I, II, III, IV, V, VI

System Description: Existing Gravity Conventional

Repair System Description: Modified

Maintenance Agreement Required: ☐ Yes ☒ No

☐ House/Mod. Home No. Bedrooms 3

☒ Mobile Home No. Bathrooms 2

☐ Business No. Employees

☐ Other


☐ Slab ☒ Crawl Space ☐ Basement w/plumbing ☐ Basement wo/plumbing

Water Supply:
☐ Individual
☐ Public
☐ Community

Comments/Conditions: Existing Septic System appears to be functioning okay at time of inspection, No problems noticed

Comments/Conditions: Replacing 3 Bedroom SW with 3 Bedroom D.W.

INITIAL SITE SKETCH ☆ Not to Scale

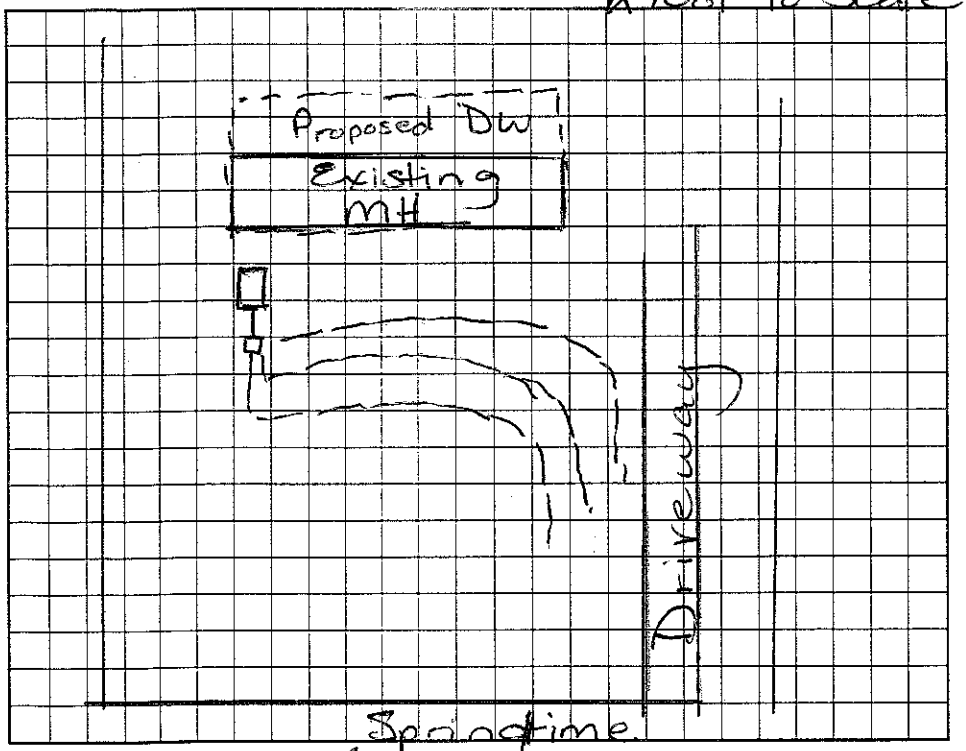

AS BUILT SKETCH

Septic System originally installed in 1984 under Mike Riddle.

Permit can be suspended or revoked if any false information is supplied toward securing the permit/any unauthorized changes are made to the site/any unauthorized changes are made in the installation of the system. Improvement Permit with plat valid without expiration. Improvement Permit with site plan valid for sixty months. Authorization to Construct is valid for a period equal to that of Improvement Permit – not to exceed sixty months.

Signed: Teresa Fleetwood date 10-25-02 Installed by:

Improvement Permit by: Maria H. Dotson R.S date 10/25/02 Operation Permit by: date

Authorization to Construct by: date Existing System Inspection by: Maria H. Dotson R.S date 10/25/02

HEALTH DEPT. COPY: WHITE OWNER COPY (FINAL): YELLOW OWNER COPY (INITIAL): PINK