4606562 3547

IREDELL COUNTY HEALTH DEPARTMENT

STATESVILLE 704-878-5305 MOORESVILLE 704-664-5281

IMPROVEMENT PERMIT / CERTIFICATE OF COMPLETION / OPERATION PERMIT / EXISTING SYSTEM INSPECTION

PROPERTY DESCRIPTION NO. 18780 DATE 7/22/94 TAX MAP NO. 1E-4-A-41 Watershed: ☐ Yes ☒ No

OWNER OR CONTRACTOR Cora Prowker PHONE: Business _____ Home 663-5900

ADDRESS Rt 5 Box 487 Mooresville, NC. 28115

LOCATION Sprintview Ln. - Shearers Rd. Turn on Sprintview Ln. straight to #41 on (L) before curve

SUBDIVISION Timberview BLOCK / SECTION _____ LOT 41 LOT AREA 1.24 AC SITE CLASS. P DESIGN FLOW 240 L.T.A.R. .12-.25

Septic Tank: 1000 Gallons; STB 1012 Date 5/29/94

Pump Tank: _____ Gallons; PT _____ Date _____

Pump Make: _____ Model _____ Serial No. _____

Nitrification Field: No Fields 1 Square Feet 1200 Linear Feet 400

No Lines 4@75 Trench Width 36" Max Trench Bottom Depth 36" Gravel Depth 12"

☒ New System ☐ Repair System Type: I, (II) III, IV, V, VI

System Description: DROP BOX CONVENTIONAL

Repair System Description: _____

Maintenance Agreement Required: ☐ Yes ☒ No

☐ House/Mod. Home No. Bedrooms 2

☒ Mobile Home No. Bathrooms 2

☐ Business No. Employees _____

☐ Other _____


☐ Slab ☐ Crawl Space ☐ Basement w/plumbing ☐ Basement wo/plumbing

Water Supply: ☒ Individual ☐ Community ☐ Public PROPOSED

Comments: Lines on slope contour in direction shown here.

Comments: Installed as shown on App. Permit

INITIAL SITE SKETCH

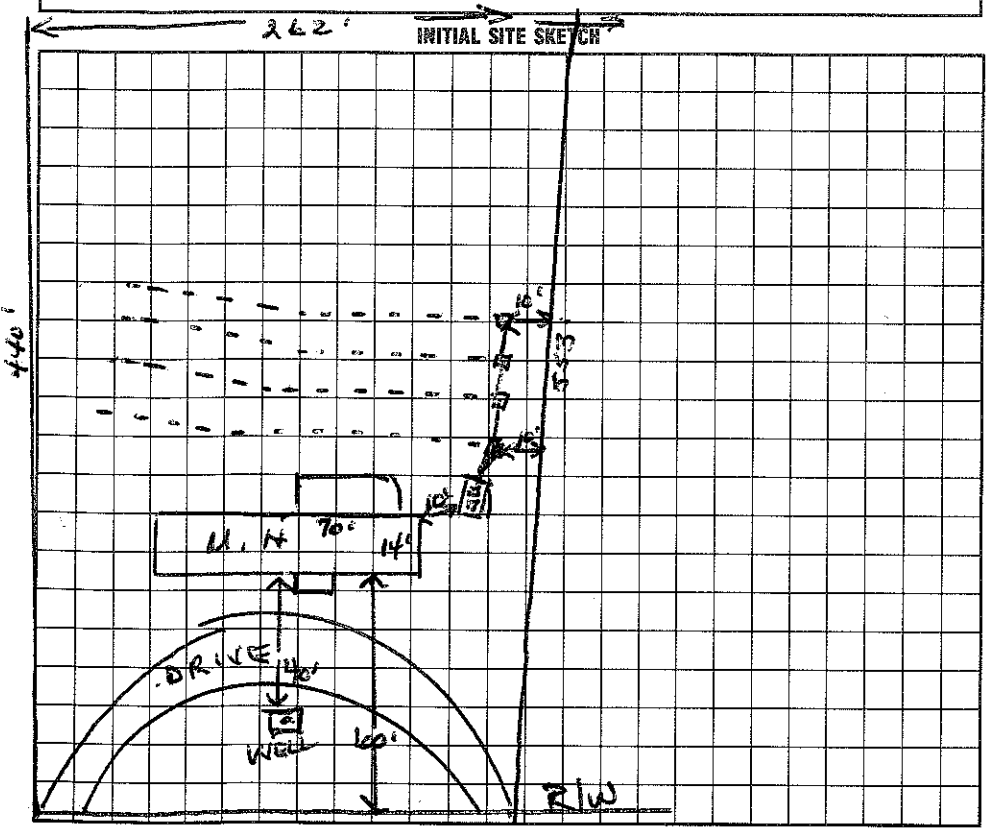

AS BUILT SKETCH

I understand that this permit can be suspended or revoked if any false information is supplied toward securing the permit/any unauthorized changes are made to the site/any unauthorized changes are made in the installation of the system. Improvement Permit is valid for 60 months from date of issuance.

Signed: X Alexander Prowker

Improvement Permit by: Wesley Sparks RS. date 7/22/94

Existing System Inspection by: _____ date _____

Installed by: Donald Lackey

Certificate of Completion by: Wesley Sparks RS date 11/15/94

Operation Permit by: _____ date _____

HEALTH DEPT. COPY: WHITE INSPECTION COPY (FINAL): GREEN OWNER COPY (FINAL): YELLOW INSPECTION COPY (INITIAL): PINK OWNER COPY (INITIAL): GOLD