IREDELL COUNTY HEALTH DEPARTMENT

STATESV...704-878-5305 MOORESVILLE 704-664-5281

IMPROVEMENT PERMIT / AUTHORIZATION TO CONSTRUCT / OPERATION PERMIT / EXISTING SYSTEM INSPECTION

PERMIT# 11941 PIN# 4665-62-8283 DATE 4/26/04

OWNER OR CONTRACTOR Sharon Weber PHONE: Business Home 704-528-7576

ADDRESS 117 Buffalo Way Rd Statesville NC 28677

LOCATION Shearers, TL Springfield, Near End on Rt

SUBDIVISION Timberview BLOCK / SECTION LOT 33 LOT AREA 1.305AC SITE CLASS. PS DESIGN FLOW 360 L.T.A.R. 0.3

Septic Tank: 1000 Gallons; STB 1090 Date 2-9-04

Pump Tank: Gallons; PT Date

Pump Make: Model Serial No.

Nitrification Field: No Fields 1 Square Feet 1200 Linear Feet 400'

No Lines 6@67' Trench Width 36" Max Trench Bottom Depth 36" Gravel Depth 12"

☒ New System ☐ Repair System Type: I, (II), III, IV, V, VI

System Description: Gravity Conventional

Repair System Description: Pump Conventional

Maintenance Agreement Required: ☐ Yes ☒ No

☐ House/Mod. Home ☒ Mobile Home ☐ Business ☐ Other

No. Bedrooms 3 No. Bathrooms 2½ No. Employees


☐ Slab ☒ Crawl Space ☐ Basement w/plumbing ☐ Basement wo/plumbing

Water Supply: ☒ Individual ☐ Public ☐ Community


Comments:/Conditions: House set 140' from R/W of the Road
Drain field minimum 50' from any well

Comments:/Conditions:
~~Red Poly Tank~~ installed
Quick 4's " "

INITIAL SITE SKETCH 1"=50'

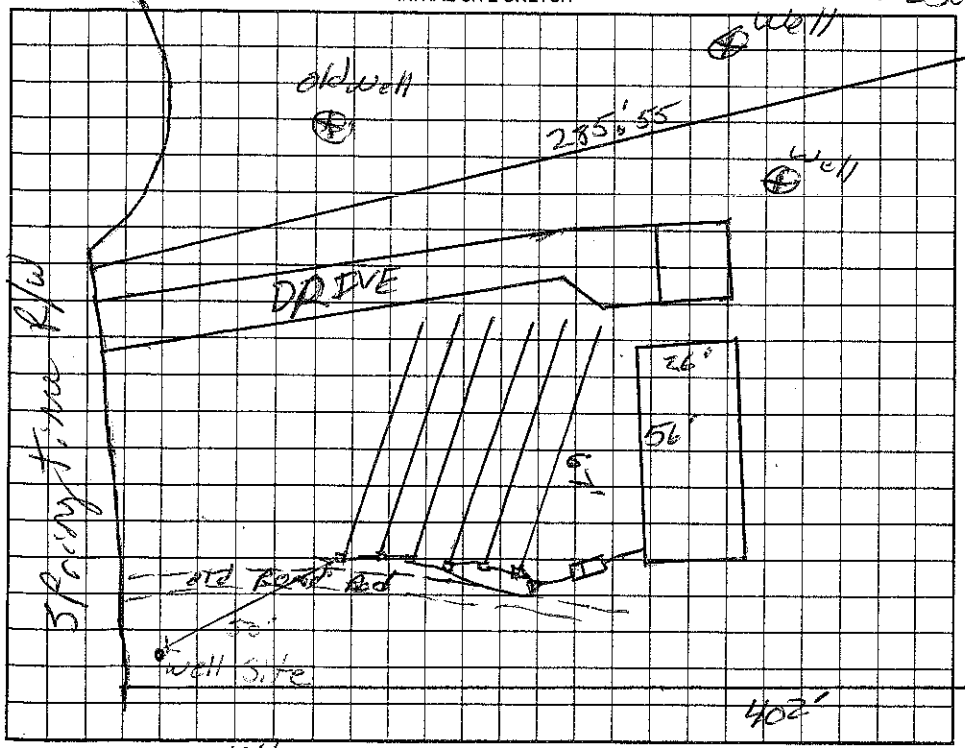

AS BUILT SKETCH

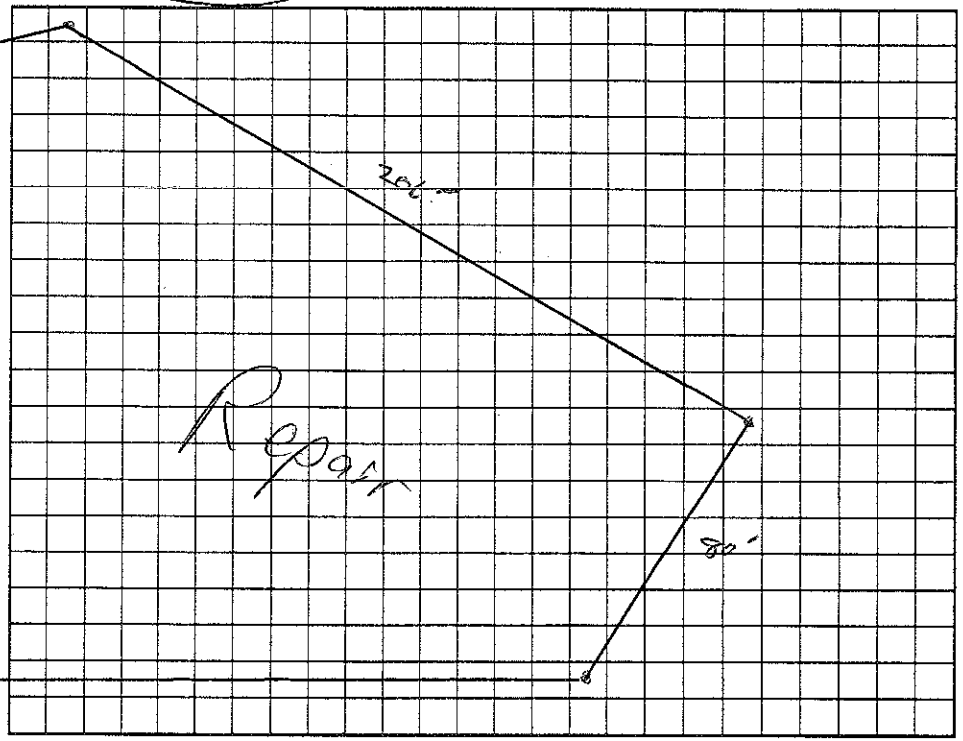

Permit can be suspended or revoked if any false information is supplied toward securing the permit/any unauthorized changes are made to the site/any unauthorized changes are made in the installation of the system. Improvement Permit with plat valid without expiration. Improvement Permit with site plan valid for sixty months. Authorization to Construct is valid for a period equal to that of Improvement Permit – not to exceed sixty months.

Signed: Sharon Weber date 4-29-04 Installed by: Hbees, Gradine

Improvement Permit by: RS date 4/26/04 Operation Permit by: date 5-29-07

Authorization to Construct by: RS date 4/26/04 Existing System Inspection by: date

HEALTH DEPT. COPY: WHITE OWNER COPY (FINAL): YELLOW OWNER COPY (INITIAL): PINK