IREDELL COUNTY HEALTH DEPARTMENT

Statesville Office (704) 878-5305 RA Mooresville Office (704) 660-3625 PERMIT # 211824

IMPROVEMENT PERMIT / AUTHORIZATION TO CONSTRUCT / OPERATION PERMIT / EXISTING SYSTEM

PIN # 4665-62-9849.000

APPLICANT: Clayton Homes APPLICANT ADDRESS: 1230 Conover Blvd.

SITE ADDRESS: 197 Springtime Ln. Mooresville NC PHONE: 828-217-3168 ALT. PHONE: 828-465-3450

SITE DIRECTIONS: Shearers Rd. South, TL Springtime, Site @ End.

SUBDIVISION: Timberview SECTION: 2 LOT # 36 A LOT AREA: 1.460 Acre DESIGN FLOW: 360 GPD. L.T.A.R.: .275

Septic Tank Existing (gal) STB Date
Pump Tank (gal) PT Date
Pump Make Model Serial #
Nitrification Fields 1 # Lines 1 Linear Ft: 14'
Trench Width 36" Max. Trench Bottom Depth * 24" * Gravel Depth N/A

☐ New System ☐ Repair ☐ Expansion System Type: I II ☒ III IV V VI
System Description: Conventional + 25% Reduction - Grav.
Repair System Description: 25% Reduction
Maintenance Agreement Required: ☐ YES ☒ NO
☒ GRAVITY ☐ PRESSURE

☒ Residence ☐ Business ☐ Other ☐ Slab ☐ Basement w/plumbing
No. Bedrooms 3 No. Persons 6 No. Employees ☒ Crawl Space


Water Supply: ☒ Private ☐ Public ☐ Community

☐ Basement w/o plumbing

Comments / Conditions: Remove 10' of First Existing Line to Make 50' Separation From Existing Well And 5' Seperation From Proposed Structure (New Mobile Home To Replace Existing Mobile Home In Same Location).

Check Distribution And Hook onto Lowest Line At End And Solid Pipe To 100' From Well. Add 14' of 25% Reduction.

INITIAL SITE SKETCH

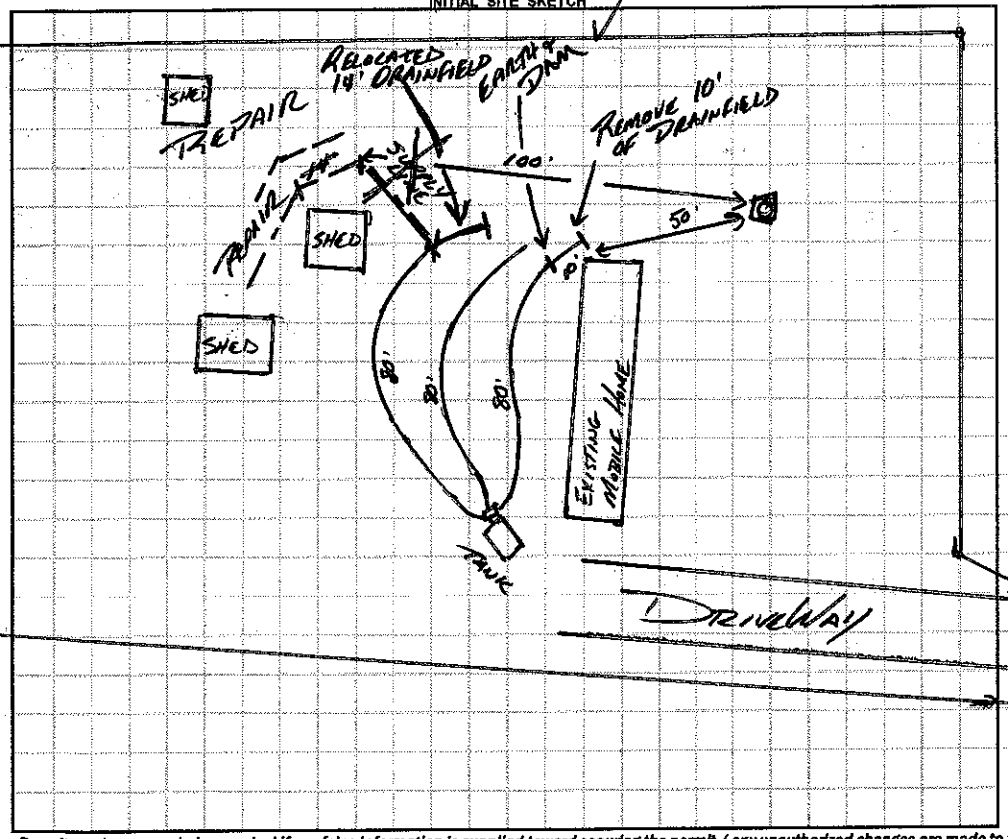

AS BUILT SKETCH

* Call ICHD Before Installing 704-664-3703

Looked @ 1st Day of Install. Saprolite @ 36" And Deeper. Was Able To Add 14' of Drainfield @ End of Line 3 @ 22" Trench Bottom. 7/29/15 JC

Speed Levelers Set To Feed Top 2 Lines First Drainfield Level But Initial Install Not On Contour.

Permit can be suspended or revoked if any false information is supplied toward securing the permit / any unauthorized changes are made to the site / any unauthorized changes are made in the installation of the system. **CONTACT A LOCATOR SERVICE PRIOR TO ANY EXCAVATION**

☐ **IMPROVEMENT PERMIT** *with plat valid without expiration.* ☒ **IMPROVEMENT PERMIT** *with site plan valid for 60 mos.* ☒ **AUTHORIZATION TO CONSTRUCT** *valid for period equal to IMPROVEMENT PERMIT--not to exceed 60 mo.*

Owner / Applicant Signature: [signature] Date: 7/29/15 Installed by: Al Backhoe

IMPROVEMENT PERMIT by: [signature] APPROVED Date: JUL 16 2015 OPERATION PERMIT by: [signature] APPROVED JUL 30 2015

AUTHORIZATION TO CONSTRUCT by: [signature] APPROVED Date: JUL 16 2015 Existing System Inspected by: Date:

Health Dept. Copy - WHITE Applicant (Final Approval) - YELLOW Applicant (Conditional Approval) - PINK