IREDELL COUNTY HEALTH DEPARTMENT

STATESVILLE 704-878-5305 MOORESVILLE 704-664-5281

IMPROVEMENT PERMIT / AUTHORIZATION TO CONSTRUCT / OPERATION PERMIT / EXISTING SYSTEM INSPECTION

PERMIT # 159015 PIN # 4665-63-0278 DATE 12-3-09

OWNER or APPLICANT LURA BARTLETT PHONE: Business 704-664-4051 Home:

OWNER or APPLICANT ADDRESS 165 MILL POND LN MOORESVILLE NC 28115

LOCATION / DIRECTIONS SHEARERS, TL SPRINGTIME, TL MILL POND, 165

SUBDIVISION TIMBERVIEW BLOCK / SECTION LOT # 62 & 63 LOT AREA DESIGN FLOW 240 GPD L.T.A.R. .3

Septic Tank 1000 EXT Gallons: STB Date

Pump Tank Gallons: P T Date

Pump Make Model Serial #

Nitrification Field No Fields No Lines Linear Feet

Trench Width Max. Trench Bottom Depth Gravel Depth

☐ New System ☐ Repair ☐ Expansion System Type I II III IV V VI

System Description: GRAVITY - GRAVEL

Repair System Description: SAME

Maintenance Agreement Required ☐ YES ☒ NO

☒ GRAVITY ☐ PRESSURE

☒ Residence No. Bedrooms 2

☐ Business No. Persons 2

☐ Other No. Employees

☐ Slab ☒ Crawl Space

☐ Basement w/plumbing ☐ Basement w/o plumbing


Water Supply: ☒ Private ☐ Public ☐ Community

Comments / Conditions


LOT 62 & 63 ARE NOW ONE LOT

Comments / Conditions 1) NEW HOME IS NOT TO BE PLACED W/IN 5' OF SEPTIC TANK 2) SYSTEM GOOD FOR 2 BED ROOMS

INITIAL SITE SKETCH

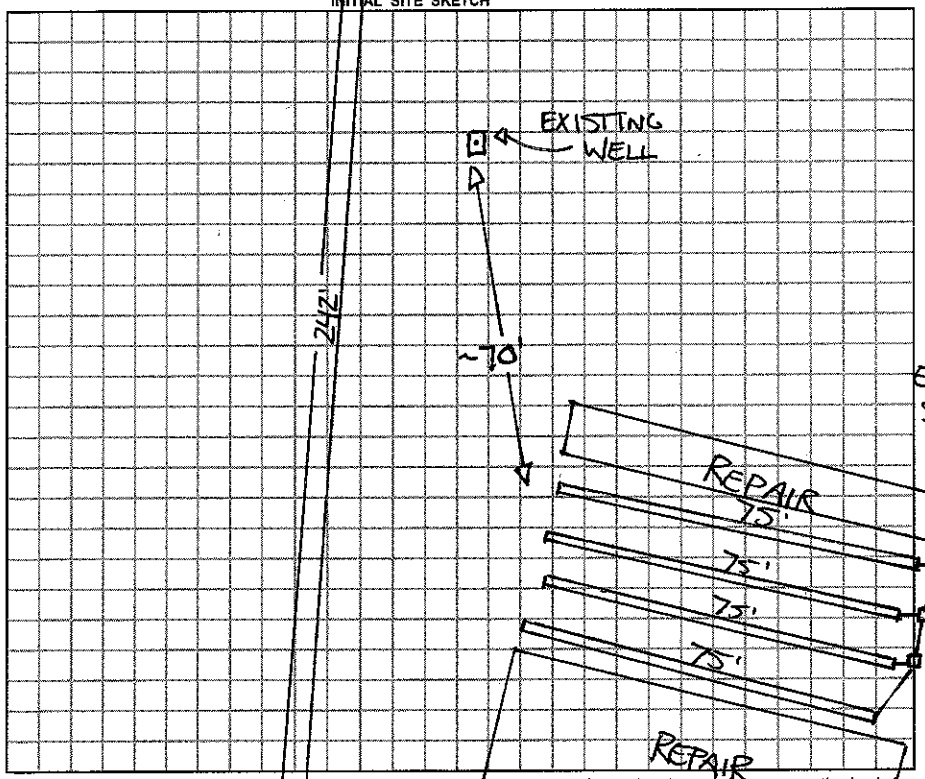

AS-BUILT SKETCH

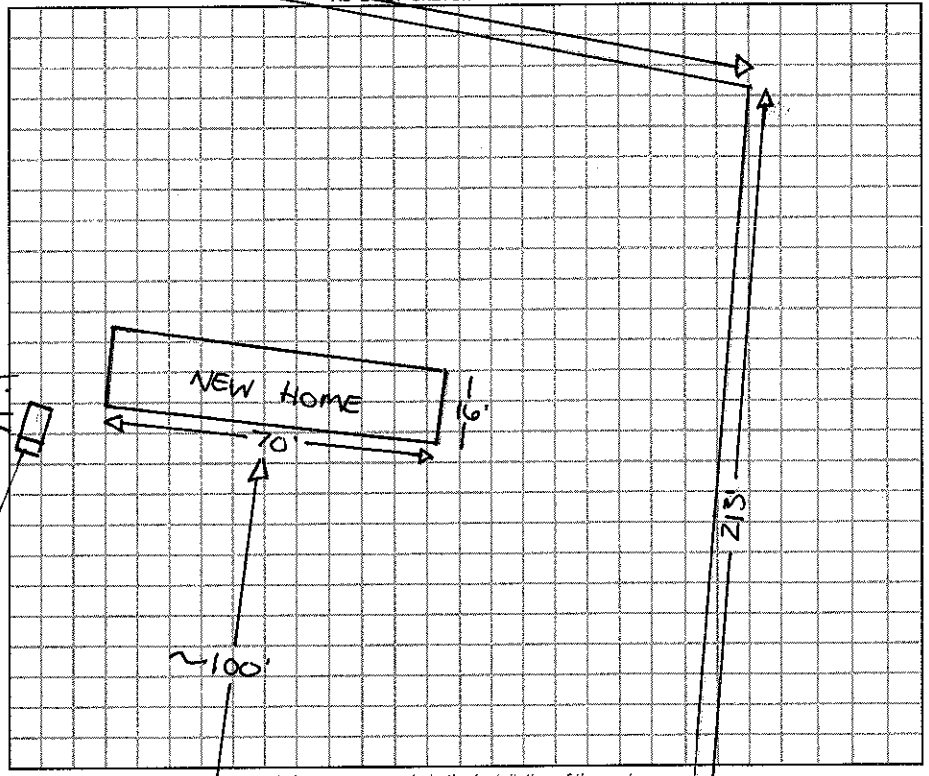

Permit can be suspended or revoked if any false information is supplied toward securing the permit / any unauthorized changes are made to the site / any unauthorized changes are made in the installation of the system.

☐ *IMPROVEMENT PERMIT w / site plan valid without expiration.* ☐ *IMPROVEMENT PERMIT w / site plan valid for 60 mos.* ☐ *AUTHORIZATION TO CONSTRUCT valid for period equal to IMPROVEMENT PERMIT-not to exceed 60 mo.*

Owner / Applicant Signature: Date 12-10-09 Installed by:

Improvement Permit by: Date Operation Permit by: Date:

Authorization to Construct by: Date Existing System Inspected by: JA REHS Date: 12-3-09

YOU SHOULD CONTACT A LOCATOR SERVICE PRIOR TO ANY EXCAVATION.

WHITE COPY Environmental Health YELLOW COPY (Final) Owner / Applicant PINK COPY (Initial) Owner / Applicant