IREDELL COUNTY HEALTH DEPARTMENT

STATESVILLE 704-878-5305 MOORESVILLE 704-664-5281

IMPROVEMENT PERMIT / AUTHORIZATION TO CONSTRUCT / OPERATION PERMIT / EXISTING SYSTEM INSPECTION

PERMIT# 152904 PIN# 4665-63-7137 DATE 10-9-08

OWNER OR APPLICANT Robert Berry PHONE: Business 704-746-4778 Home Eric Ward

ADDRESS 192 Mills Pond Ln Mooresville

LOCATION Same

SUBDIVISION Timberview BLOCK / SECTION 3rd LOT 56 LOT AREA 1.027 Ac SITE CLASS PS DESIGN FLOW 360 L.T.A.R. .5

Septic Tank: 1050 EX Gallons: STB ____ Date ____

Pump Tank: ____ Gallons: PT ____ Date ____

Pump Make: ____ Model ____ Serial No. ____

Nitrification Field: No Fields 1 Square Feet 720' Linear Feet 240'

No Lines 3@80 Trench Width 36" Max Trench Bottom Depth 36" Gravel Depth ____

☐ New System ☐ Repair ☐ Expansion System Type: I (II) III IV V VI

System Description: Gravity Conventional

Repair System Description: Same

Maintenance Agreement Required: ☐ Yes ☒ No

☐ House/Mod. Home No. Bedrooms 3

☒ Mobile Home No. Persons ____

☐ Business No. Employees ____

☐ Other ____


Water Supply: ☒ Individual ☐ Public ☐ Community

☒ Gravity ☐ Pressure ☐ Slab ☒ Crawl Space ☐ Basement w/plumbing ☐ Basement wo/plumbing


Comments:/Conditions: 1) System good for 3 BR house 2) House must be ≥ 85' from front prop line to stay off tank

Comments:/Conditions:

INITIAL SITE SKETCH

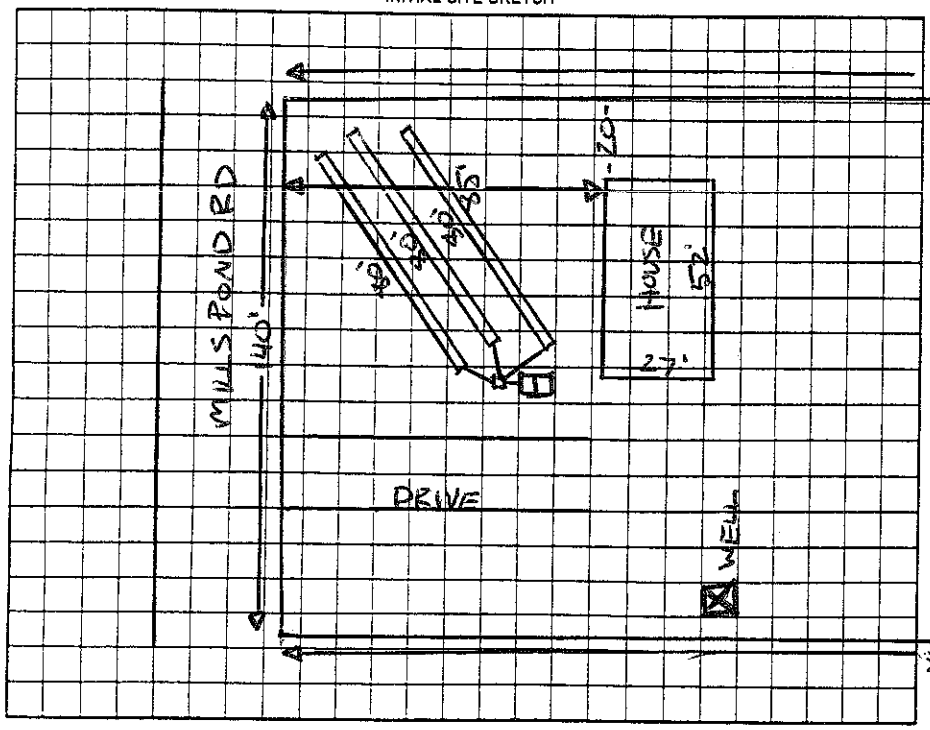

AS BUILT SKETCH

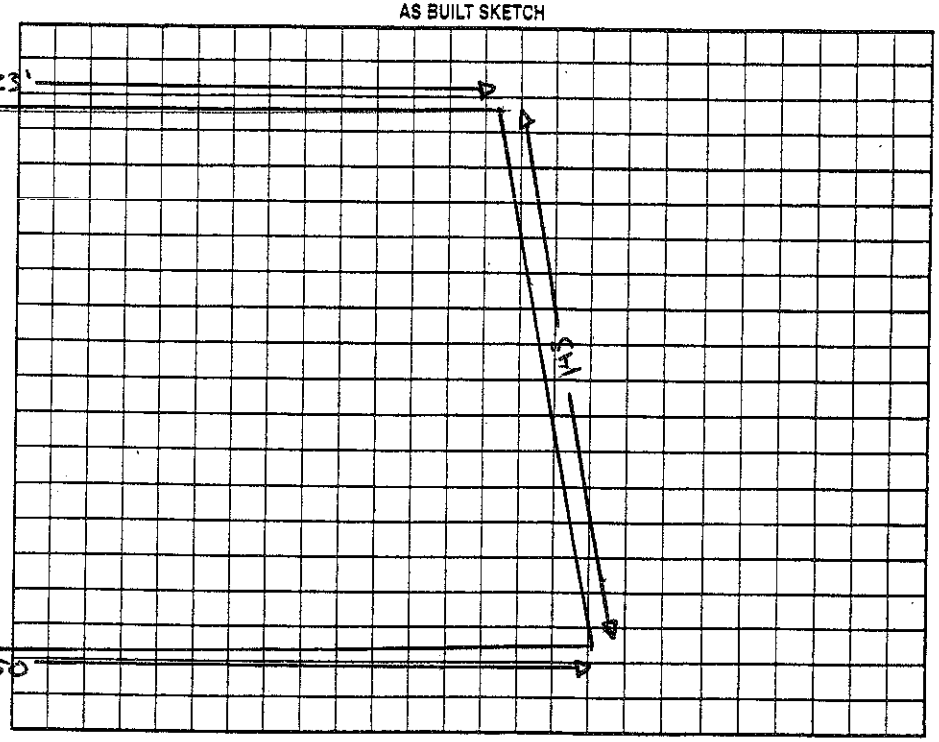

Permit can be suspended or revoked if any false information is supplied toward securing the permit/any unauthorized changes are made to the site/any unauthorized changes are made in the installation of the system. Improvement Permit with plat valid without expiration ☐ Improvement Permit with site plan valid for sixty months ☐ Authorization to Construct is valid for a period equal to that of Improvement Permit – not to exceed sixty months.

Signed: ____ date 10-10-08 Installed by: ____

Improvement Permit by: ____ date ____ Operation Permit by: ____ date ____

Authorization to Construct by: ____ date ____ Existing System Inspection by: ____ date 10-9-08

HEALTH DEPT. COPY: WHITE OWNER COPY (FINAL): YELLOW OWNER COPY (INITIAL): PINK